


Company / customer	
Project description	Deep Hole Machin (DHD)
Job number	ELEC-007
Commission	EPLAN P8 2.9 SP1
Manufacturer (company) Electron Industrial Automation Electronshop.ir	
Project name Deep Hole Machin Project	
Make Morteza Pourhasan	
Type	
Place of installation	
Responsible for project	
Contractor	
Created on	8/30/2025
Edit date	10/13/2026
by (short name) M.POURHASAN	
Number of pages 77	

Table of contents

Page	Page description	supplementary page field	Date	Edited by	X
=DHD/1	Title page / cover sheet		10/13/2026	M.POURHASAN	
=DHD/2	Table of contents : =DHD/1 - =DHD+PLC Digital Inputs/33		10/13/2026	M.POURHASAN	
=DHD/3	Table of contents : =DHD+PLC Digital Outputs/34 - =DHD+Feilds Wiring Diagram/66		10/13/2026	M.POURHASAN	
=DHD/4	Table of contents : =DHD+Feilds Wiring Diagram/67 - =DHD+RPT/77		10/13/2026	M.POURHASAN	
=DHD+Layouts/5	Electrical Panel Layouts		10/13/2026	M.POURHASAN	
=DHD+Layouts/6	Electrical Panel Layouts		10/13/2026	M.POURHASAN	
=DHD+Layouts/7	Electrical Panel Layouts		10/13/2026	M.POURHASAN	
=DHD+Layouts/8	Electrical Panel Layouts		10/13/2026	M.POURHASAN	
=DHD+Main Electrical Distribution/9	Main Power Supply		10/13/2026	M.POURHASAN	
=DHD+Main Electrical Distribution/10	Main Power Converter		10/13/2026	M.POURHASAN	
=DHD+Main Electrical Distribution/11	Main 24V Power Supply		10/13/2026	M.POURHASAN	
=DHD+Main Electrical Distribution/12	Emergency Cycle		10/13/2026	M.POURHASAN	
=DHD+Main Electrical Distribution/13	Limit Switch Emergency Stop		10/13/2026	M.POURHASAN	
=DHD+Main Electrical Distribution/14	Main Contactors		10/13/2026	M.POURHASAN	
=DHD+Main Electrical Distribution/15	Light & Socket & Air Conditioner		10/13/2026	M.POURHASAN	
=DHD+Main Electrical Distribution/16	Main Panel Fault Lights		10/13/2026	M.POURHASAN	
=DHD+Main Electrical Distribution/17	PLC Rack		10/13/2026	M.POURHASAN	
=DHD+Modbus Network/18	Indicators Network(OP1)		10/13/2026	M.POURHASAN	
=DHD+Modbus Network/19	Indicators Network(OP2)		10/13/2026	M.POURHASAN	
=DHD+Modbus Network/20	Indicators Network (OP3)		10/13/2026	M.POURHASAN	
=DHD+Modbus Network/21	Indicators Network (OP4)		10/13/2026	M.POURHASAN	
=DHD+PLC Digital Inputs/22	Main Electrical Distribution Status		10/13/2026	M.POURHASAN	
=DHD+PLC Digital Inputs/23	PLC Digital Inputs Spare		10/13/2026	M.POURHASAN	
=DHD+PLC Digital Inputs/24	Main HeadStock		10/13/2026	M.POURHASAN	
=DHD+PLC Digital Inputs/25	Main HeadStock		10/13/2026	M.POURHASAN	
=DHD+PLC Digital Inputs/26	Main HeadStock (Drive Status)		10/13/2026	M.POURHASAN	
=DHD+PLC Digital Inputs/27	HMI OP		10/13/2026	M.POURHASAN	
=DHD+PLC Digital Inputs/28	Oil Pressure Head (Limit & Level Switch)		10/13/2026	M.POURHASAN	
=DHD+PLC Digital Inputs/29	Oil Pressure Head (Drive Status)		10/13/2026	M.POURHASAN	
=DHD+PLC Digital Inputs/30	Boring Head		10/13/2026	M.POURHASAN	
=DHD+PLC Digital Inputs/31	Boring Head		10/13/2026	M.POURHASAN	
=DHD+PLC Digital Inputs/32	Boring Head (Drive Status)		10/13/2026	M.POURHASAN	
=DHD+PLC Digital Inputs/33	Coolant Oil Cycle		10/13/2026	M.POURHASAN	

Table of contents

Page	Page description	supplementary page field	Date	Edited by	X
=DHD+PLC Digital Outputs/34	PLC Output Spare		10/13/2026	M.POURHASAN	
=DHD+PLC Digital Outputs/35	PLC Output Spare		10/13/2026	M.POURHASAN	
=DHD+PLC Digital Outputs/36	Main HeadStock		10/13/2026	M.POURHASAN	
=DHD+PLC Digital Outputs/37	Main HeadStock		10/13/2026	M.POURHASAN	
=DHD+PLC Digital Outputs/38	Main HeadStock		10/13/2026	M.POURHASAN	
=DHD+PLC Digital Outputs/39	Oil Pressure Head		10/13/2026	M.POURHASAN	
=DHD+PLC Digital Outputs/40	Boring Head		10/13/2026	M.POURHASAN	
=DHD+PLC Digital Outputs/41	Boring Head		10/13/2026	M.POURHASAN	
=DHD+PLC Digital Outputs/42	Coolant Oil Cycle		10/13/2026	M.POURHASAN	
=DHD+PLC Analog Inputs/43	Main HeadStock Spindle Speed & Current		10/13/2026	M.POURHASAN	
=DHD+PLC Analog Inputs/44	Oil Pressure Head Motor Current		10/13/2026	M.POURHASAN	
=DHD+PLC Analog Inputs/45	Boring Head Rotating Speed & Current		10/13/2026	M.POURHASAN	
=DHD+PLC Analog Outputs/46	Drives Speed Refrence		10/13/2026	M.POURHASAN	
=DHD+Motor Drives/47	Main HeadStock Spindle DC Drive		10/13/2026	M.POURHASAN	
=DHD+Motor Drives/48	Main HeadStock Spindle DC Drive		10/13/2026	M.POURHASAN	
=DHD+Motor Drives/49	Oil Pressure Head Carriage DC Drive		10/13/2026	M.POURHASAN	
=DHD+Motor Drives/50	Oil Pressure Head Carriage DC Drive		10/13/2026	M.POURHASAN	
=DHD+Motor Drives/51	Boring Head Carriage DC Drive		10/13/2026	M.POURHASAN	
=DHD+Motor Drives/52	Boring Head Rotating DC Drive		10/13/2026	M.POURHASAN	
=DHD+Motor Drives/53	Main HeadStock Spindle AC Drive		10/13/2026	M.POURHASAN	
=DHD+Feilds Wiring Diagram/54	Main HeadStock Spindle Lubrication Pump		10/13/2026	M.POURHASAN	
=DHD+Feilds Wiring Diagram/55	Main HeadStock Gear Change Motor		10/13/2026	M.POURHASAN	
=DHD+Feilds Wiring Diagram/56	Main HeadStock Gear Change Command		10/13/2026	M.POURHASAN	
=DHD+Feilds Wiring Diagram/57	Main HeadStock warning Lights		10/13/2026	M.POURHASAN	
=DHD+Feilds Wiring Diagram/58	Main HeadStock Spindle Motor Fan		10/13/2026	M.POURHASAN	
=DHD+Feilds Wiring Diagram/59	Oil Pressure Head Lubrication Pump		10/13/2026	M.POURHASAN	
=DHD+Feilds Wiring Diagram/60	Boring Head Carriage Lubrication Pump		10/13/2026	M.POURHASAN	
=DHD+Feilds Wiring Diagram/61	Boring Head Rotating Lubrication Pump		10/13/2026	M.POURHASAN	
=DHD+Feilds Wiring Diagram/62	Boring Head Rotating warning Lights		10/13/2026	M.POURHASAN	
=DHD+Feilds Wiring Diagram/63	Boring Head Carriage Motor Fan		10/13/2026	M.POURHASAN	
=DHD+Feilds Wiring Diagram/64	Boring Head Rotating Motor Fan		10/13/2026	M.POURHASAN	
=DHD+Feilds Wiring Diagram/65	Coolant Oil Cycle Return Pump 1&2		10/13/2026	M.POURHASAN	
=DHD+Feilds Wiring Diagram/66	Coolant Oil Valves		10/13/2026	M.POURHASAN	

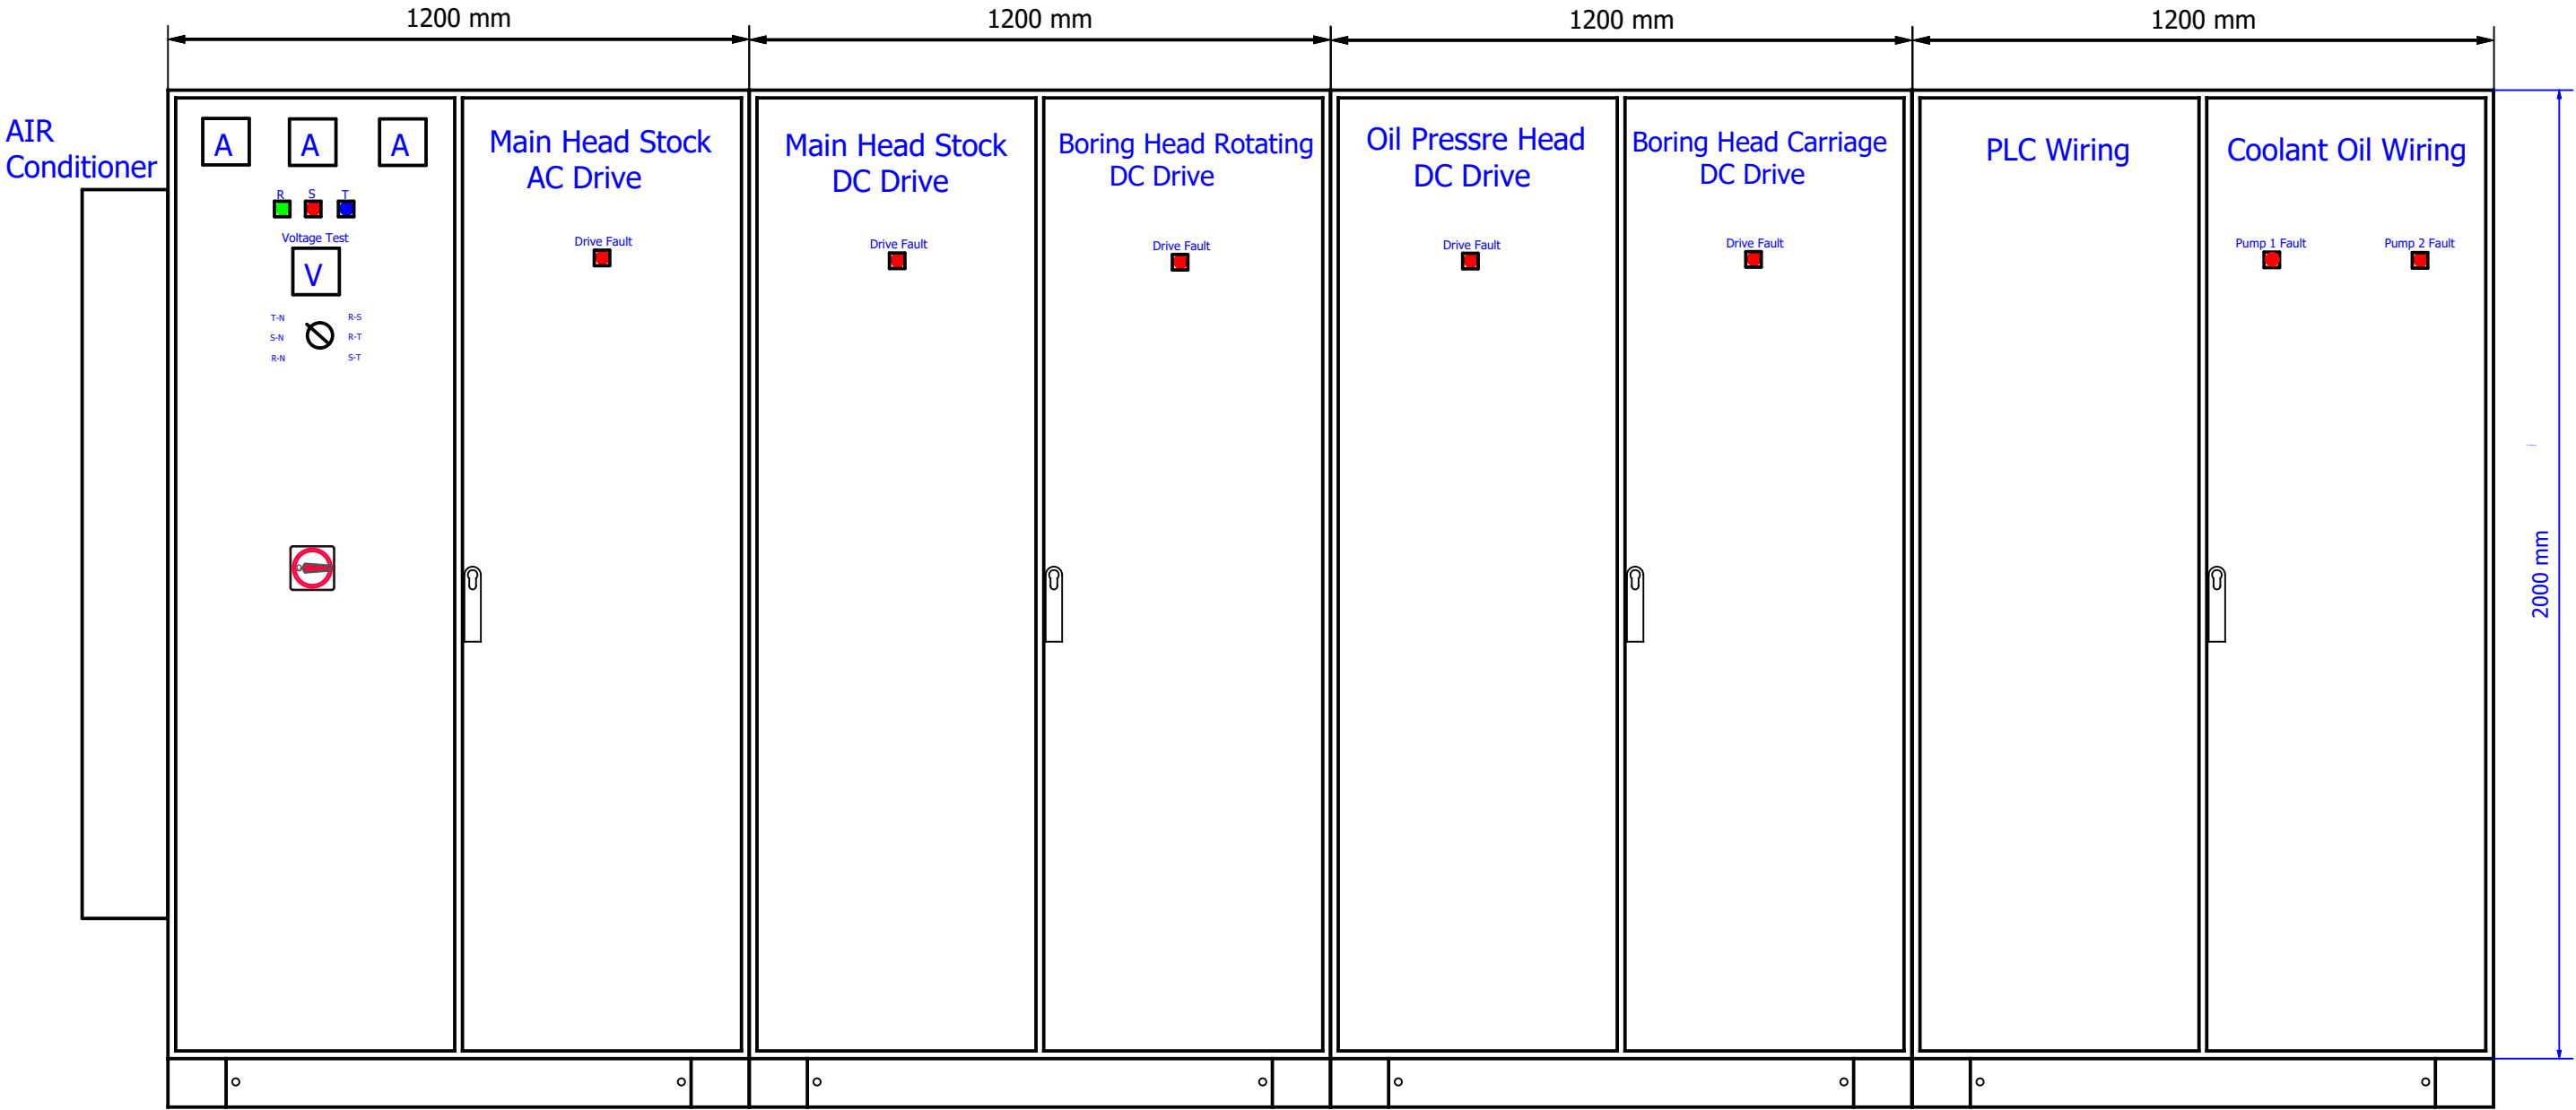


Front View






Enclosure : Rittal Model

Panel Thickness : 2 mm


Main Panel : Back Closed

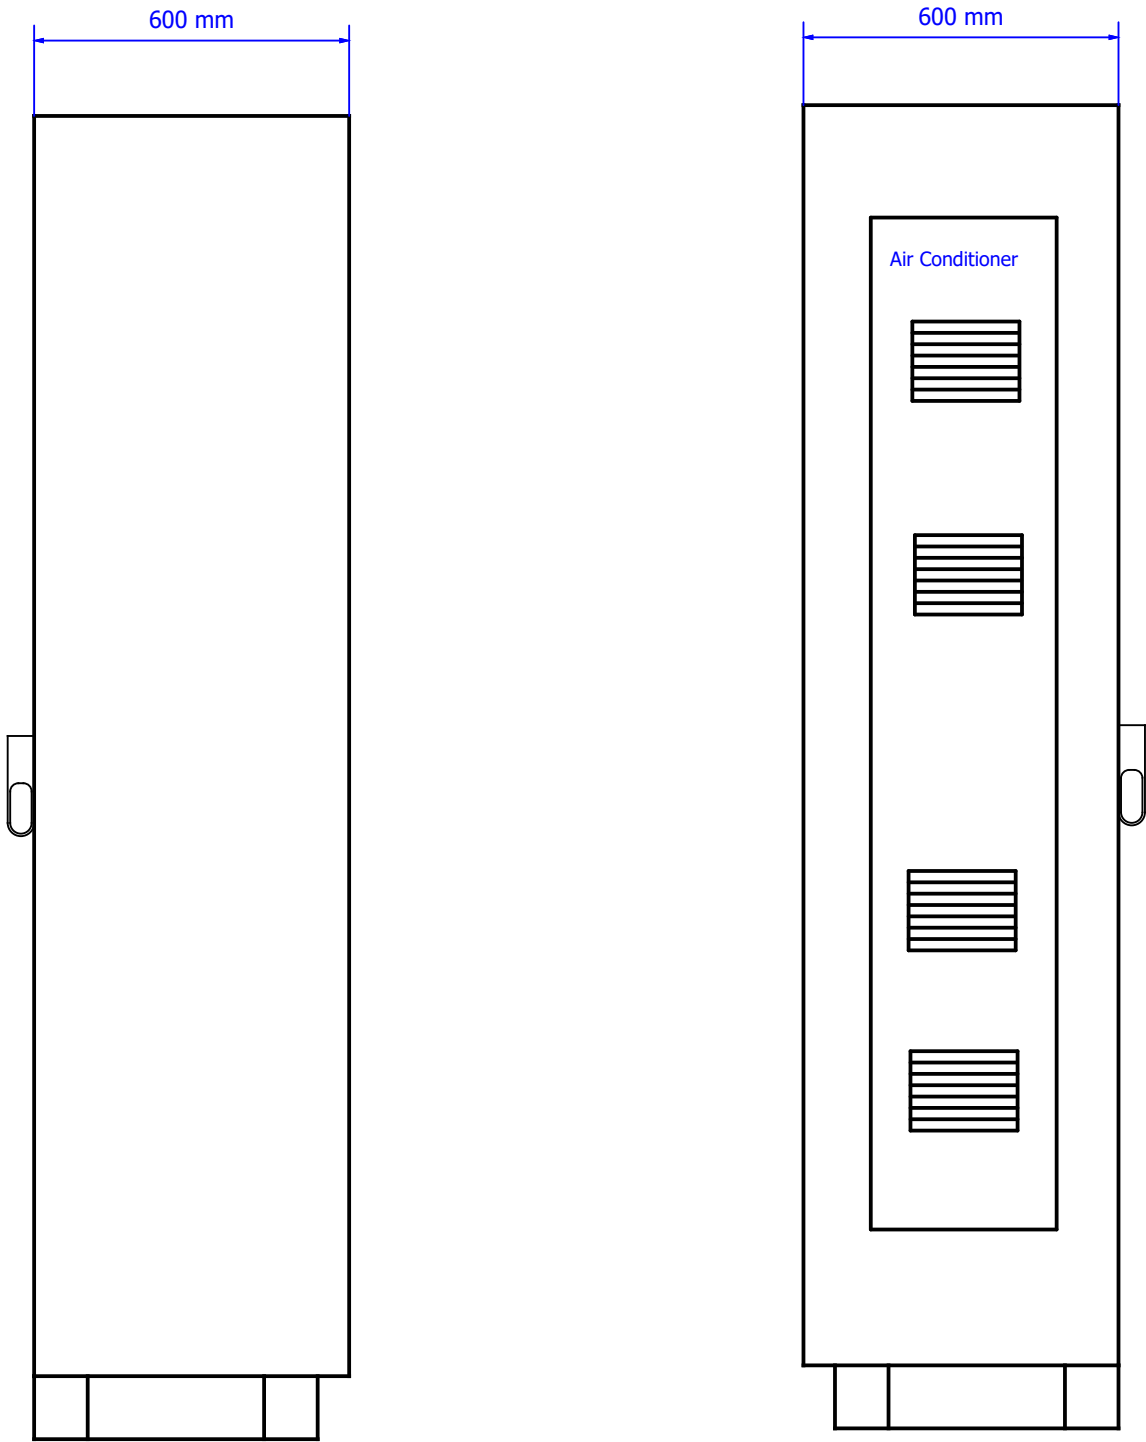



Main Panel Side View

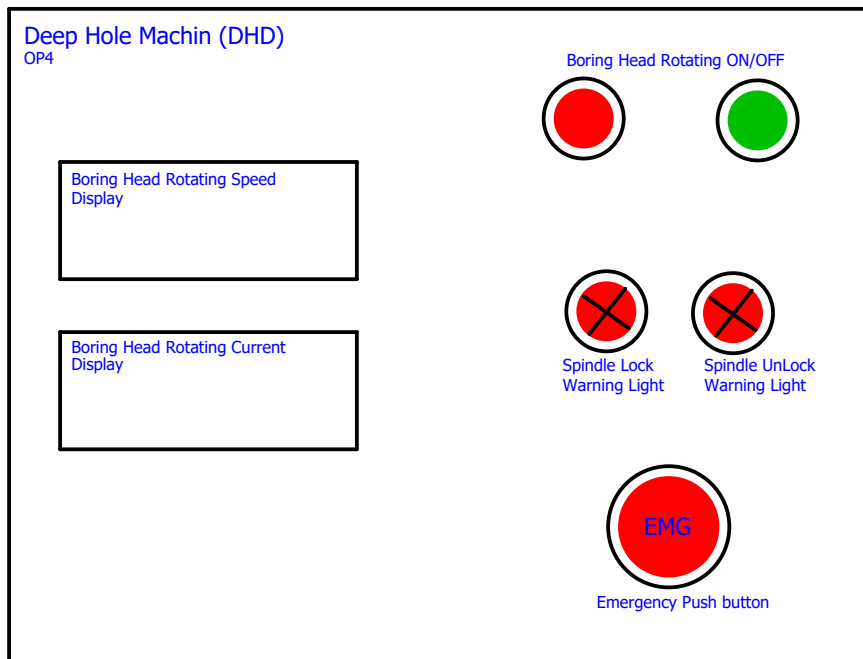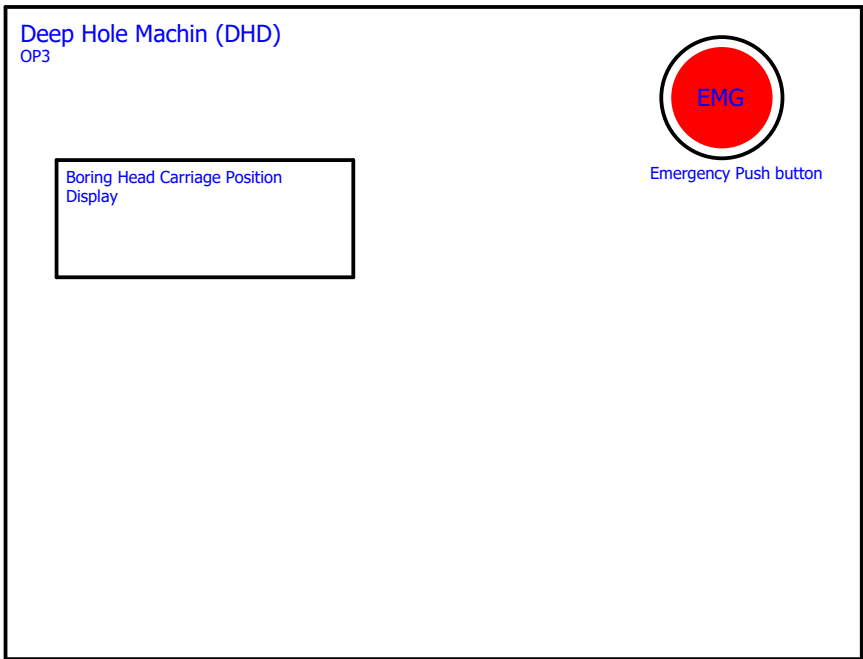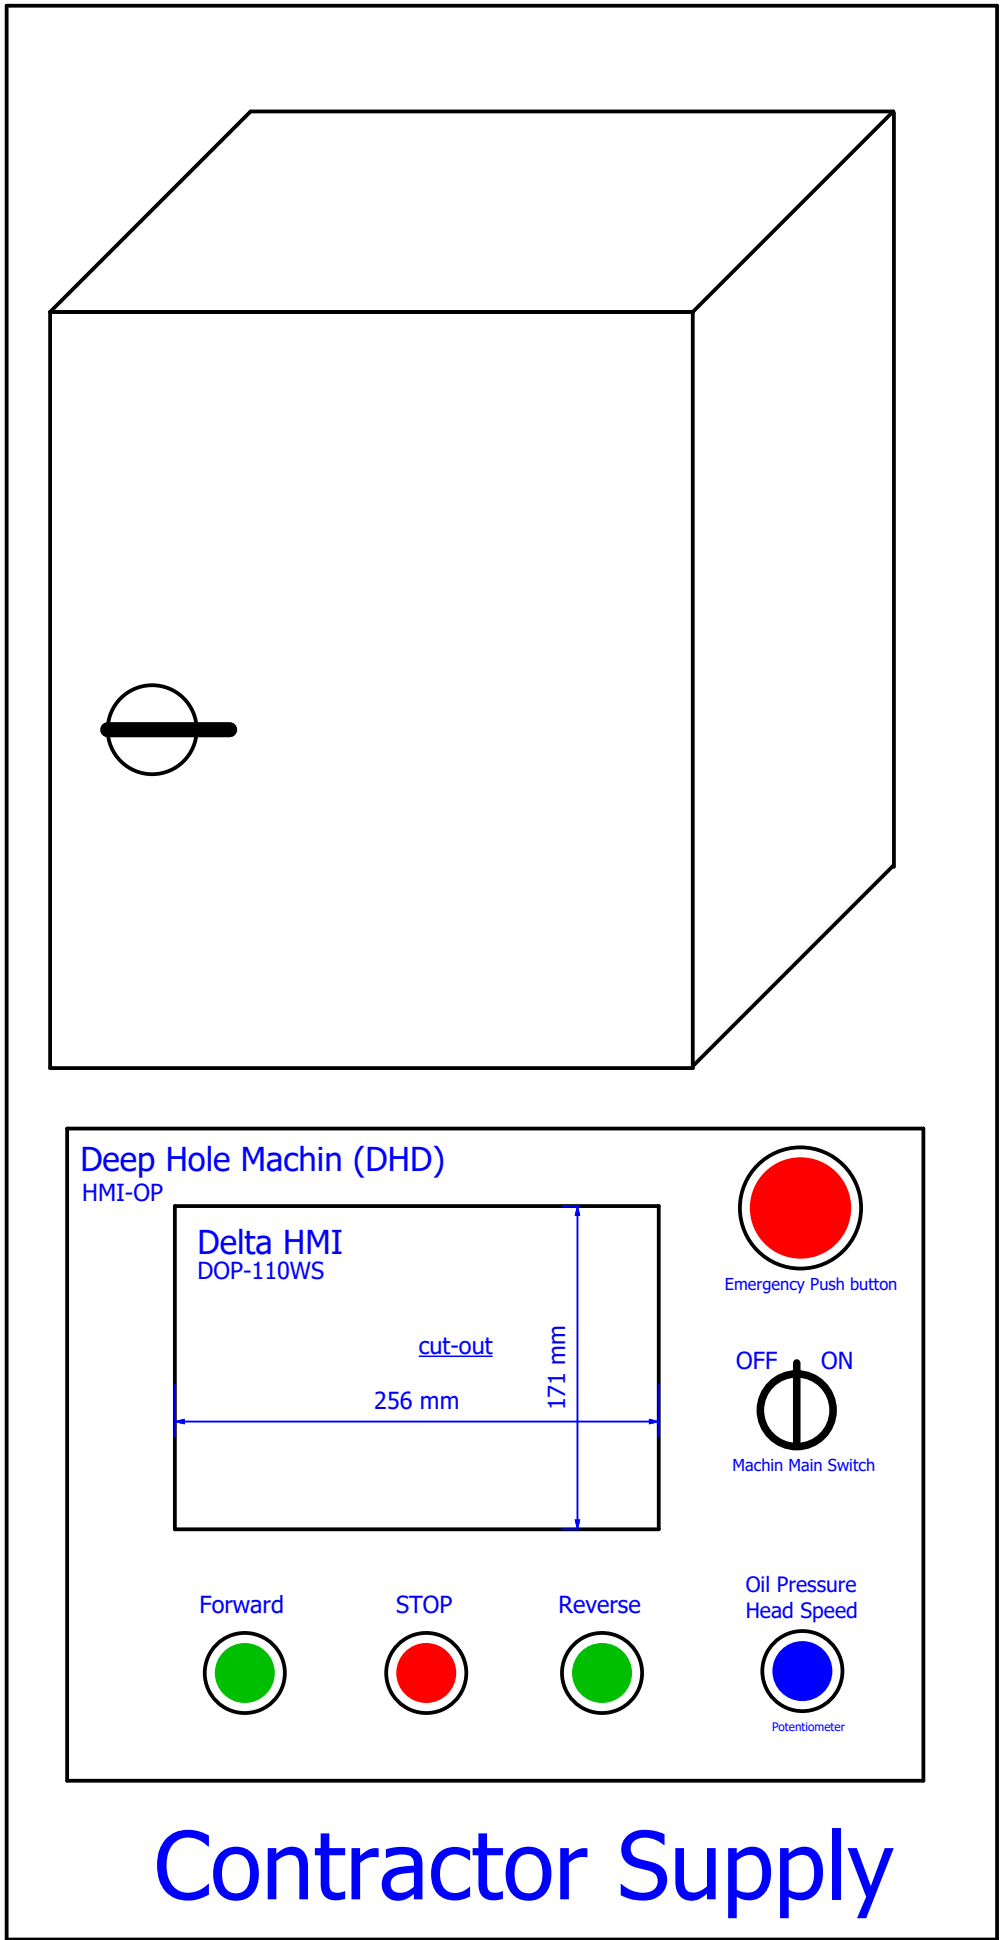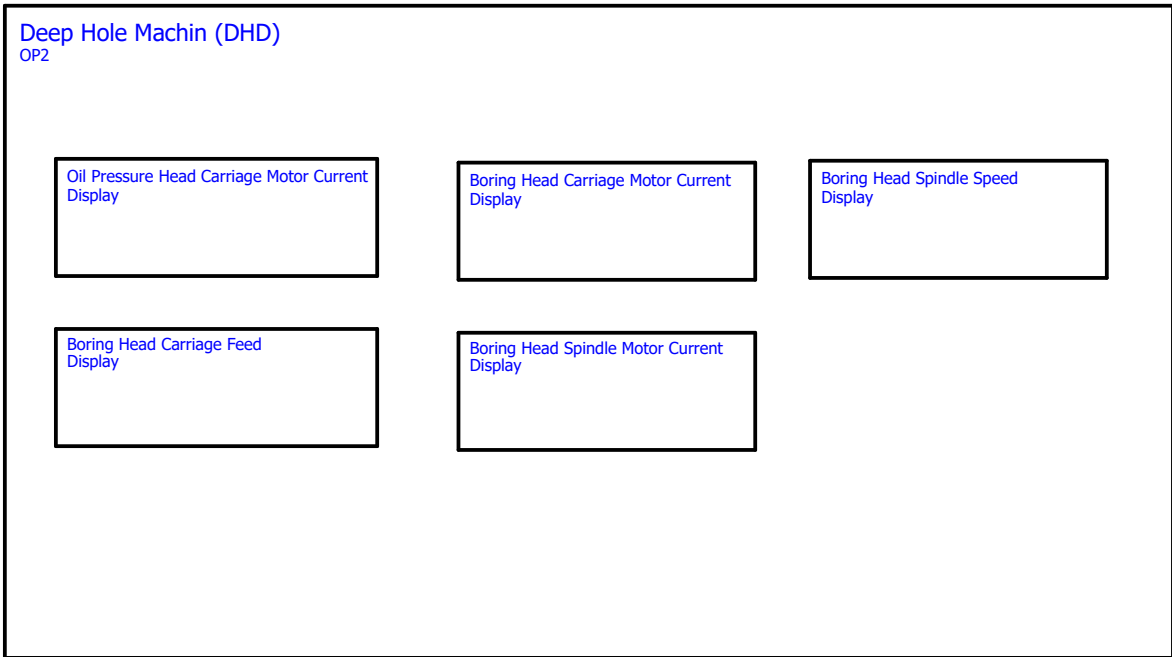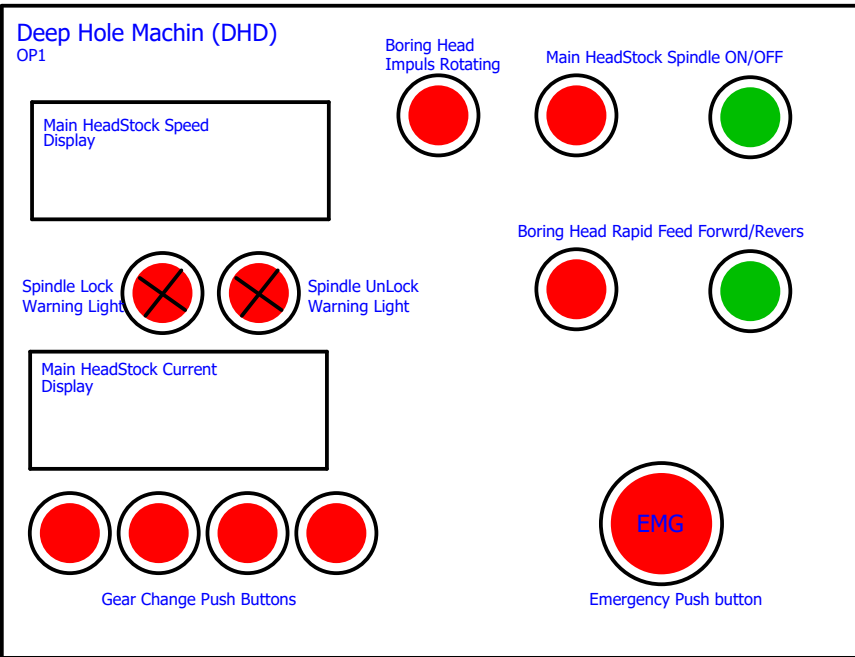



AIR
Conditioner

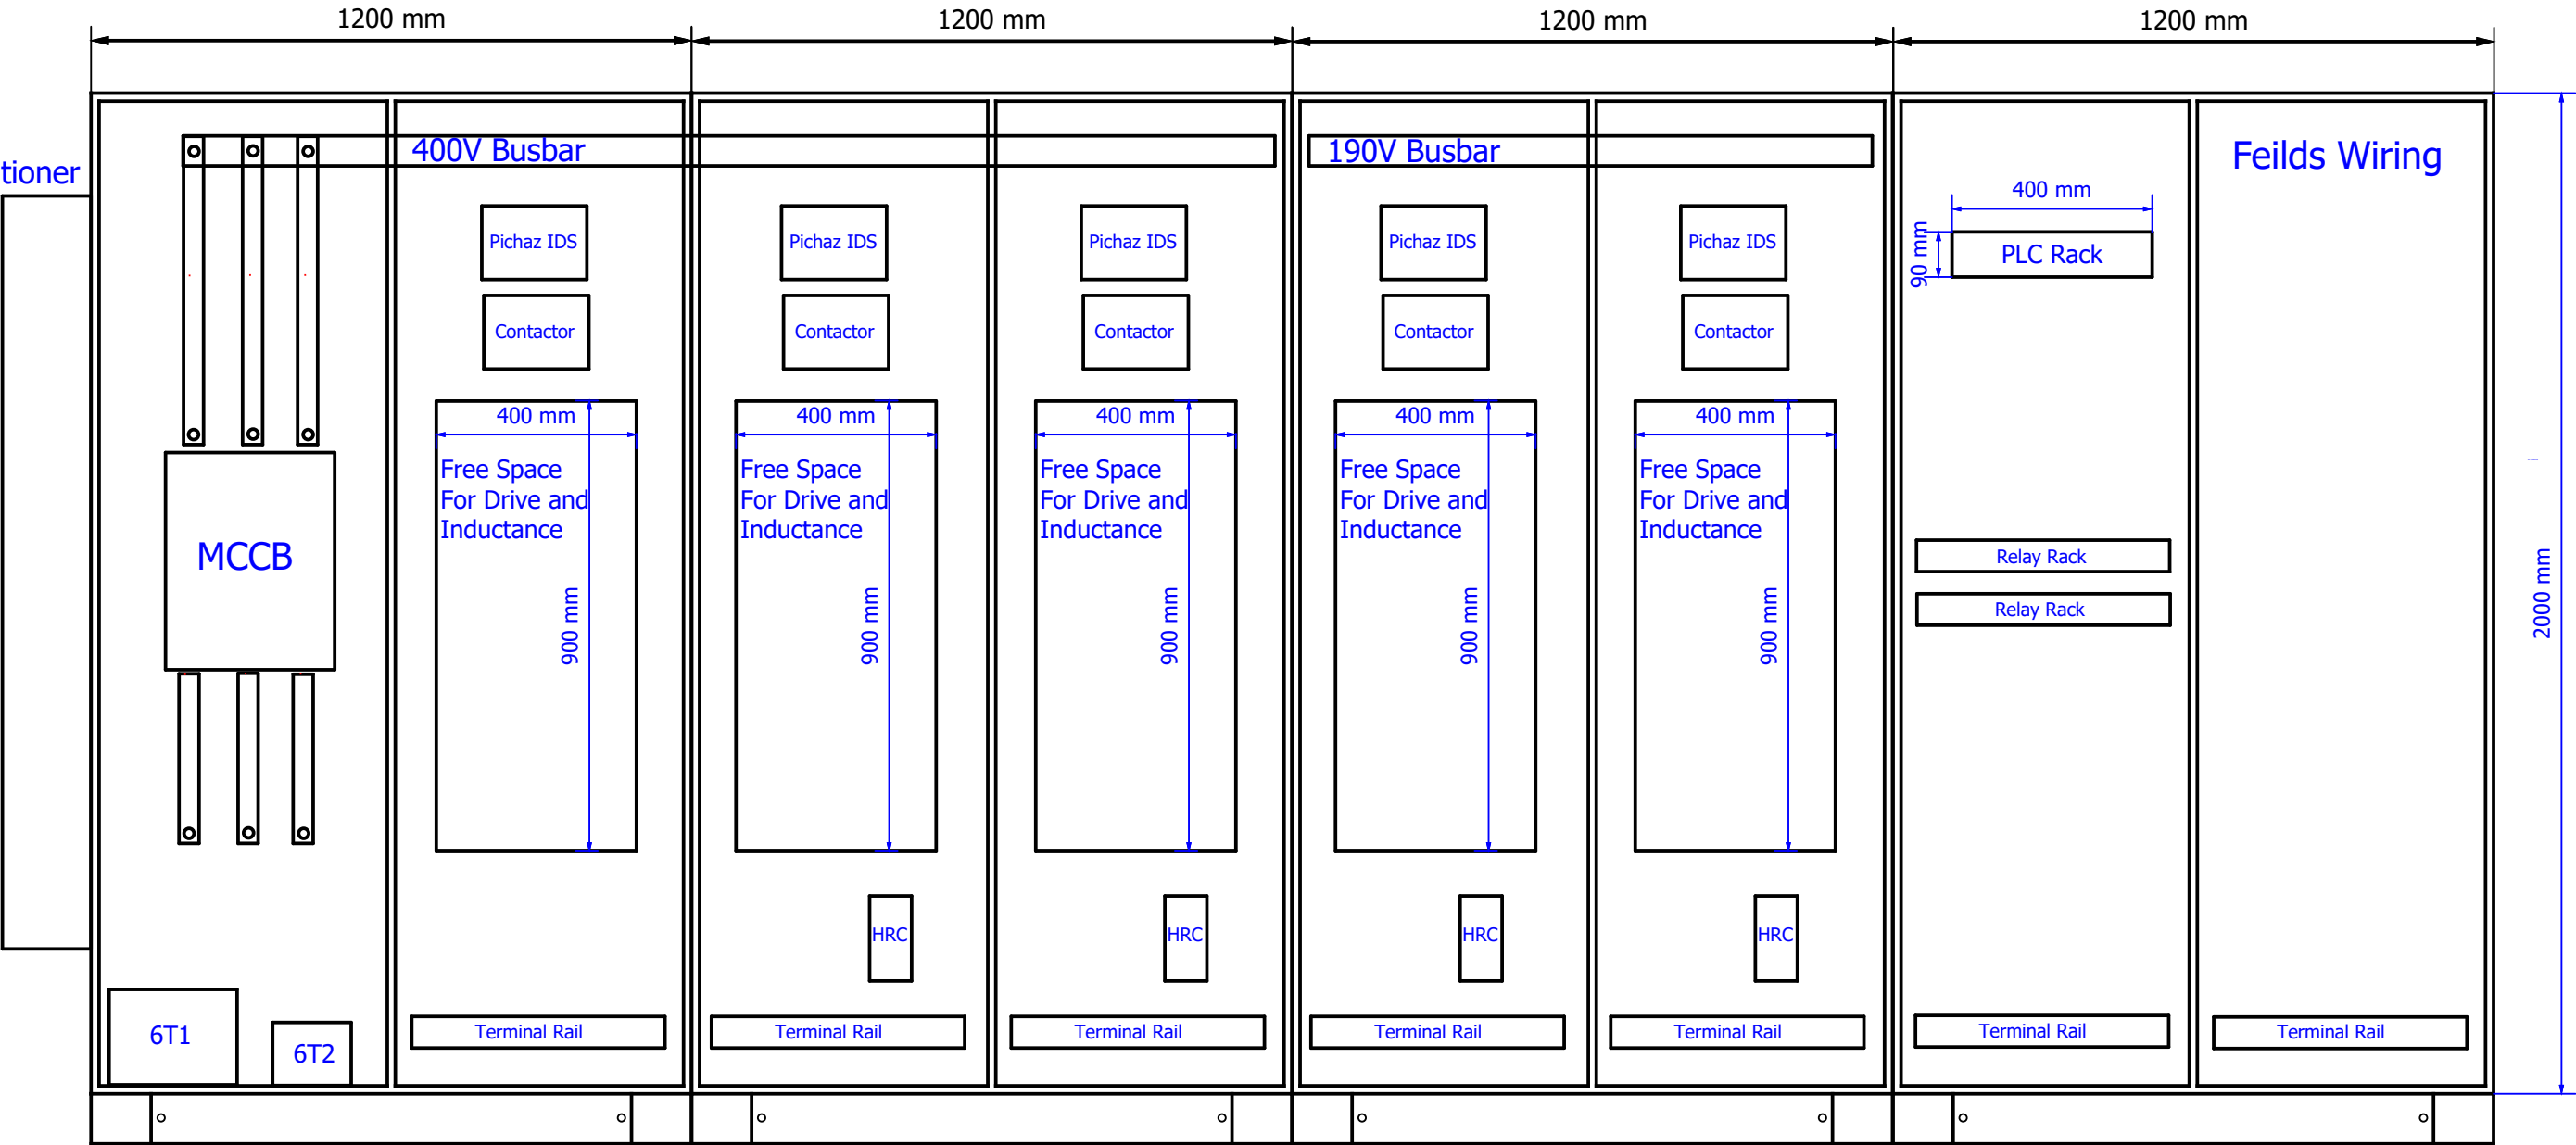

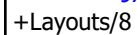


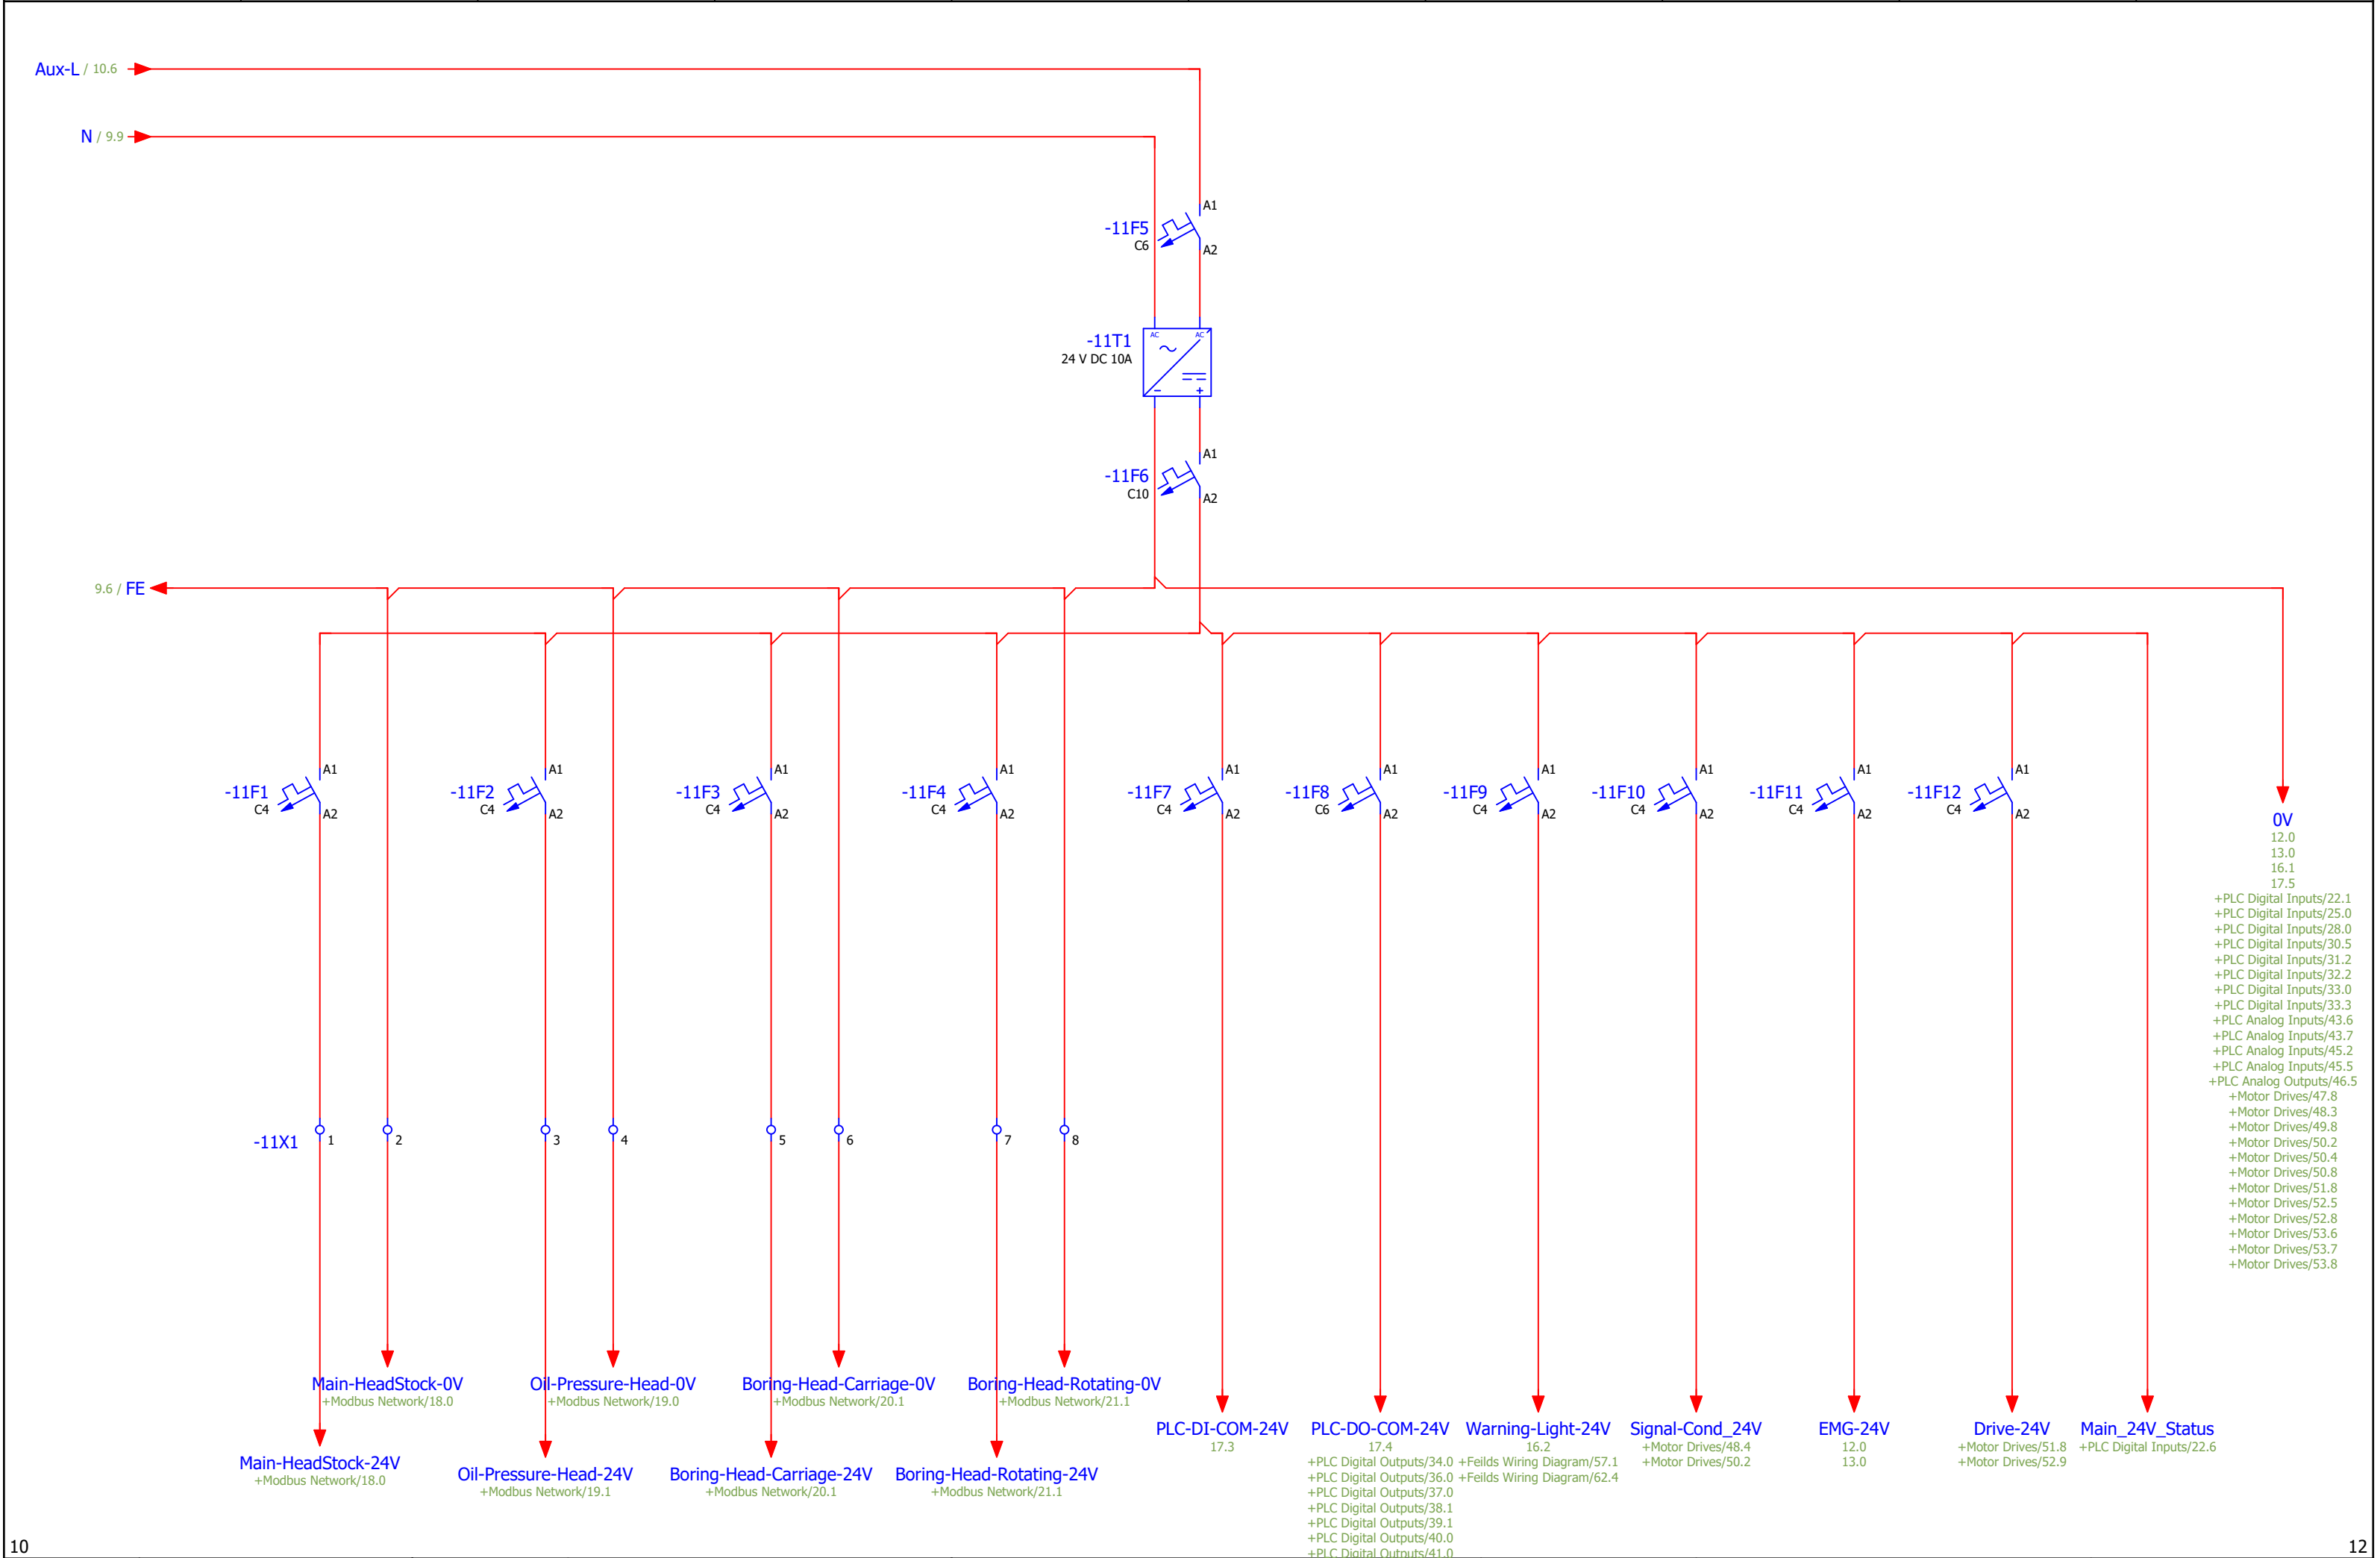

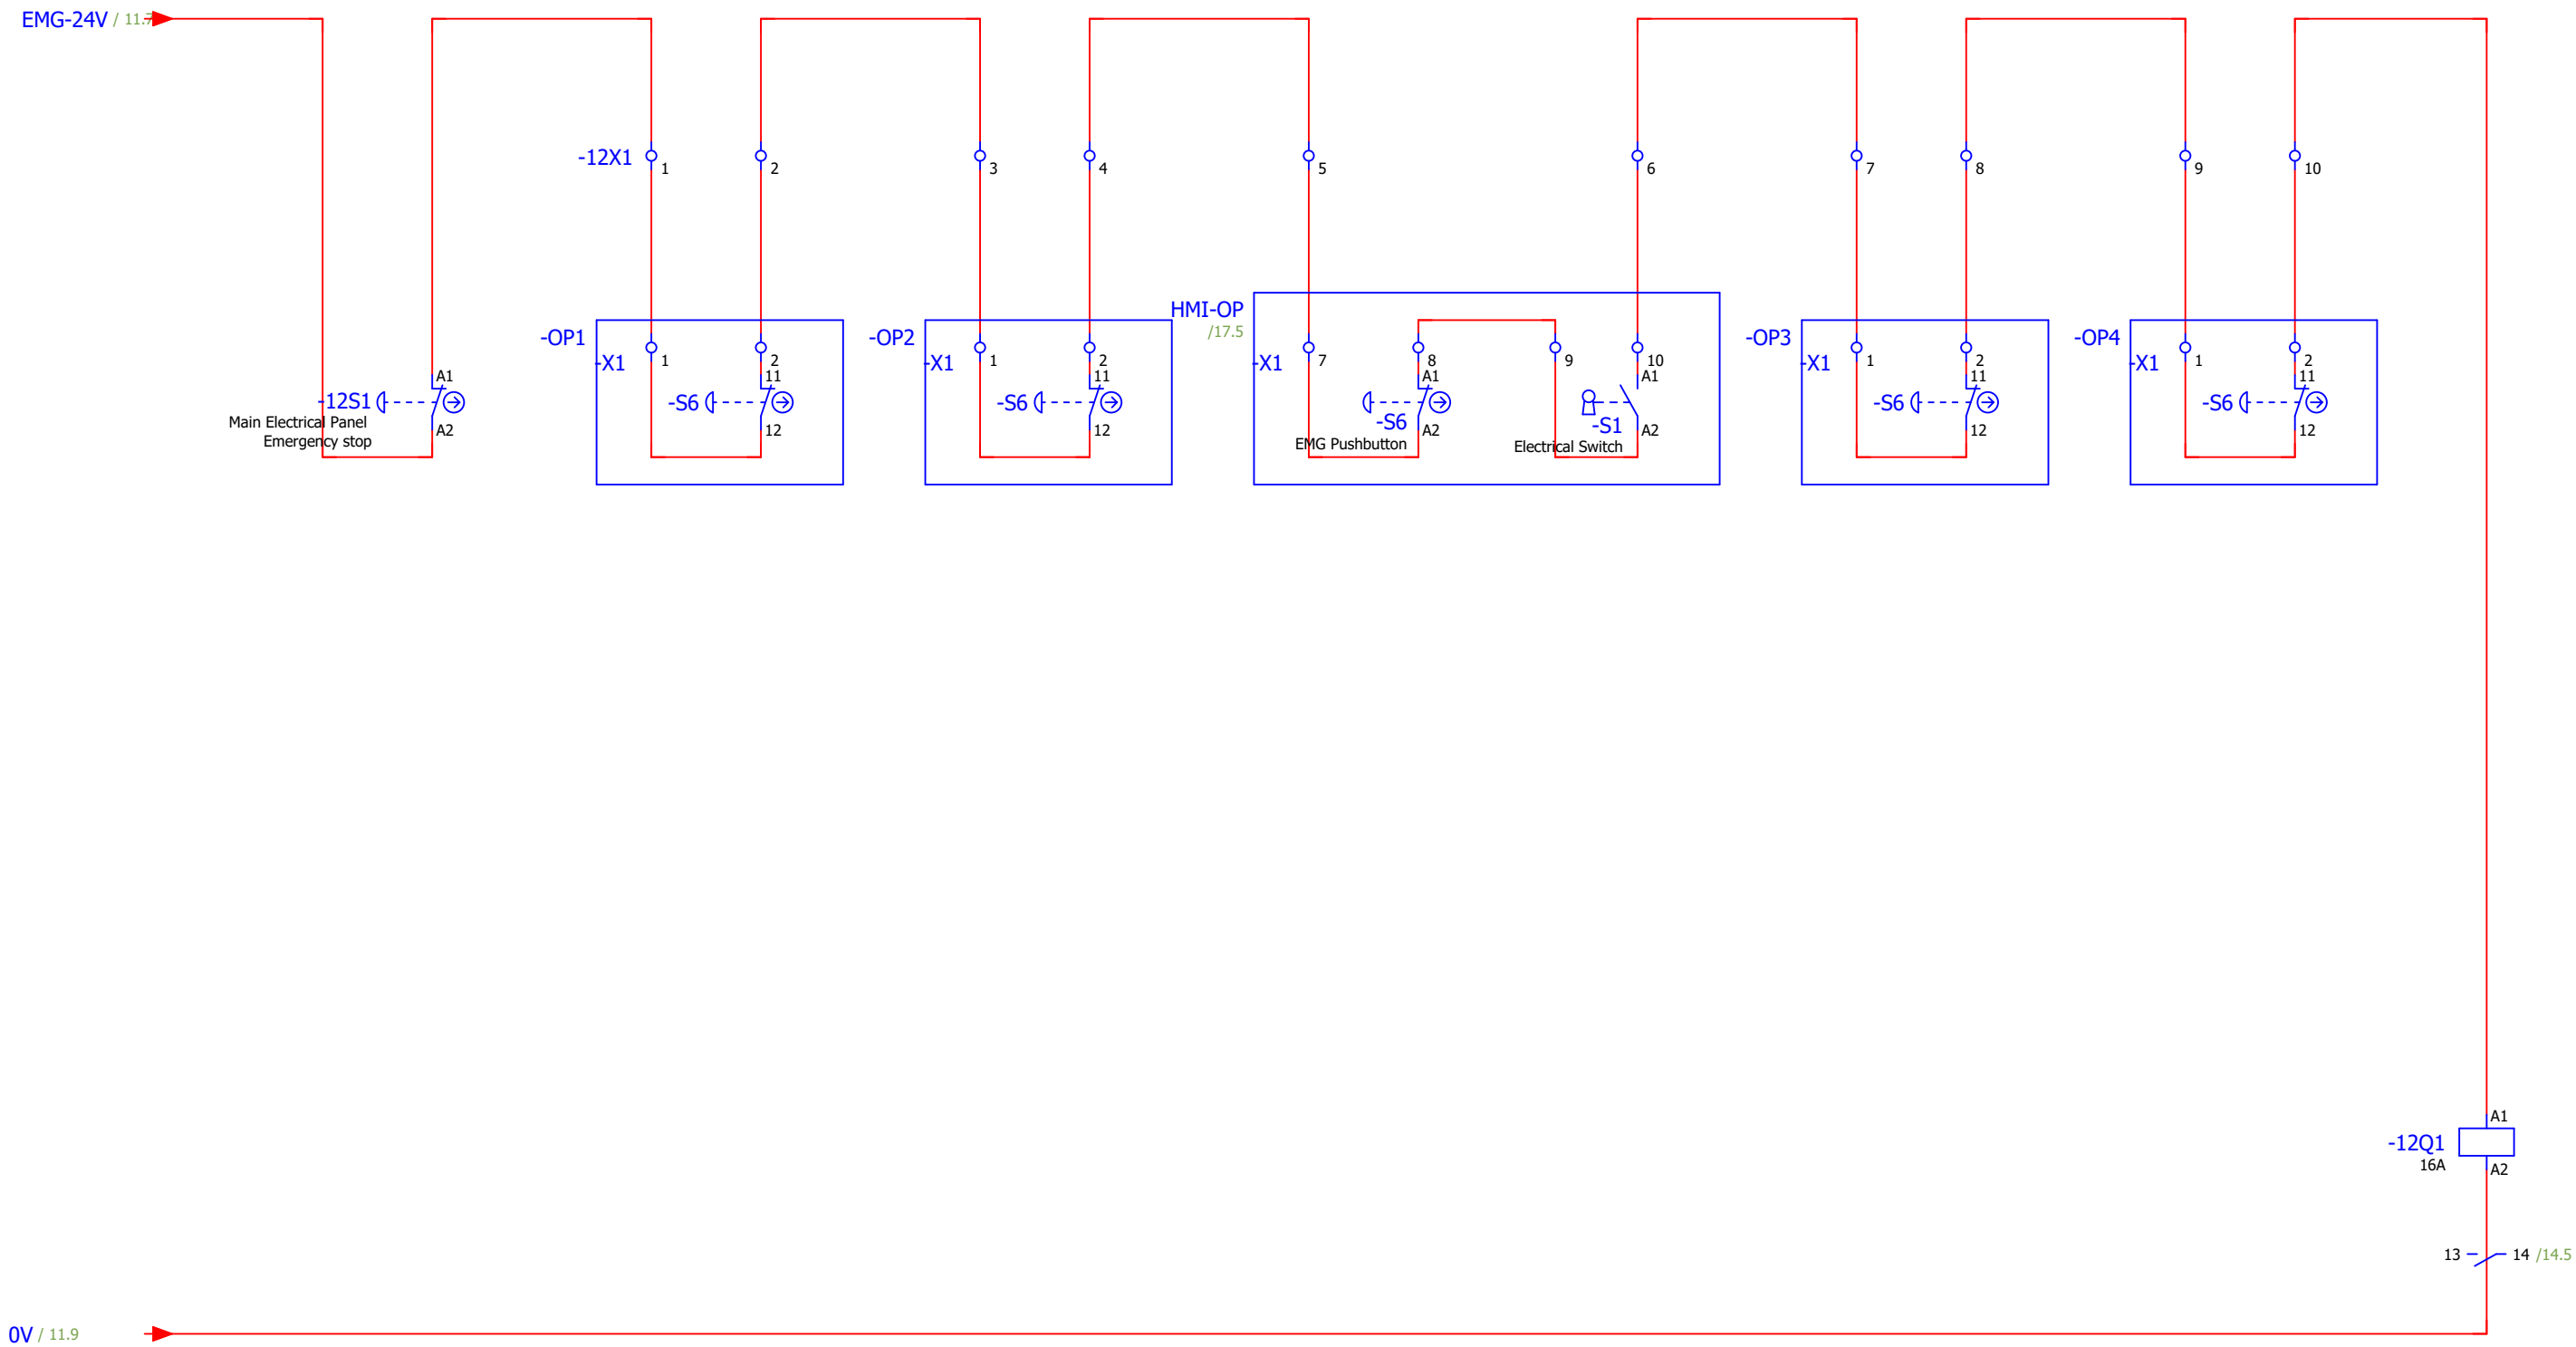


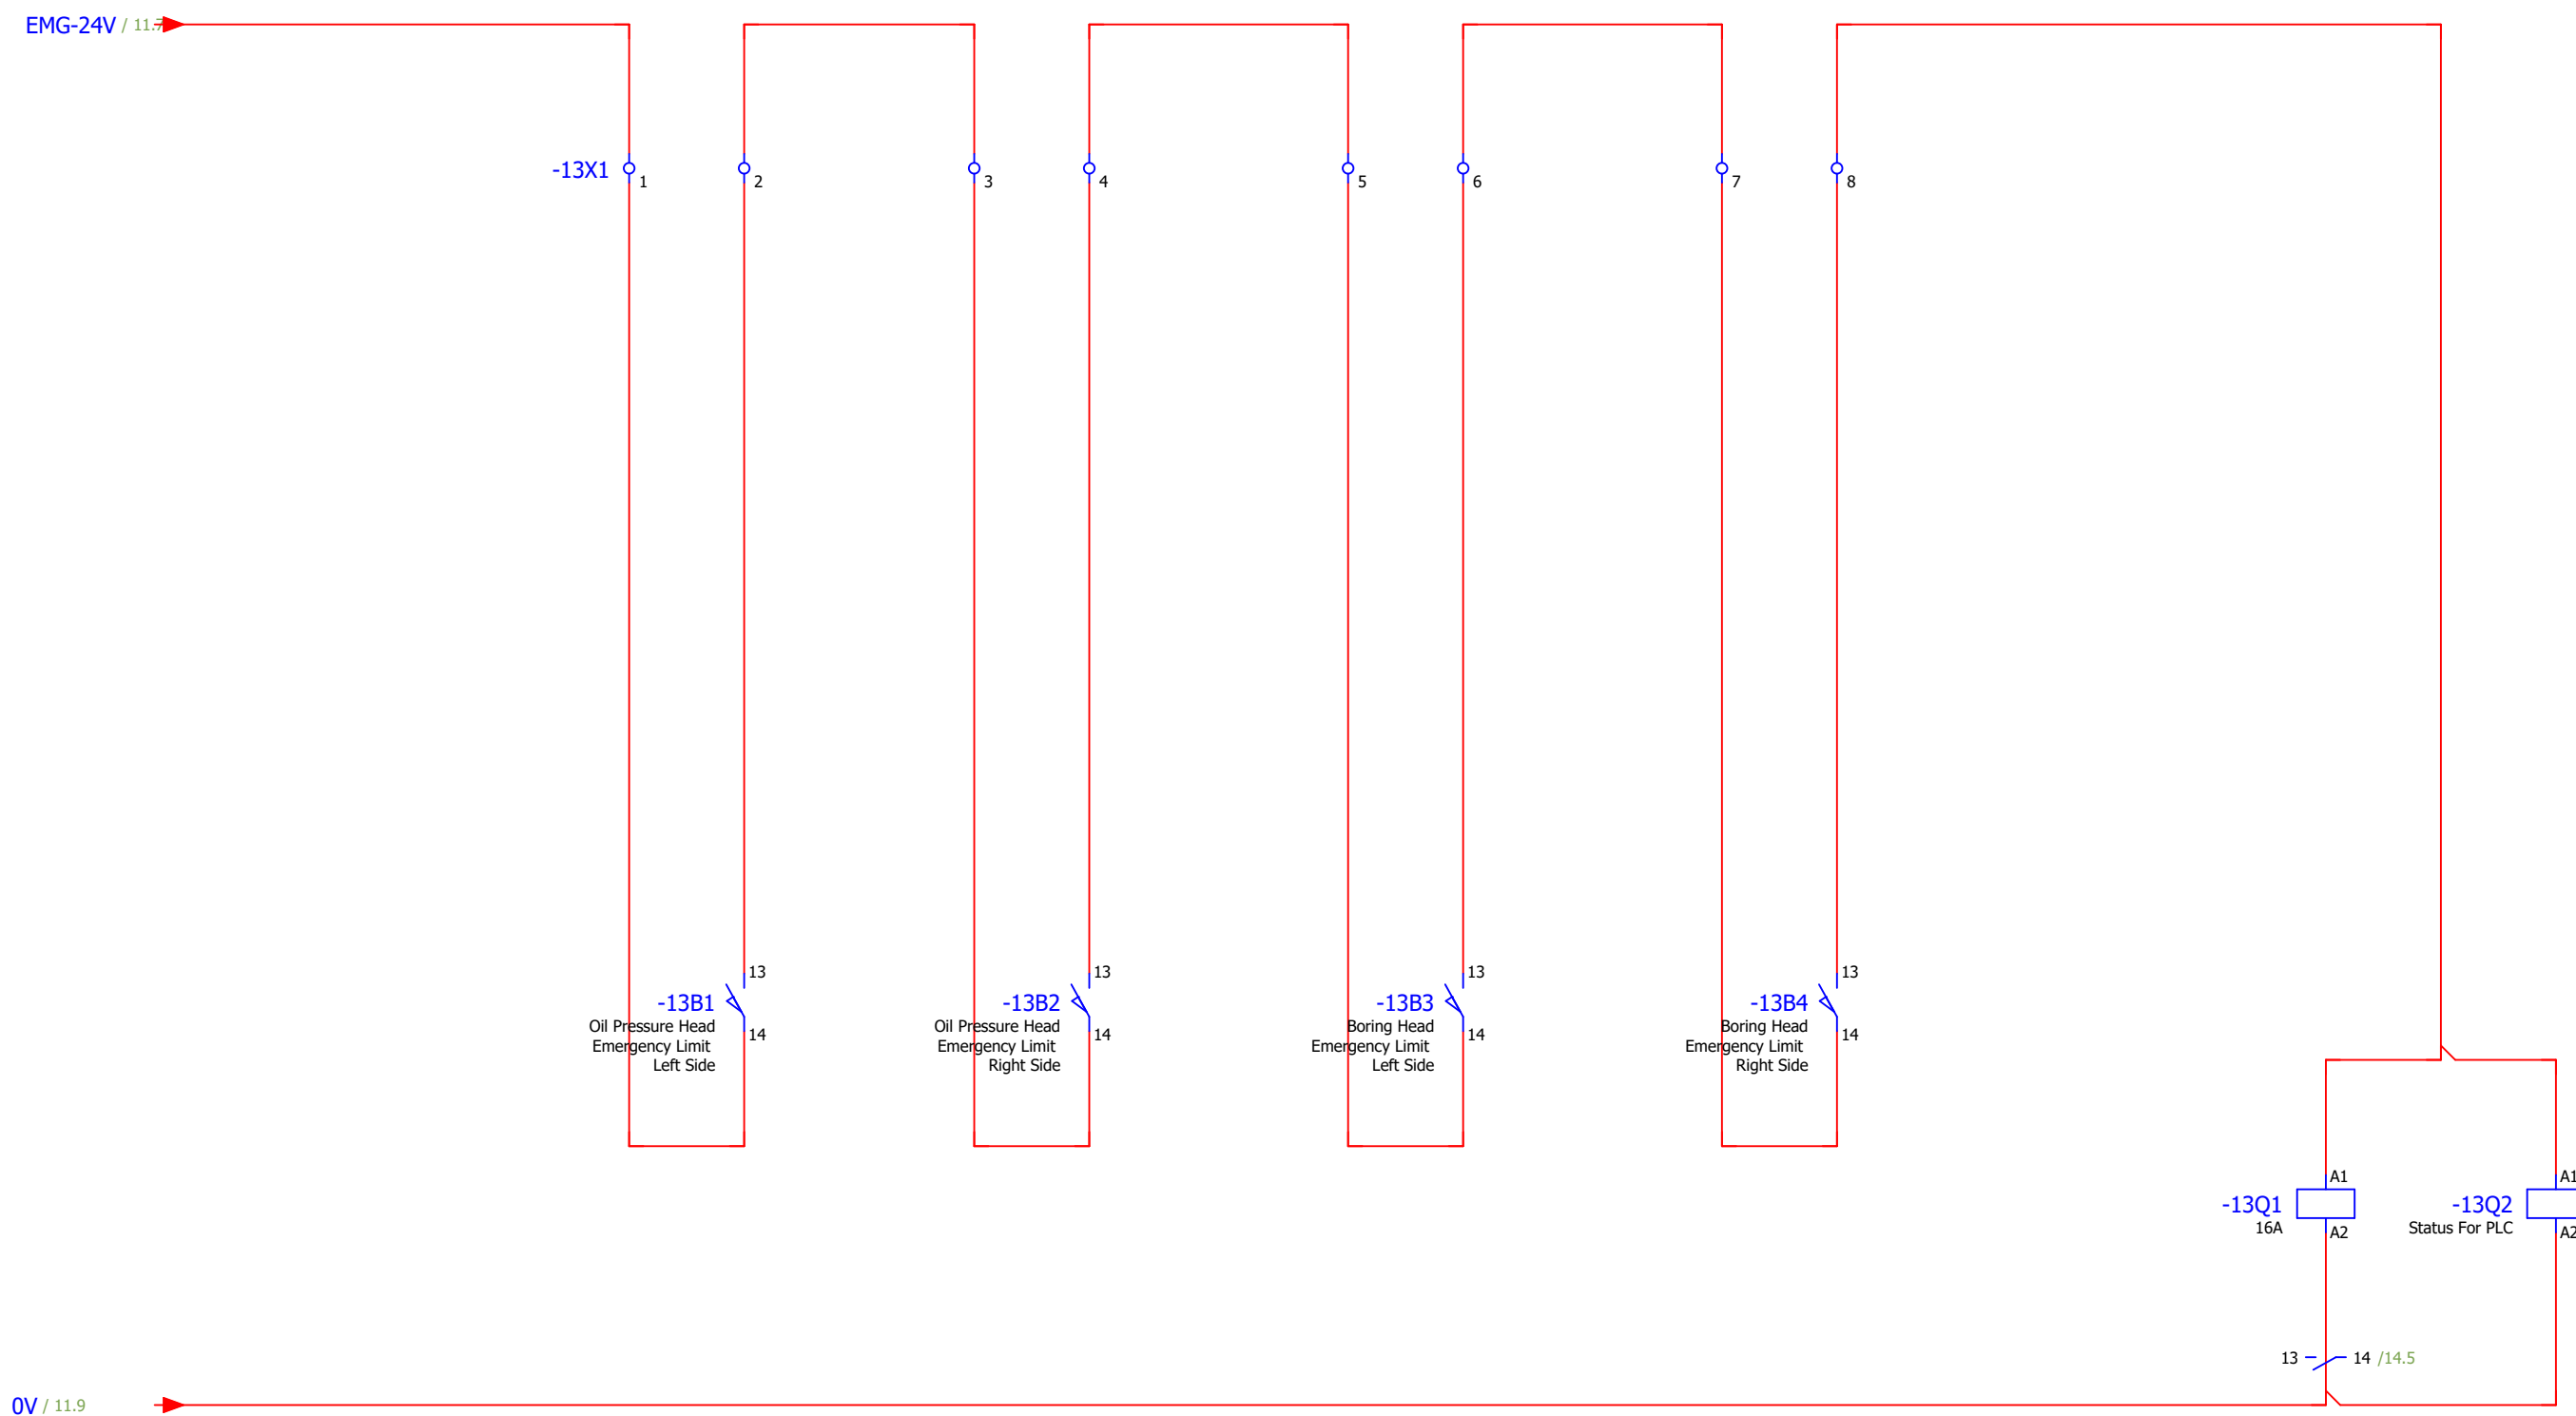



As Built				Project Description : Deep Hole Machin (DHD)	Page Description : Limit Switch Emergency Stop		Job Number : ELEC-007		= DHD			
For Manufacturing	1404.10.14	Morteza Pourhasan					+ Main Electrical Distribution					
For Check	1404.9.15	Morteza Pourhasan	+989158875113									
Modification	Date	Design & Confirm	Contact US									

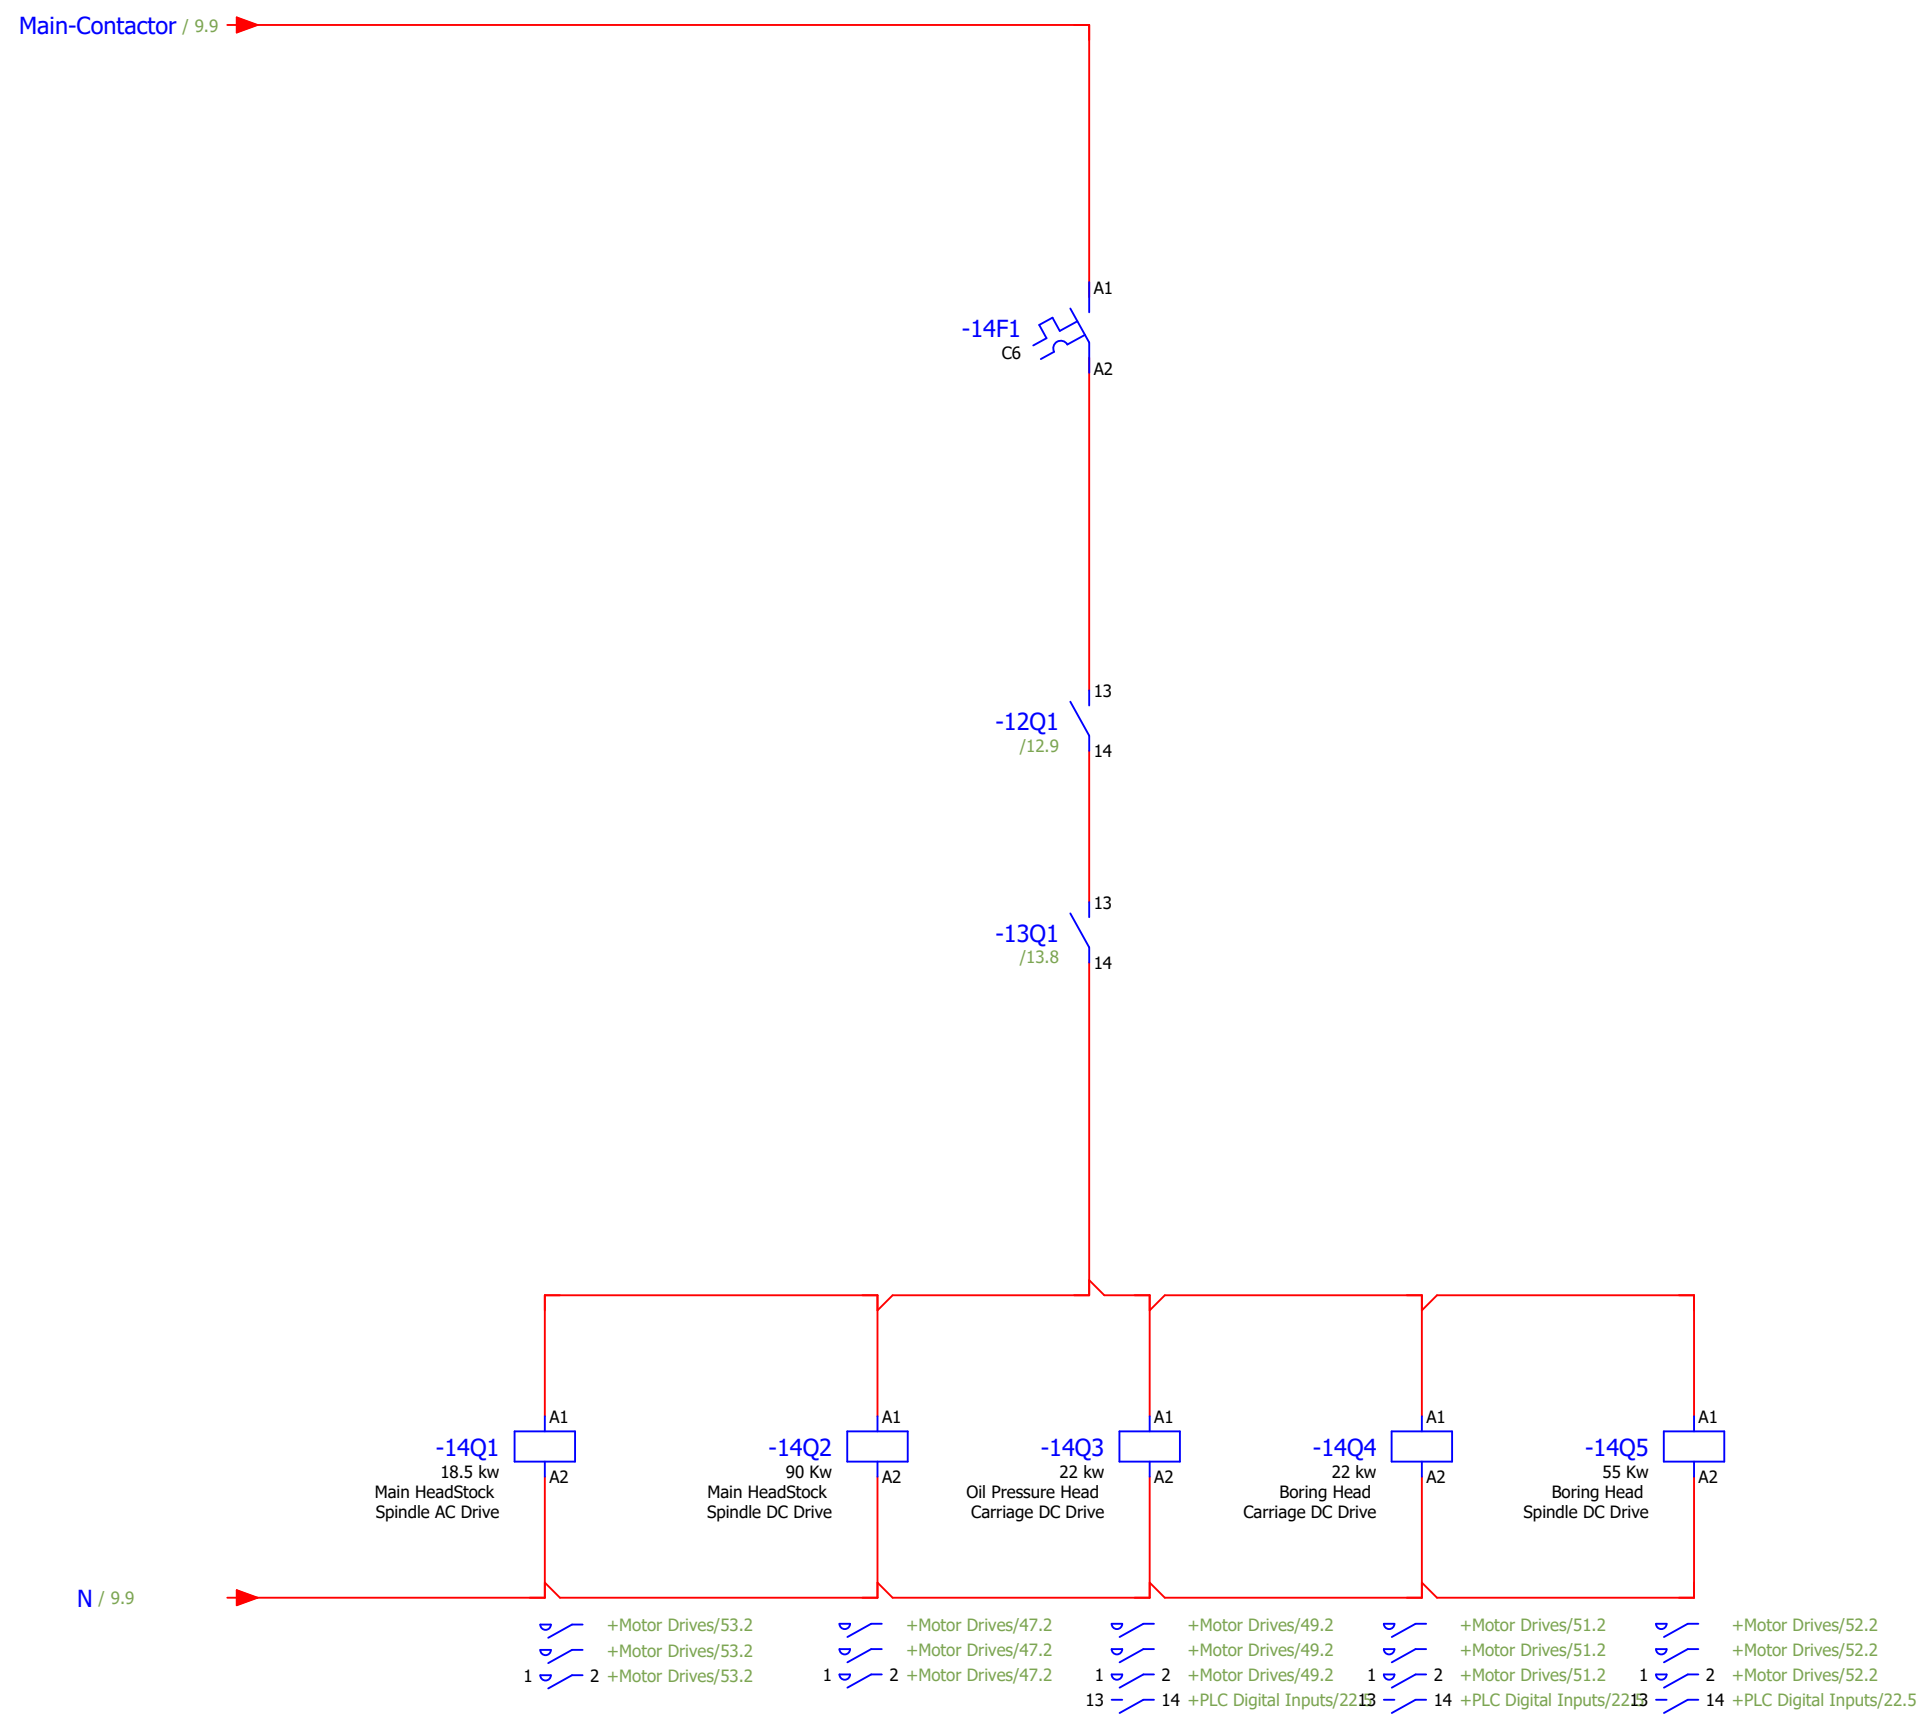



As Built				Project Description : Deep Hole Machin (DHD)	Page Description : Main Contactors	 اكترون شاپ ELECTRONSHOP.IR	Job Number : ELEC-007		= DHD			
For Manufacturing	1404.10.14	Morteza Pourhasan					+ Main Electrical Distribution					
For Check	1404.9.15	Morteza Pourhasan	+989158875113									
Modification	Date	Design & Confirm	Contact US									
							Software Version : EPLAN P8 2.9 SP1	Project Start : 8/30/2025	Last Edition : 10/13/2026	Page 14 / 77		

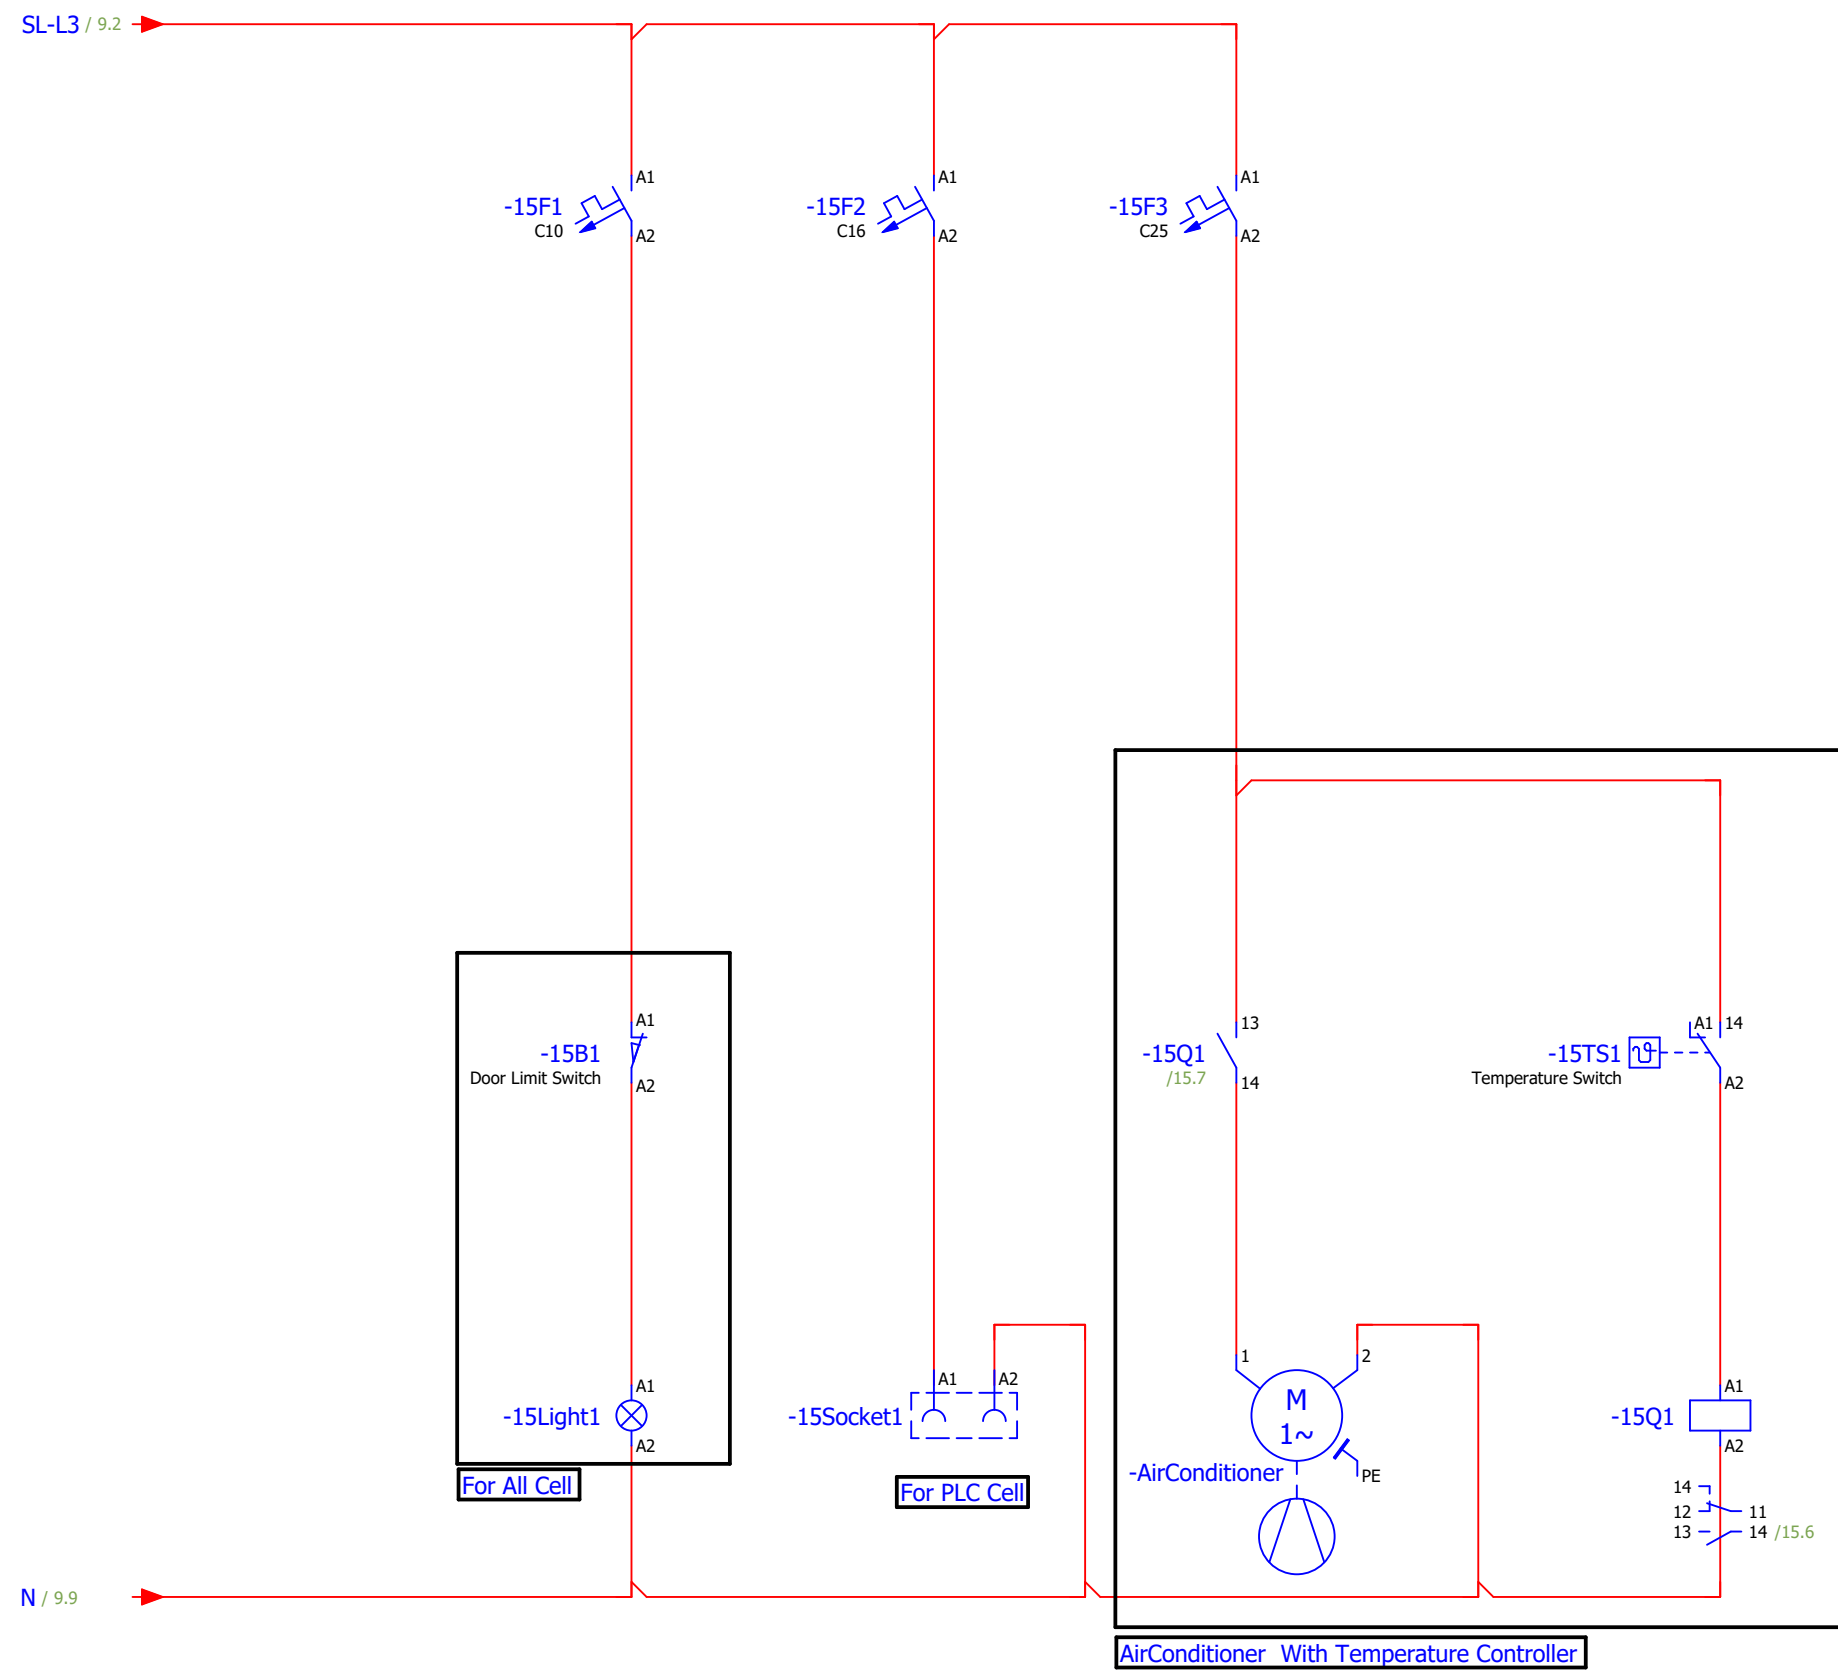


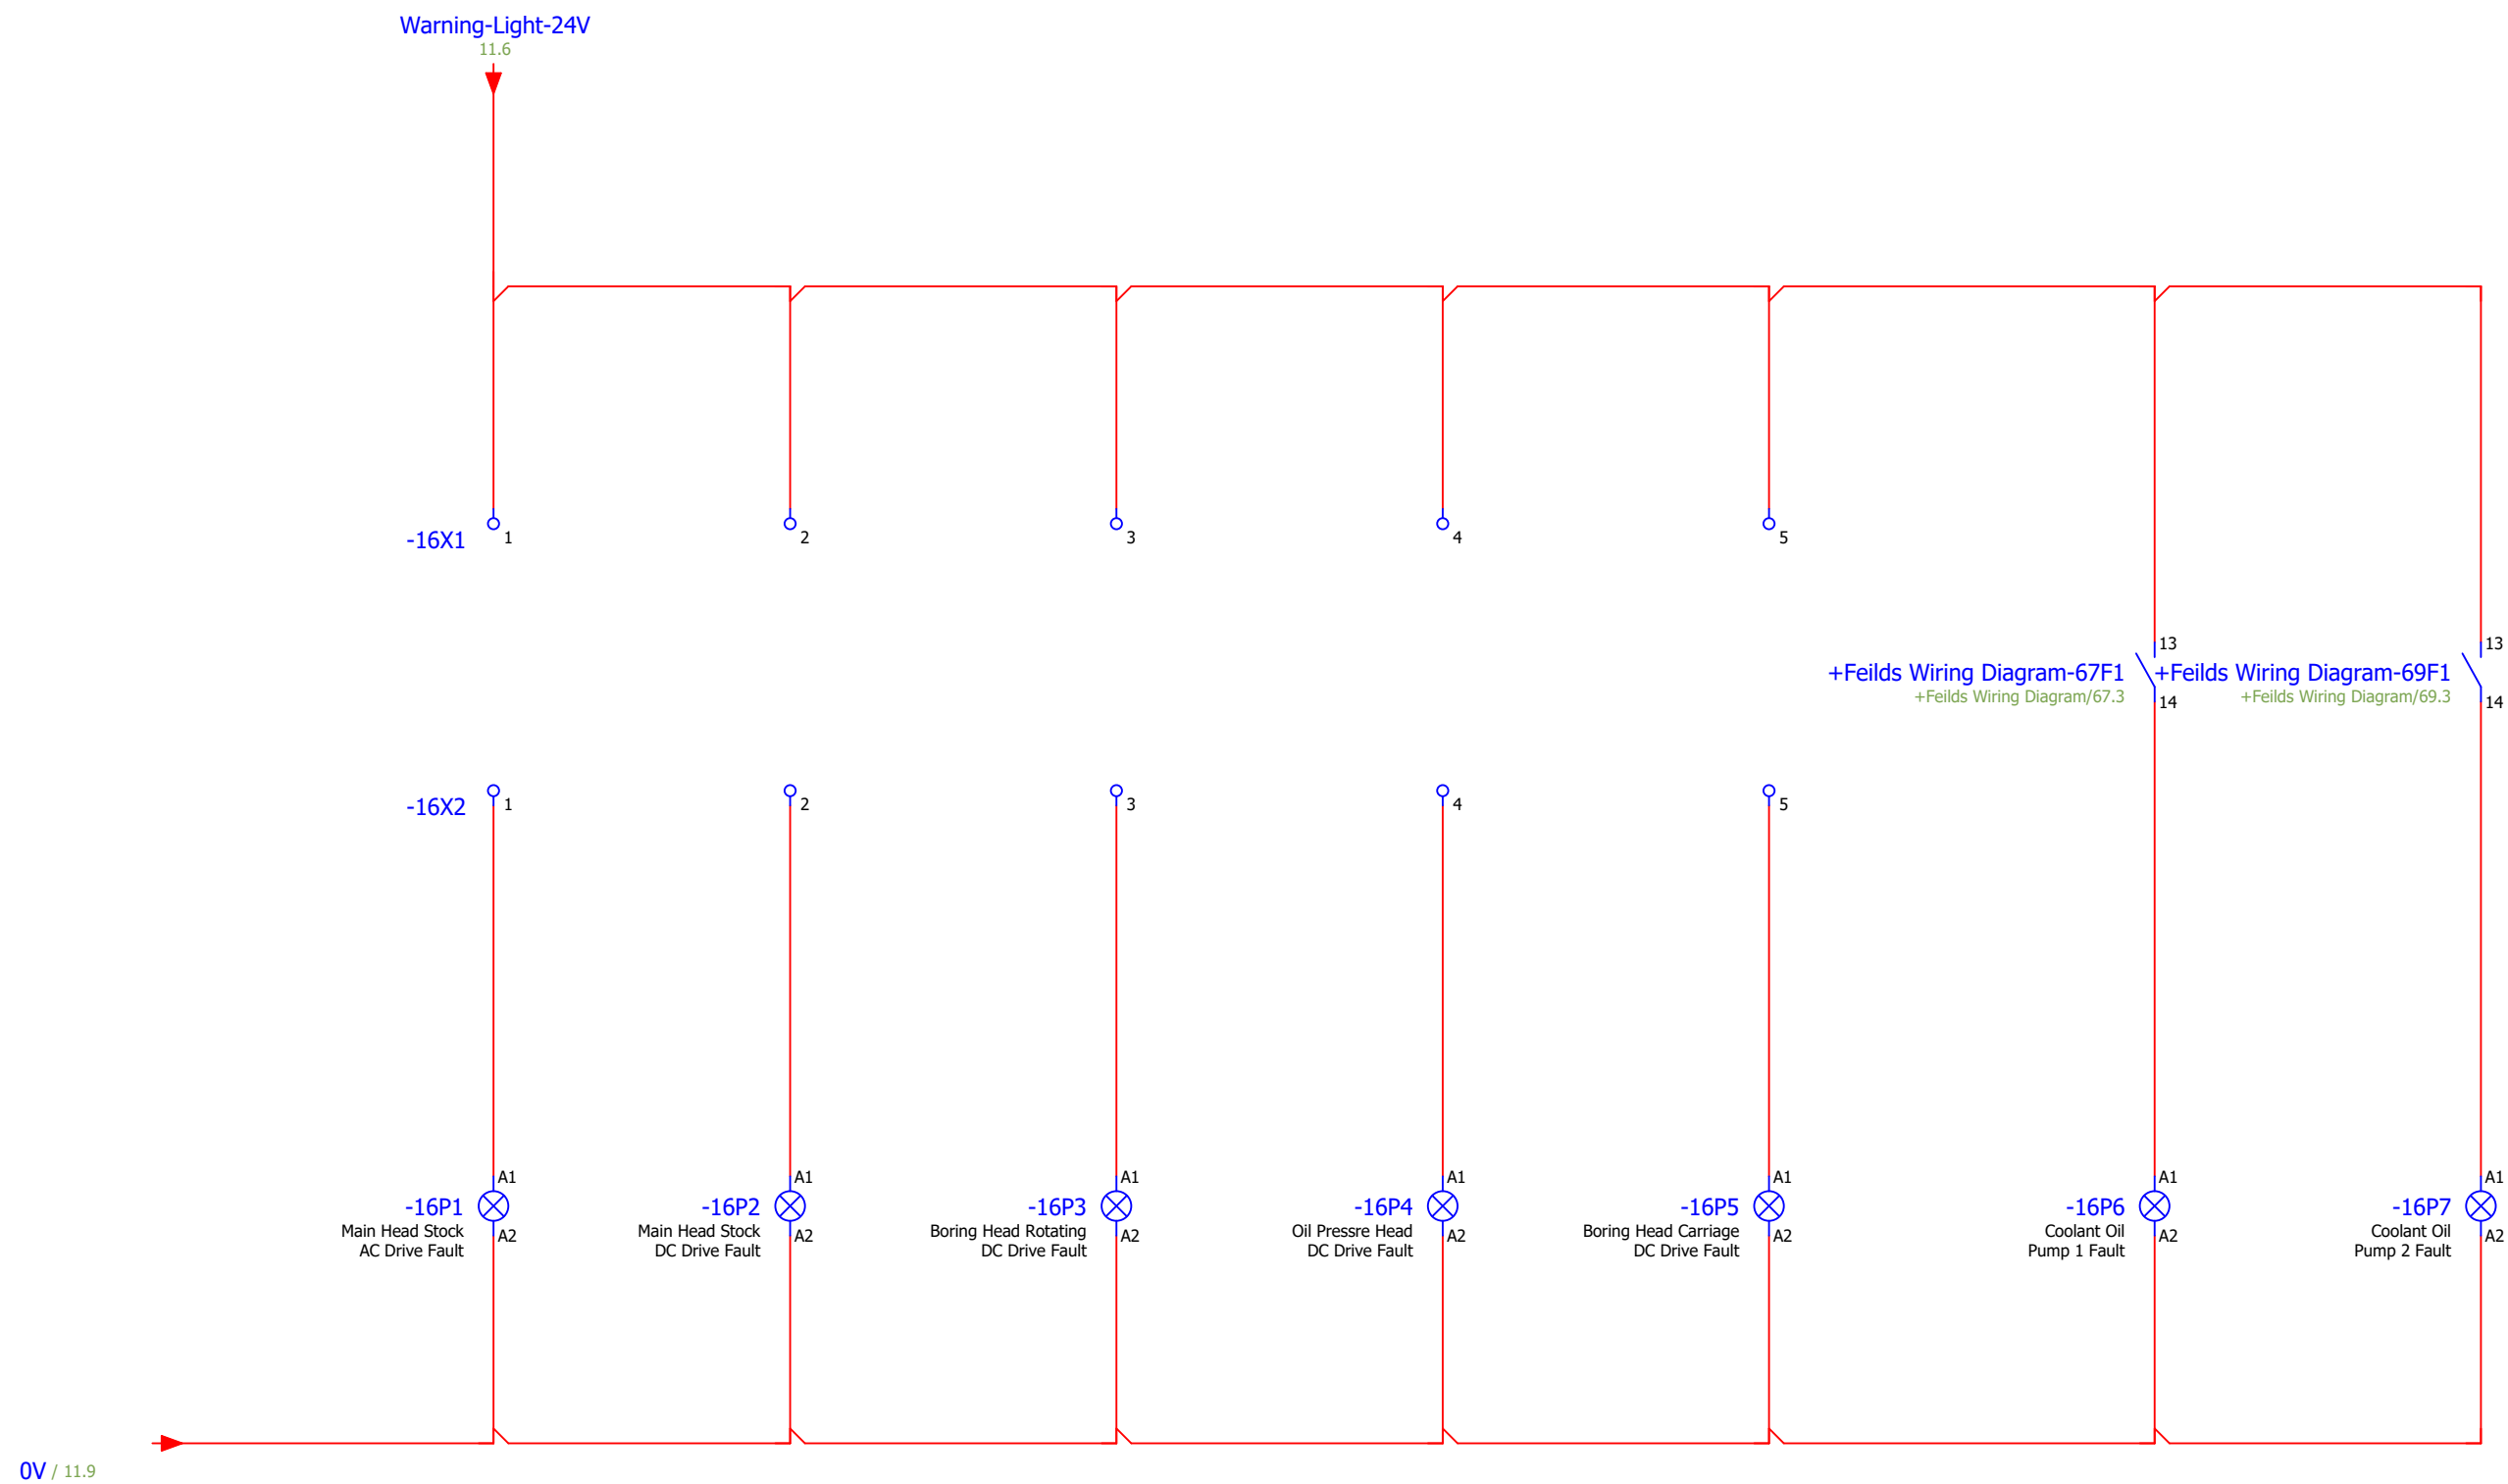


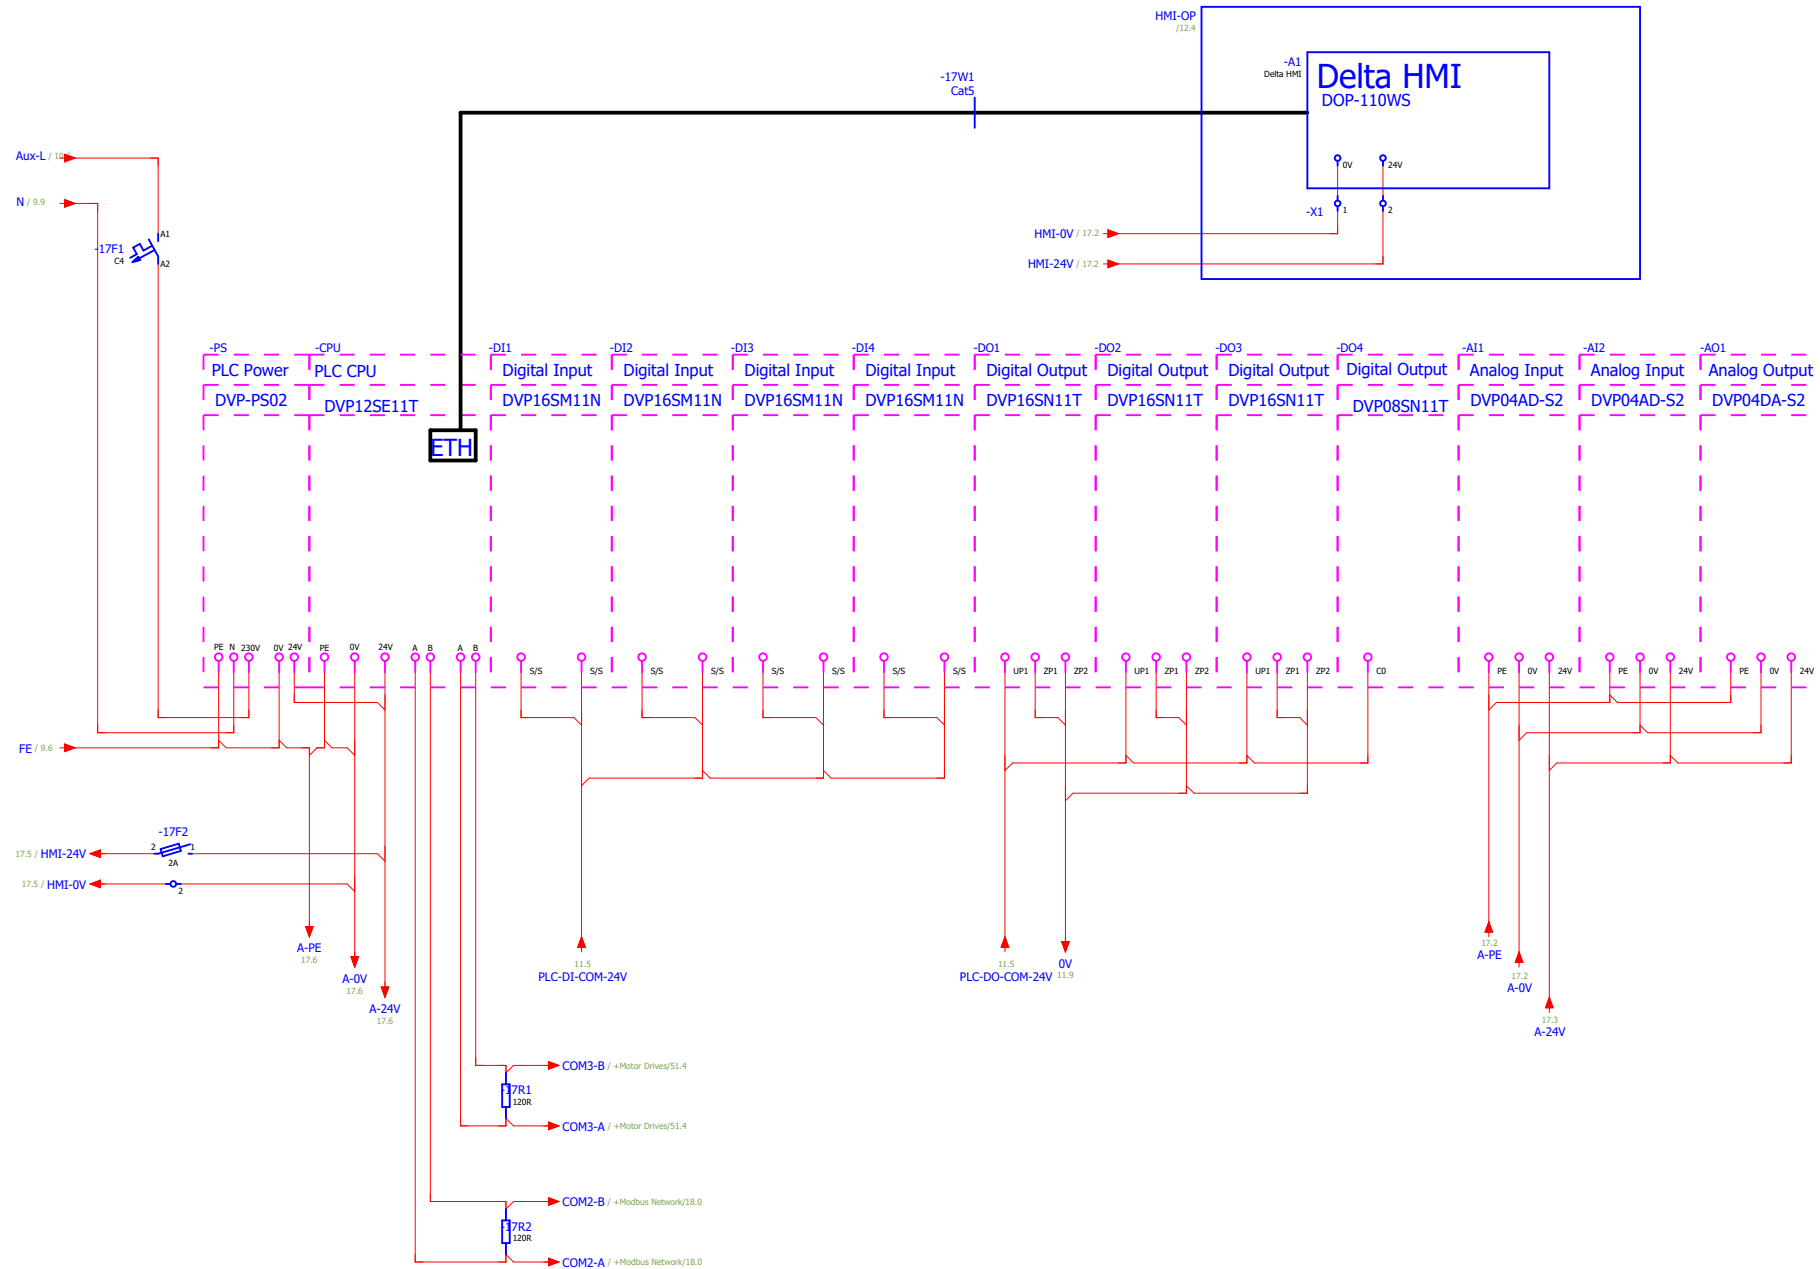


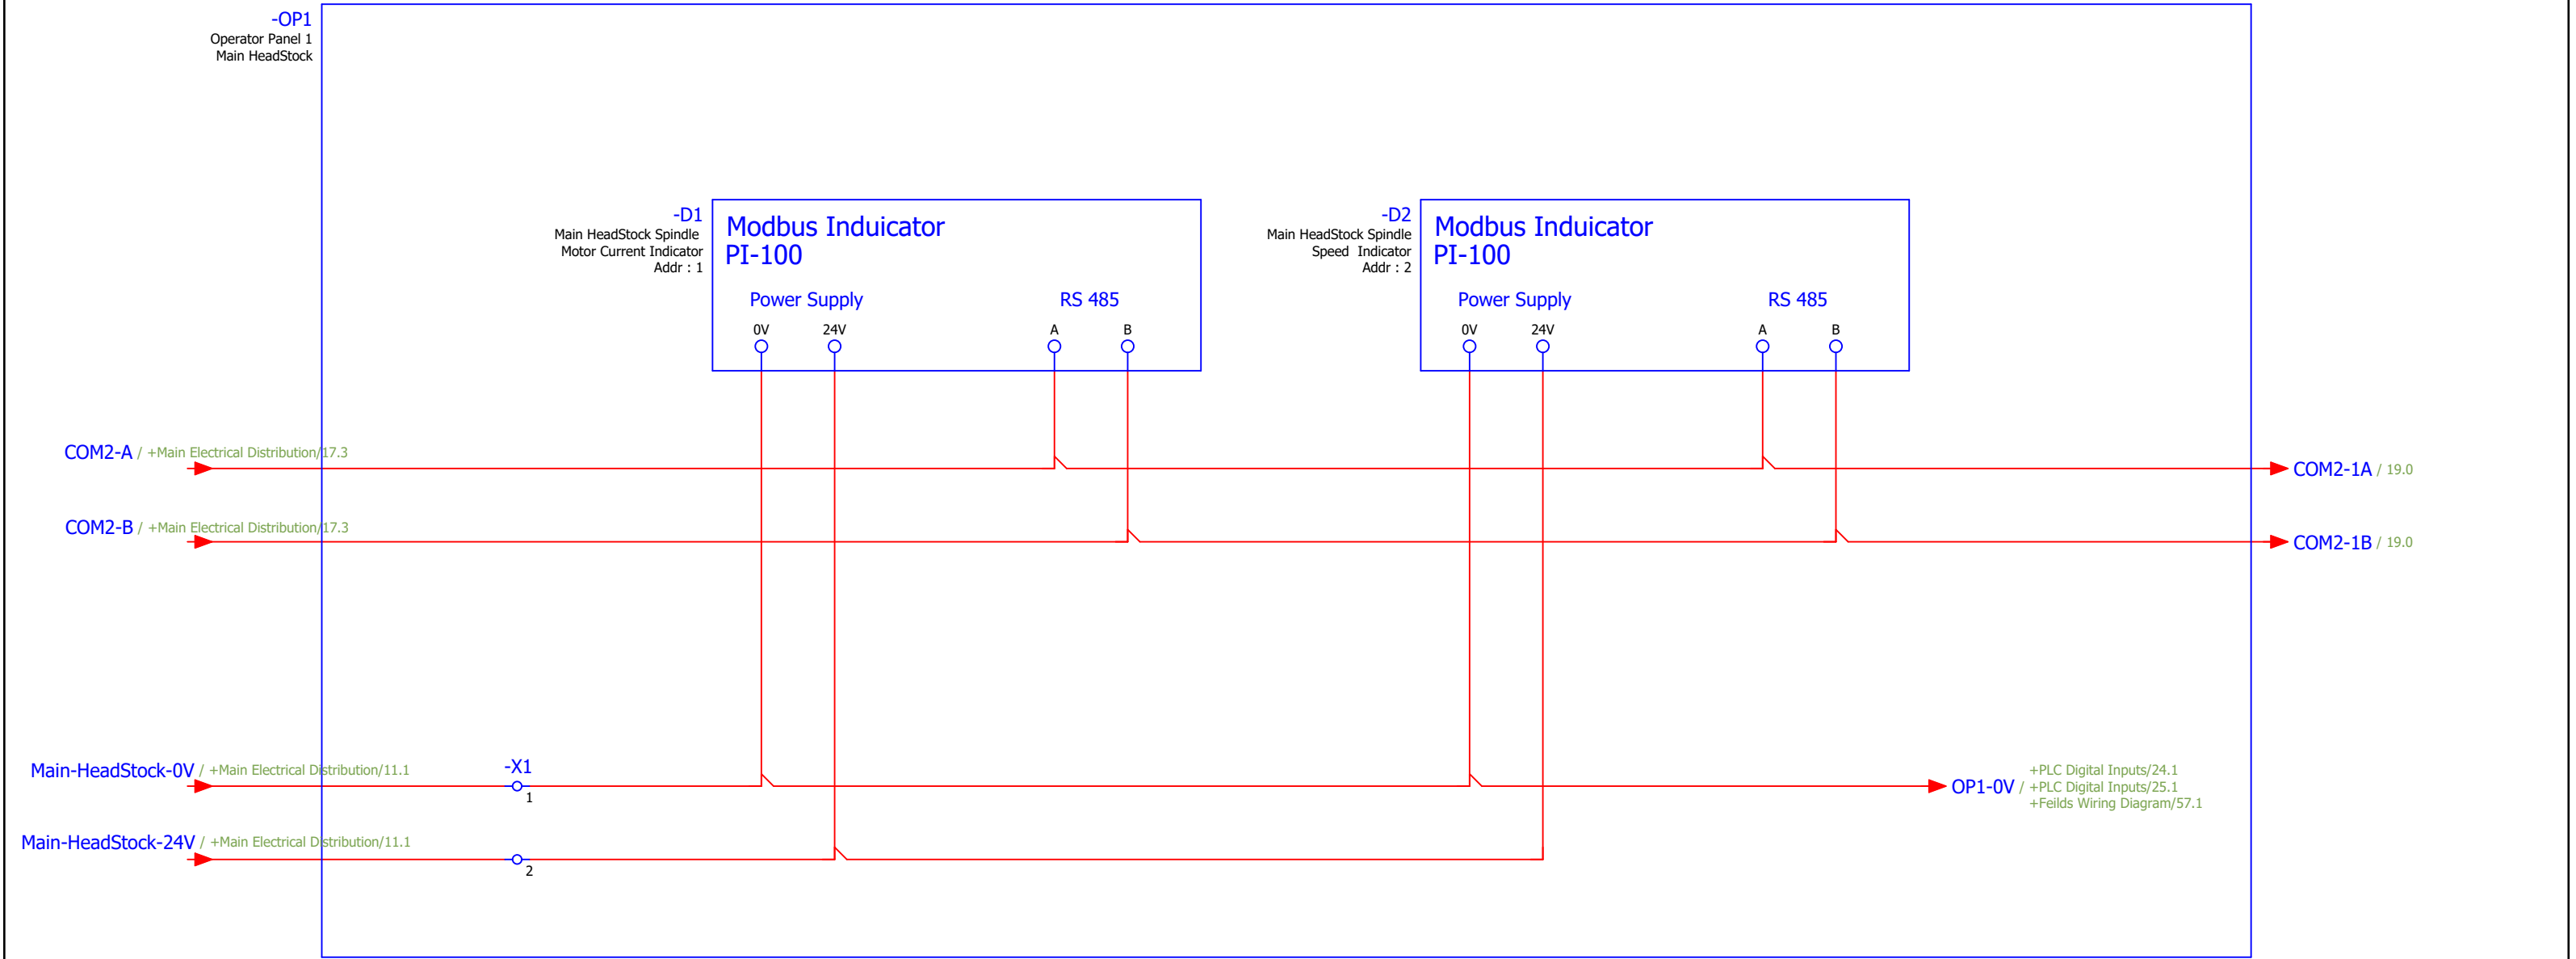


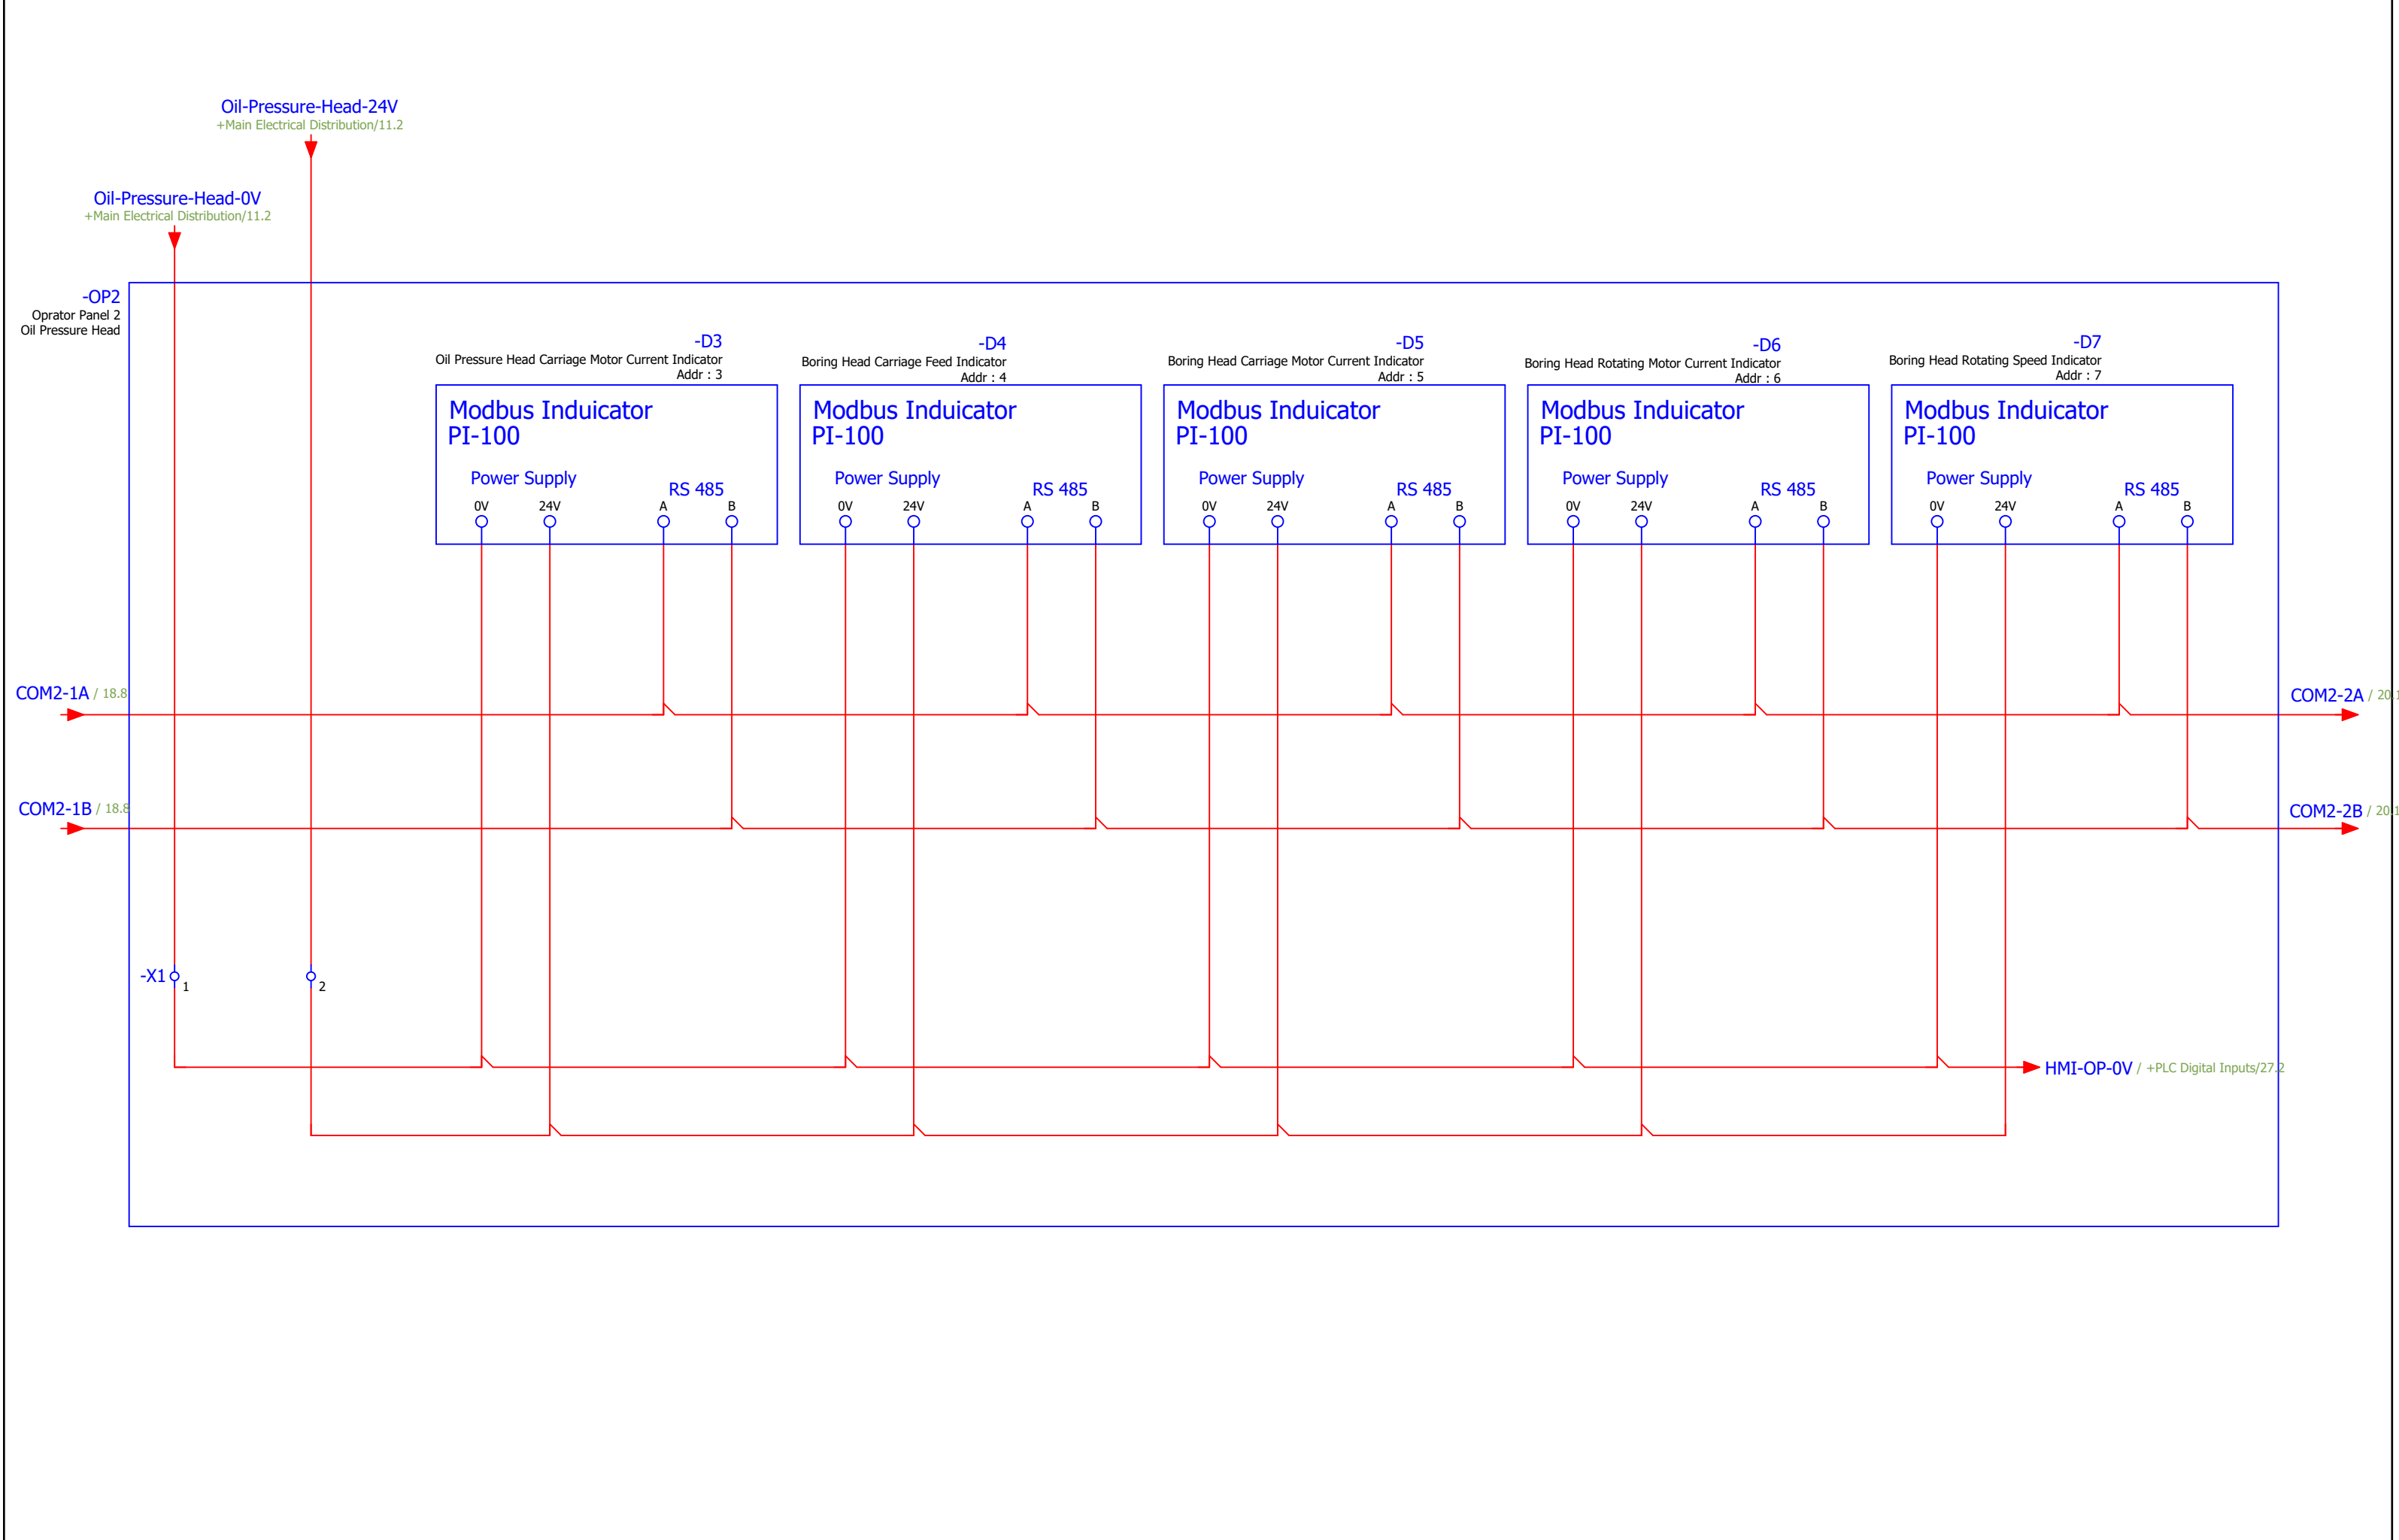


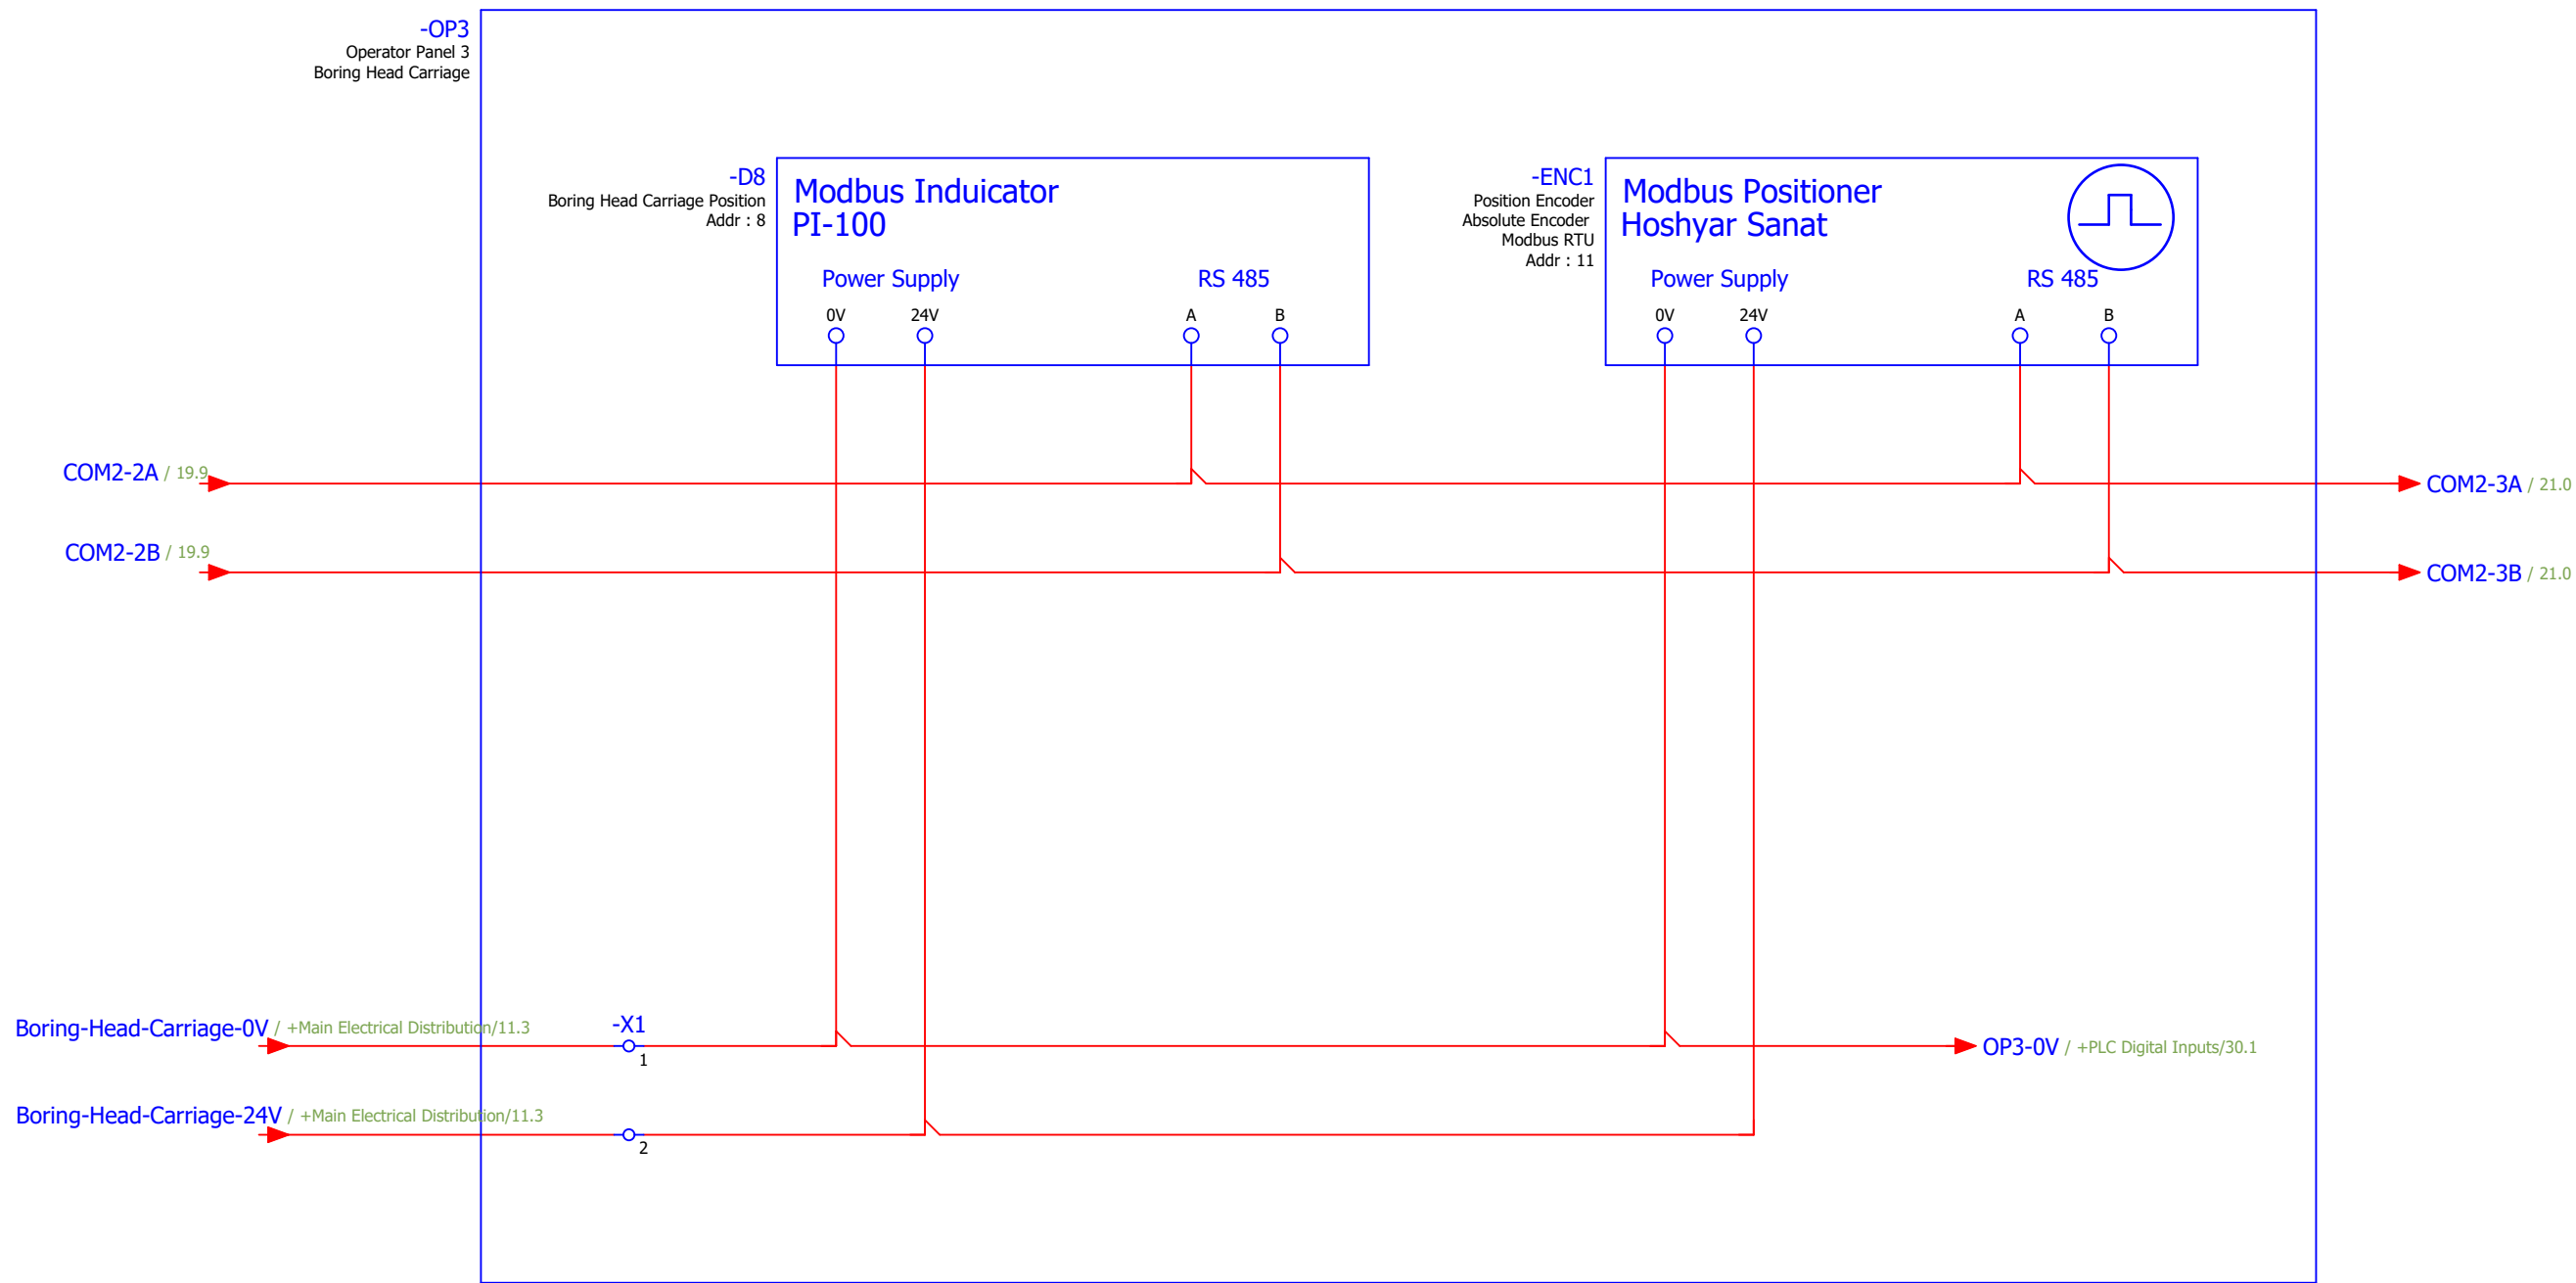


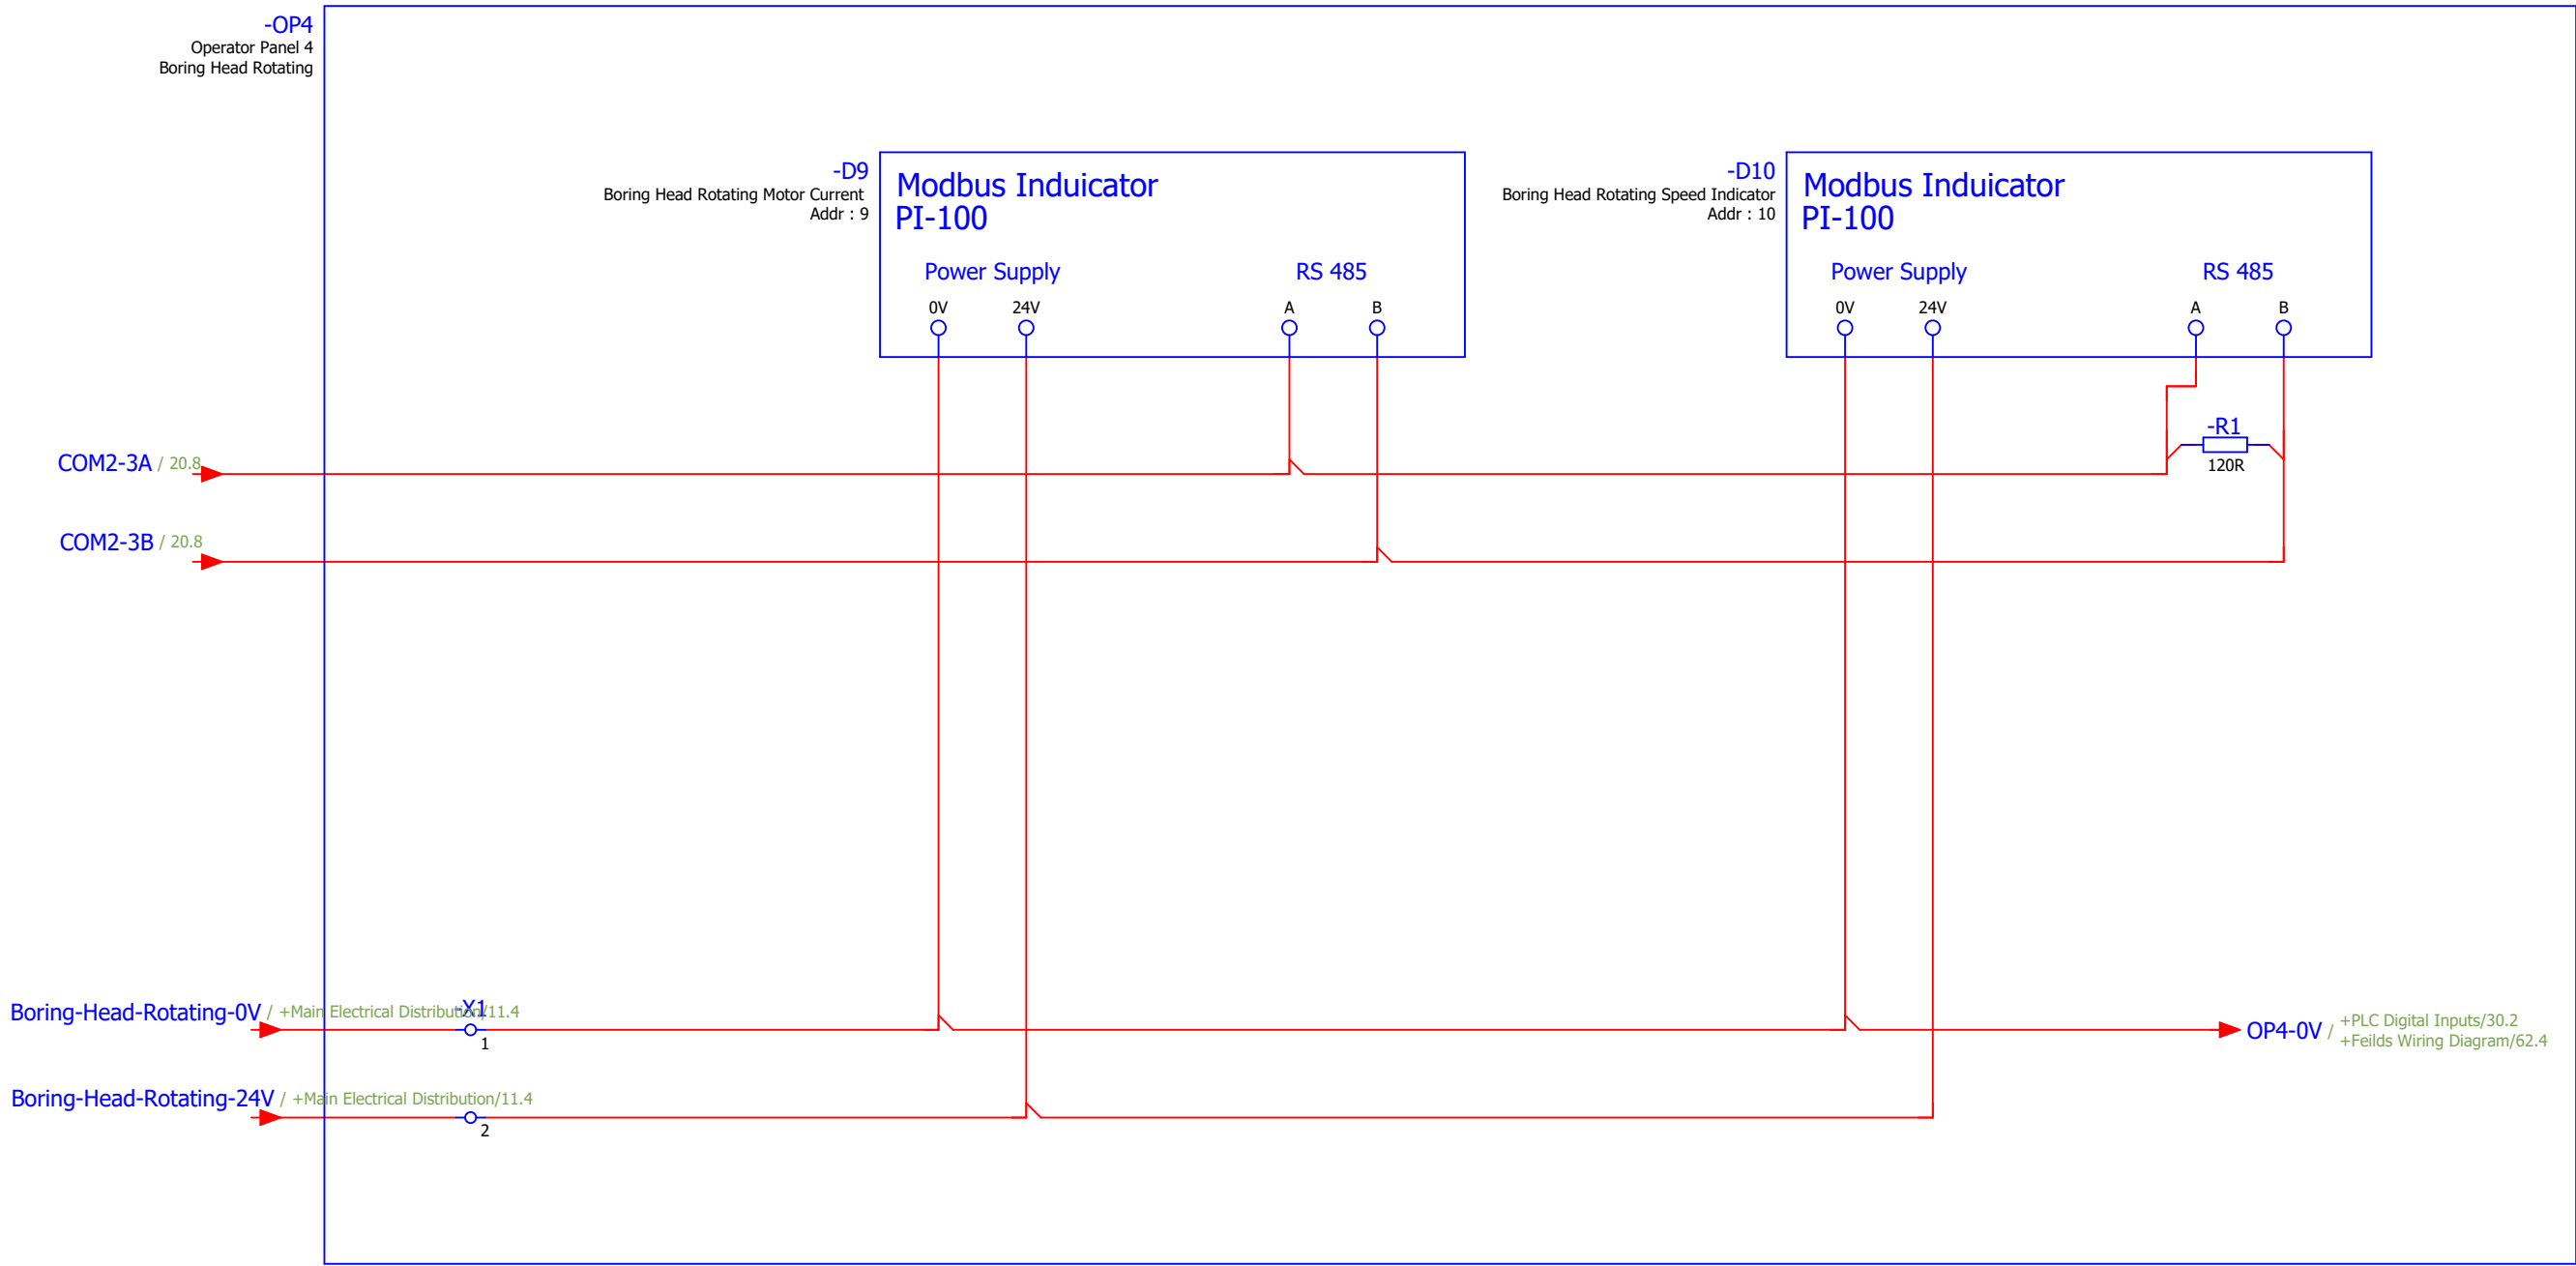


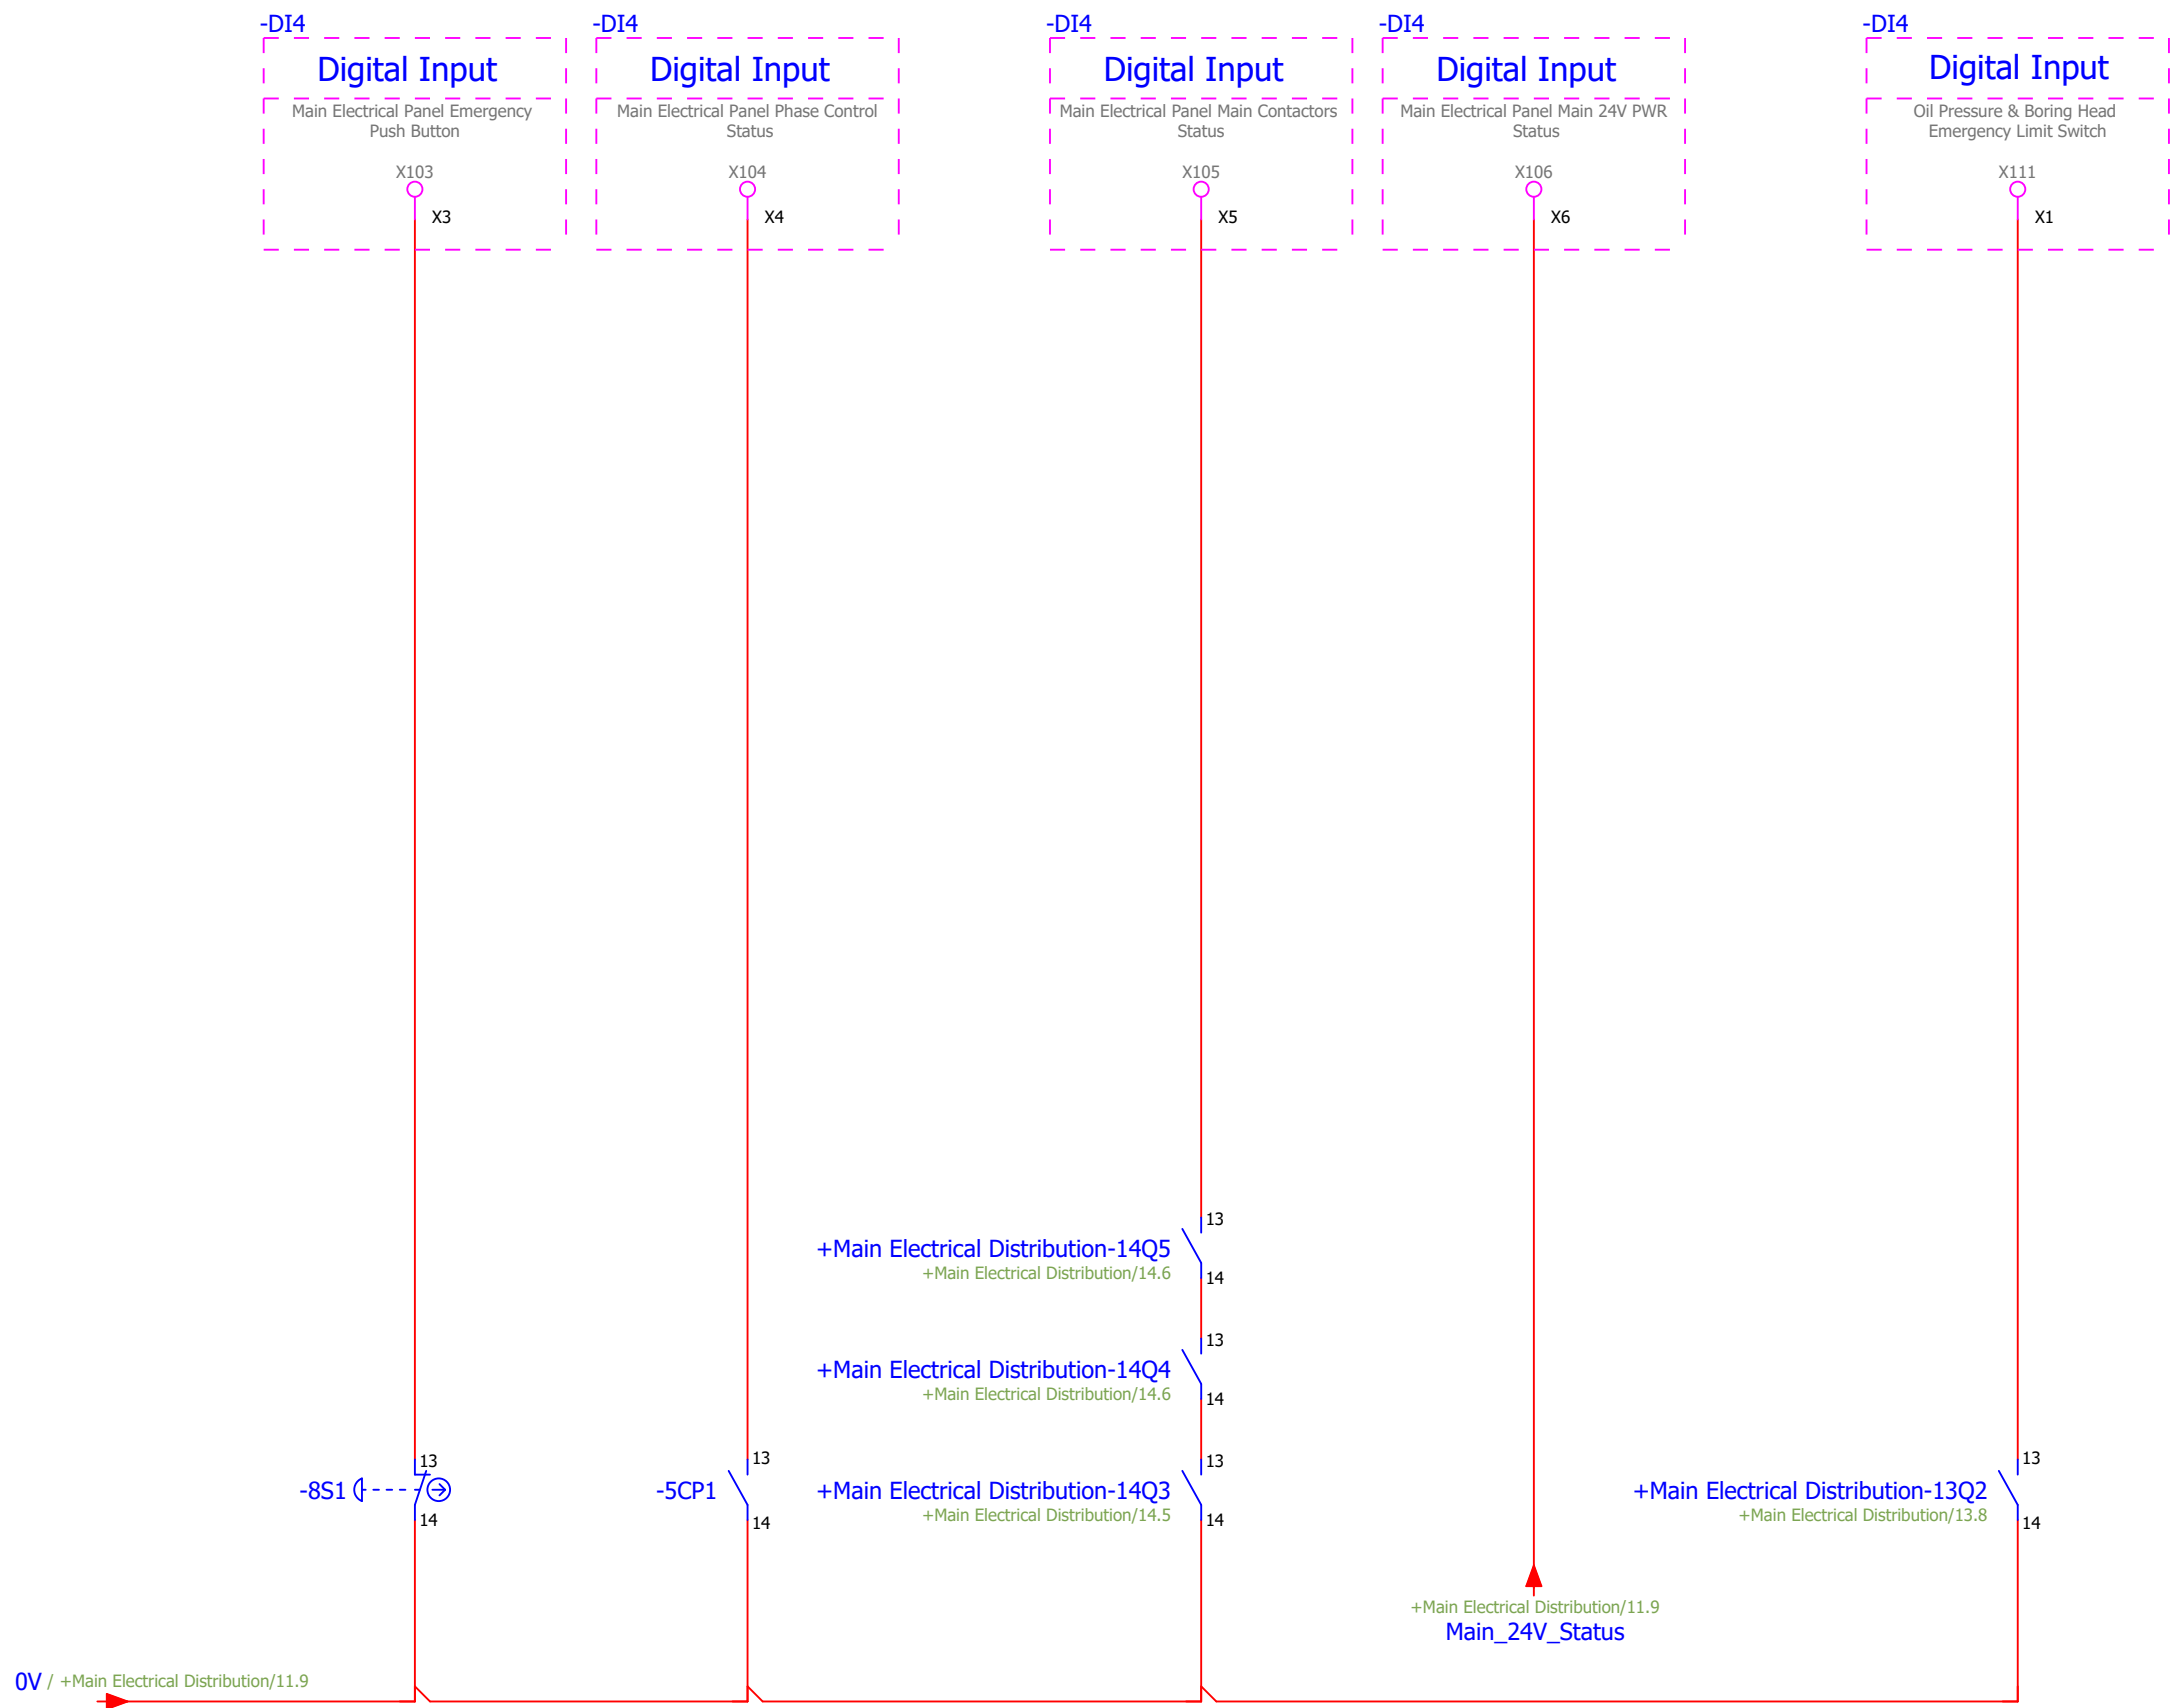


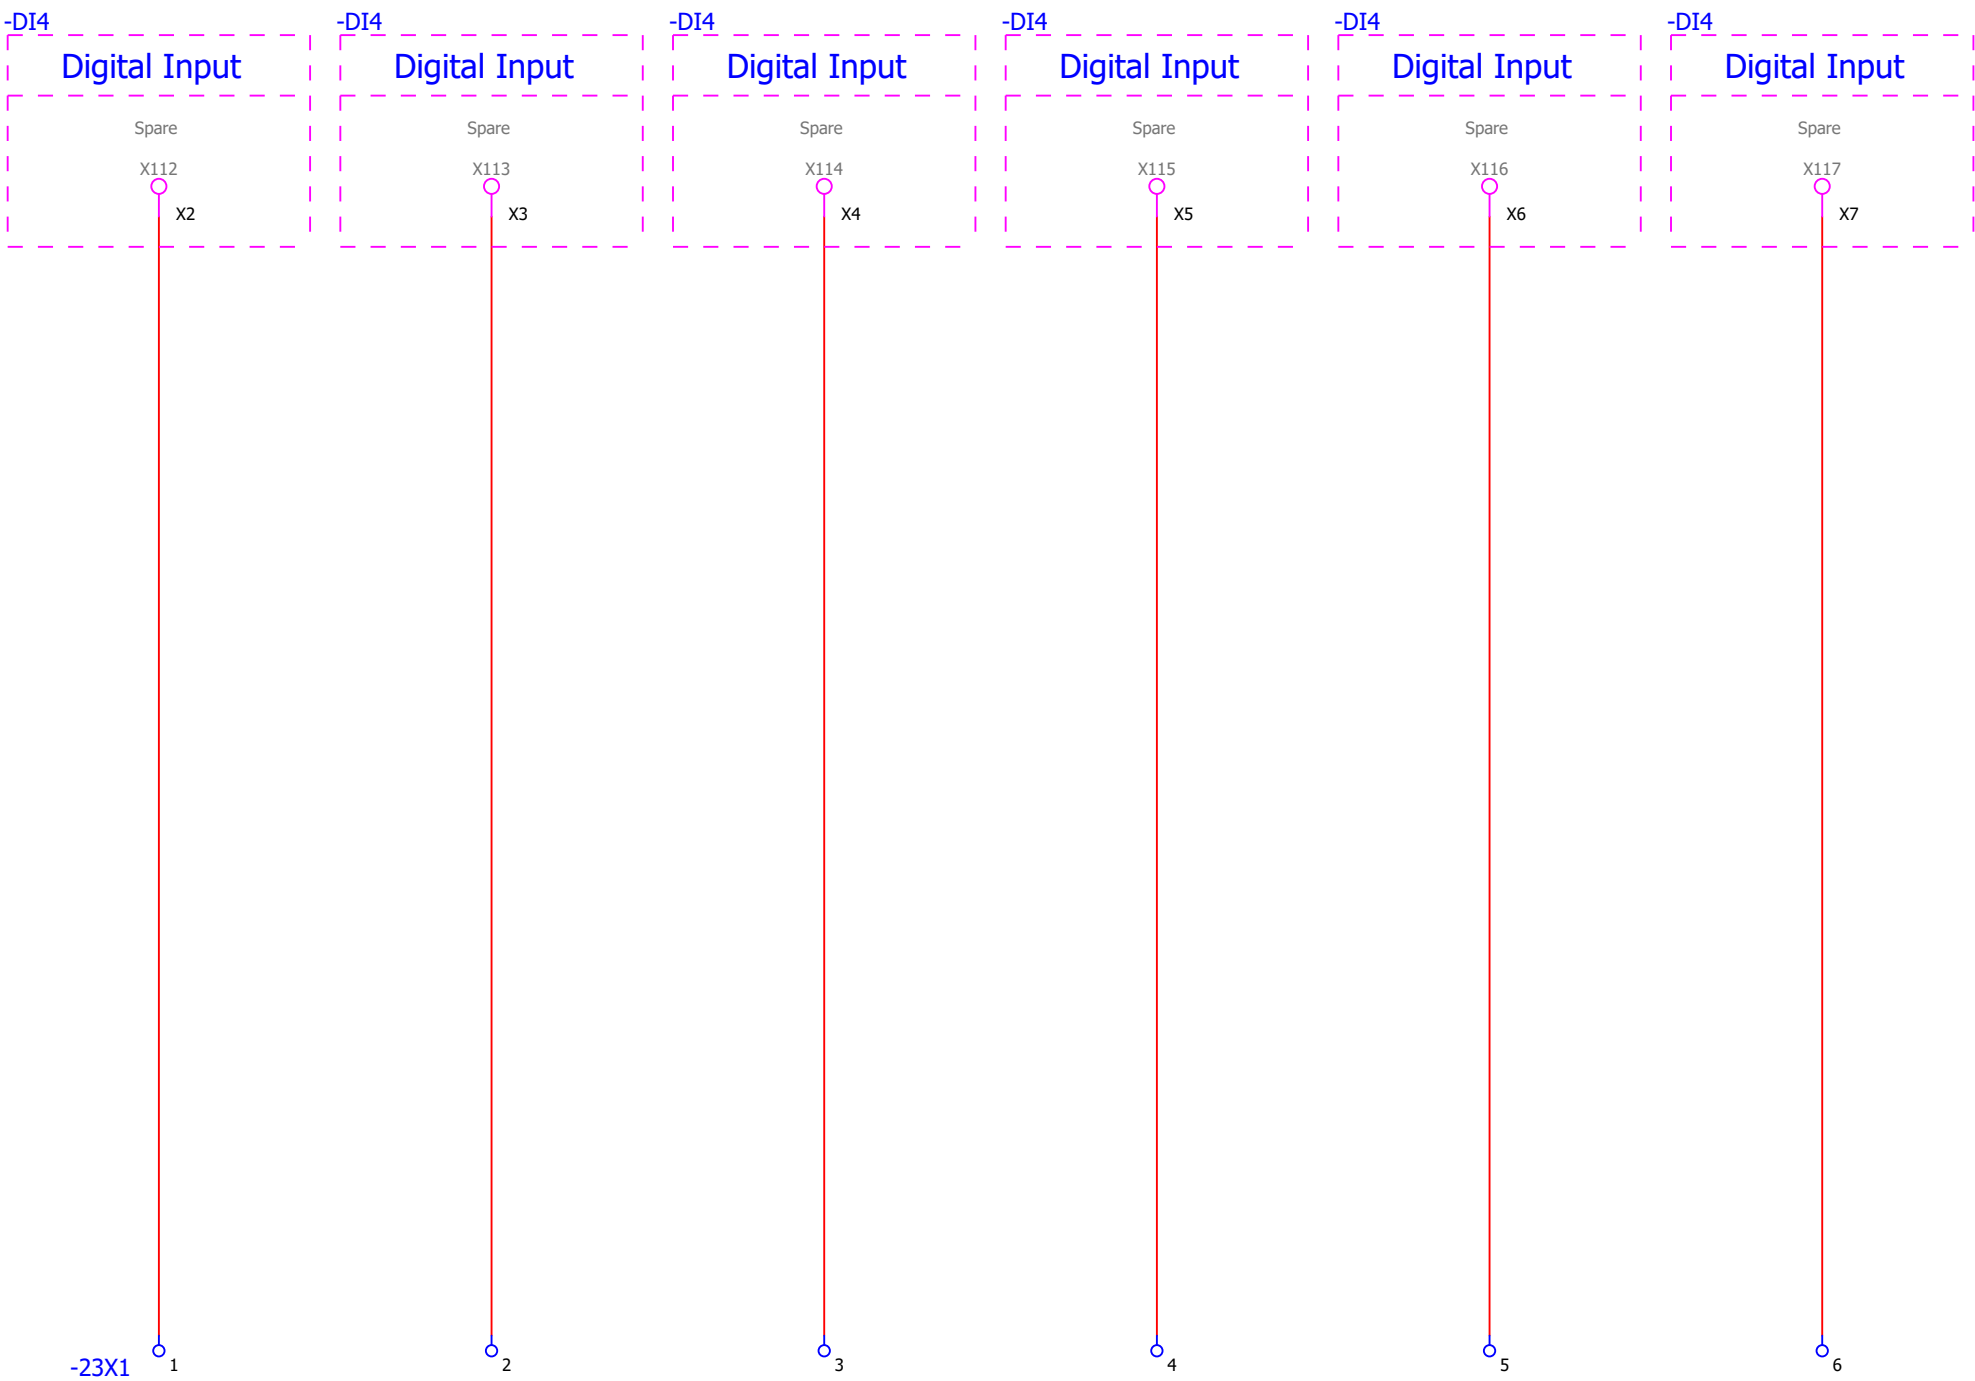


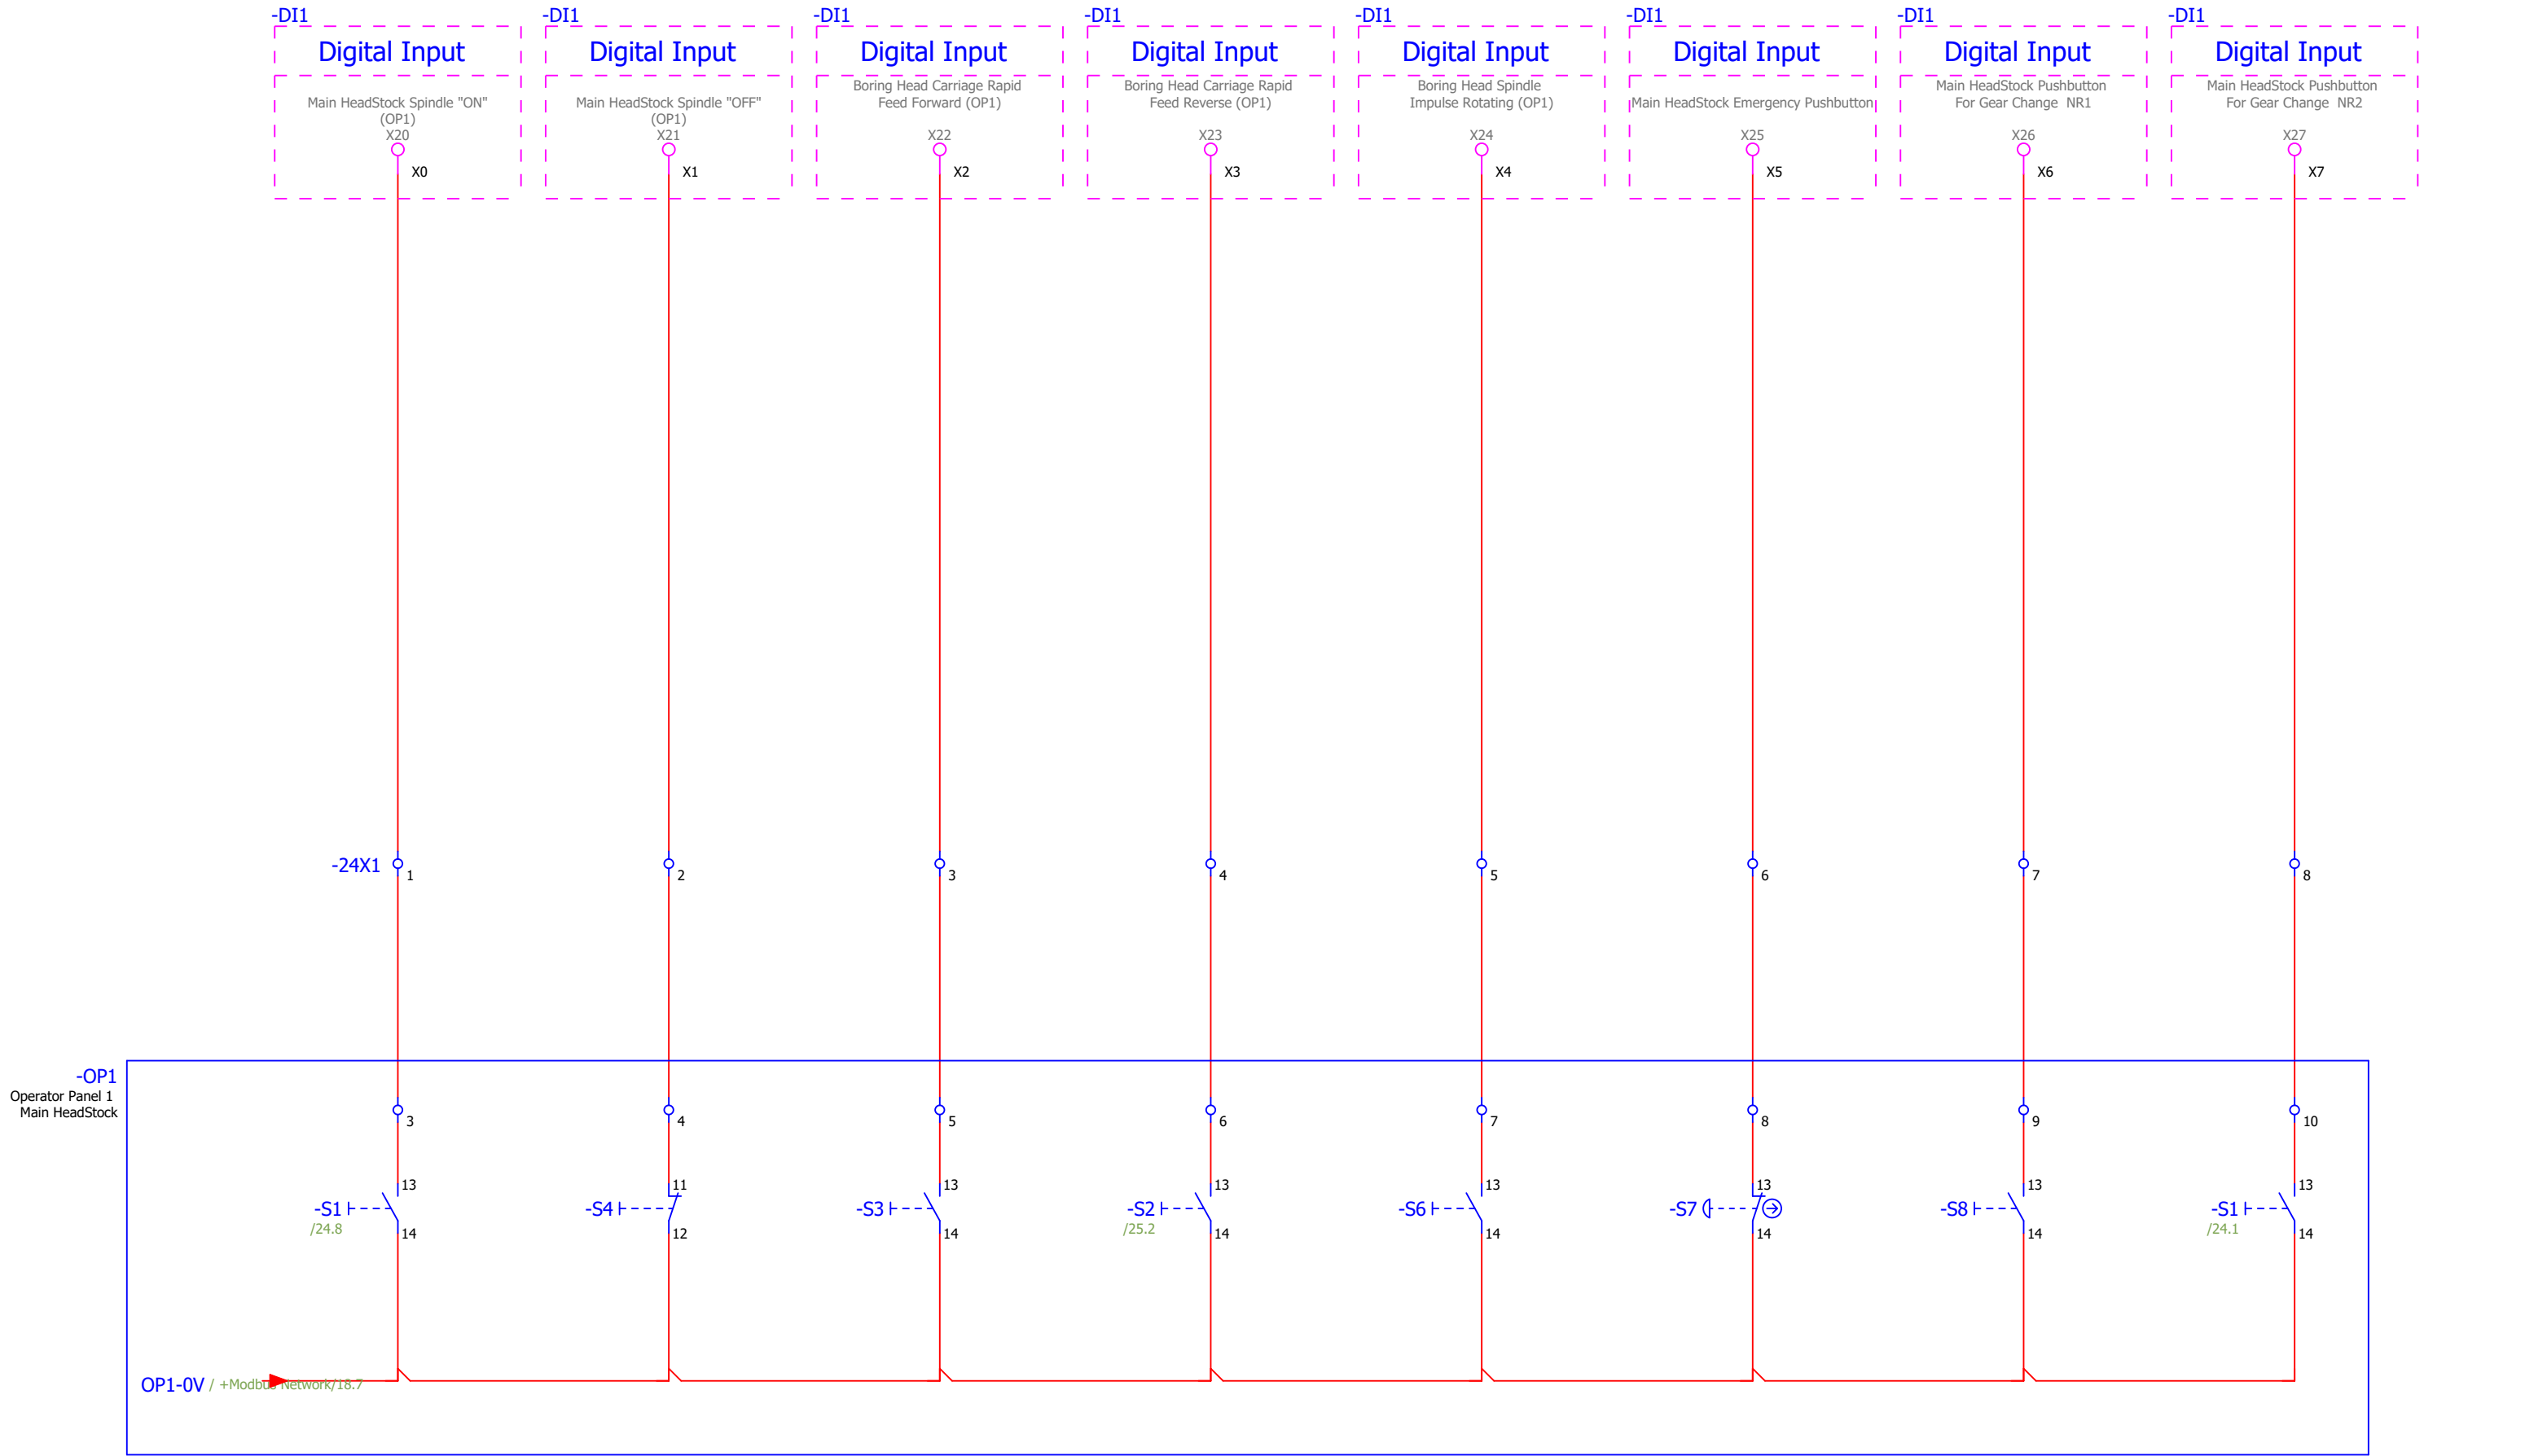

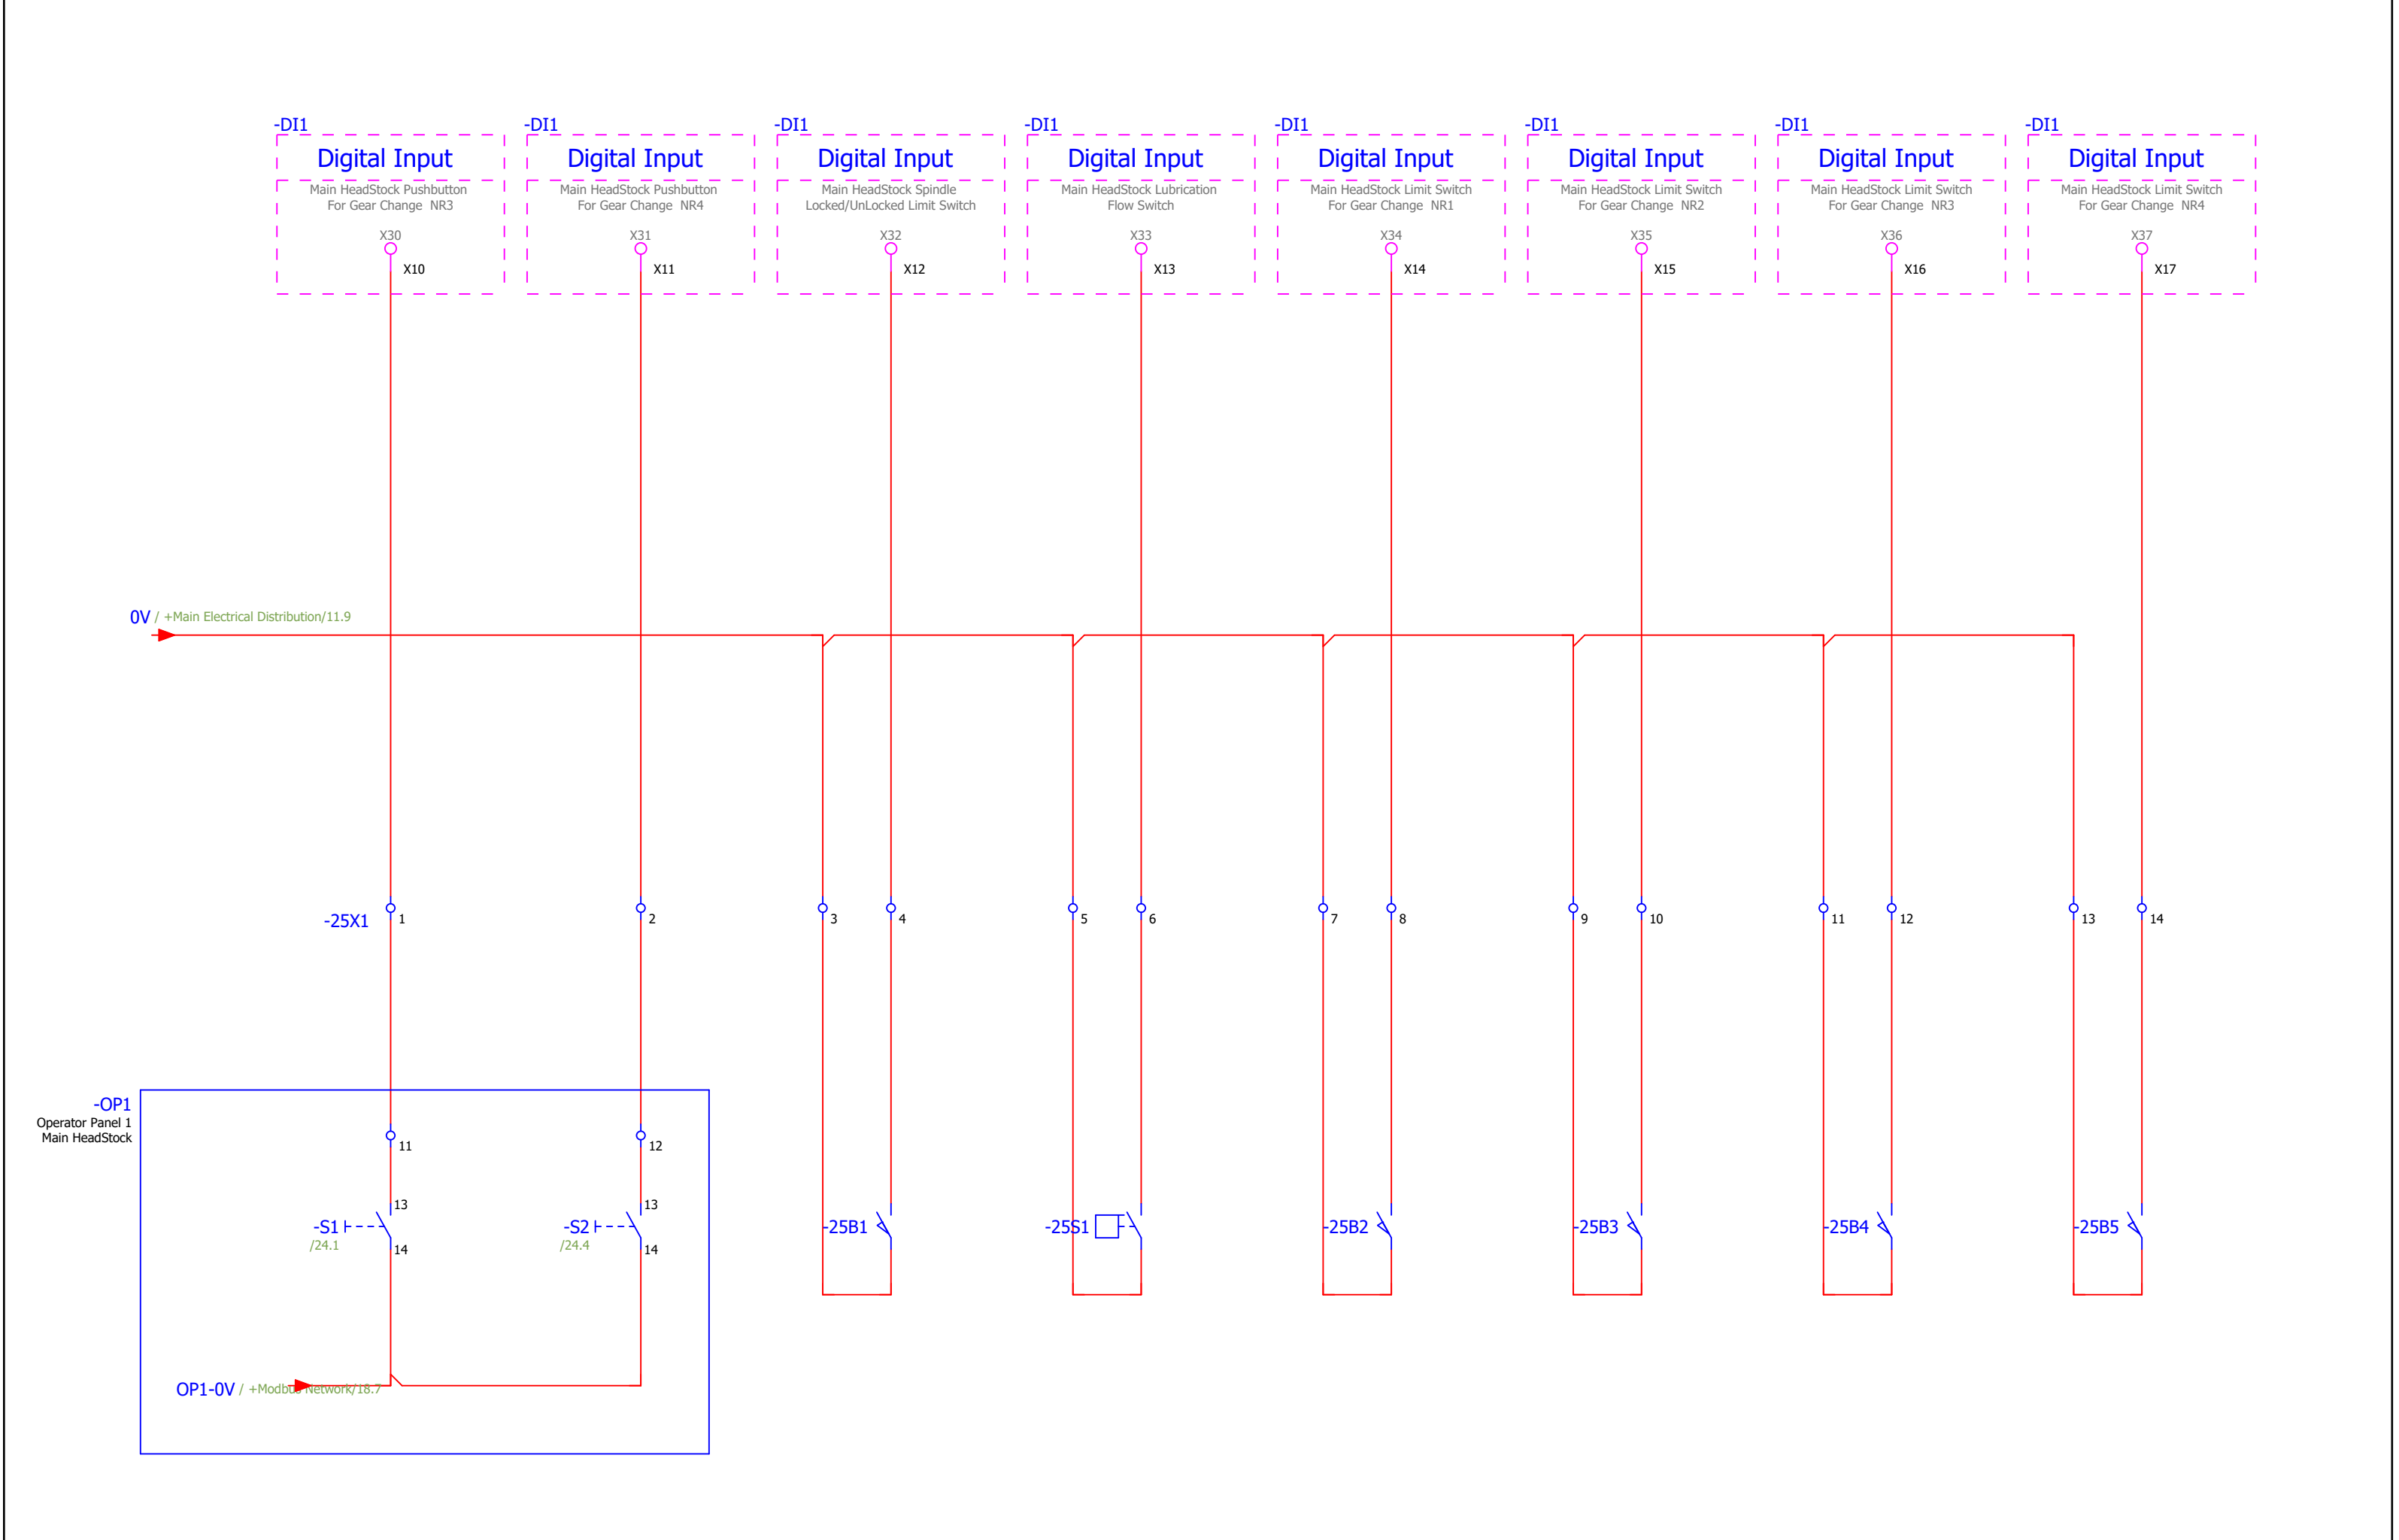


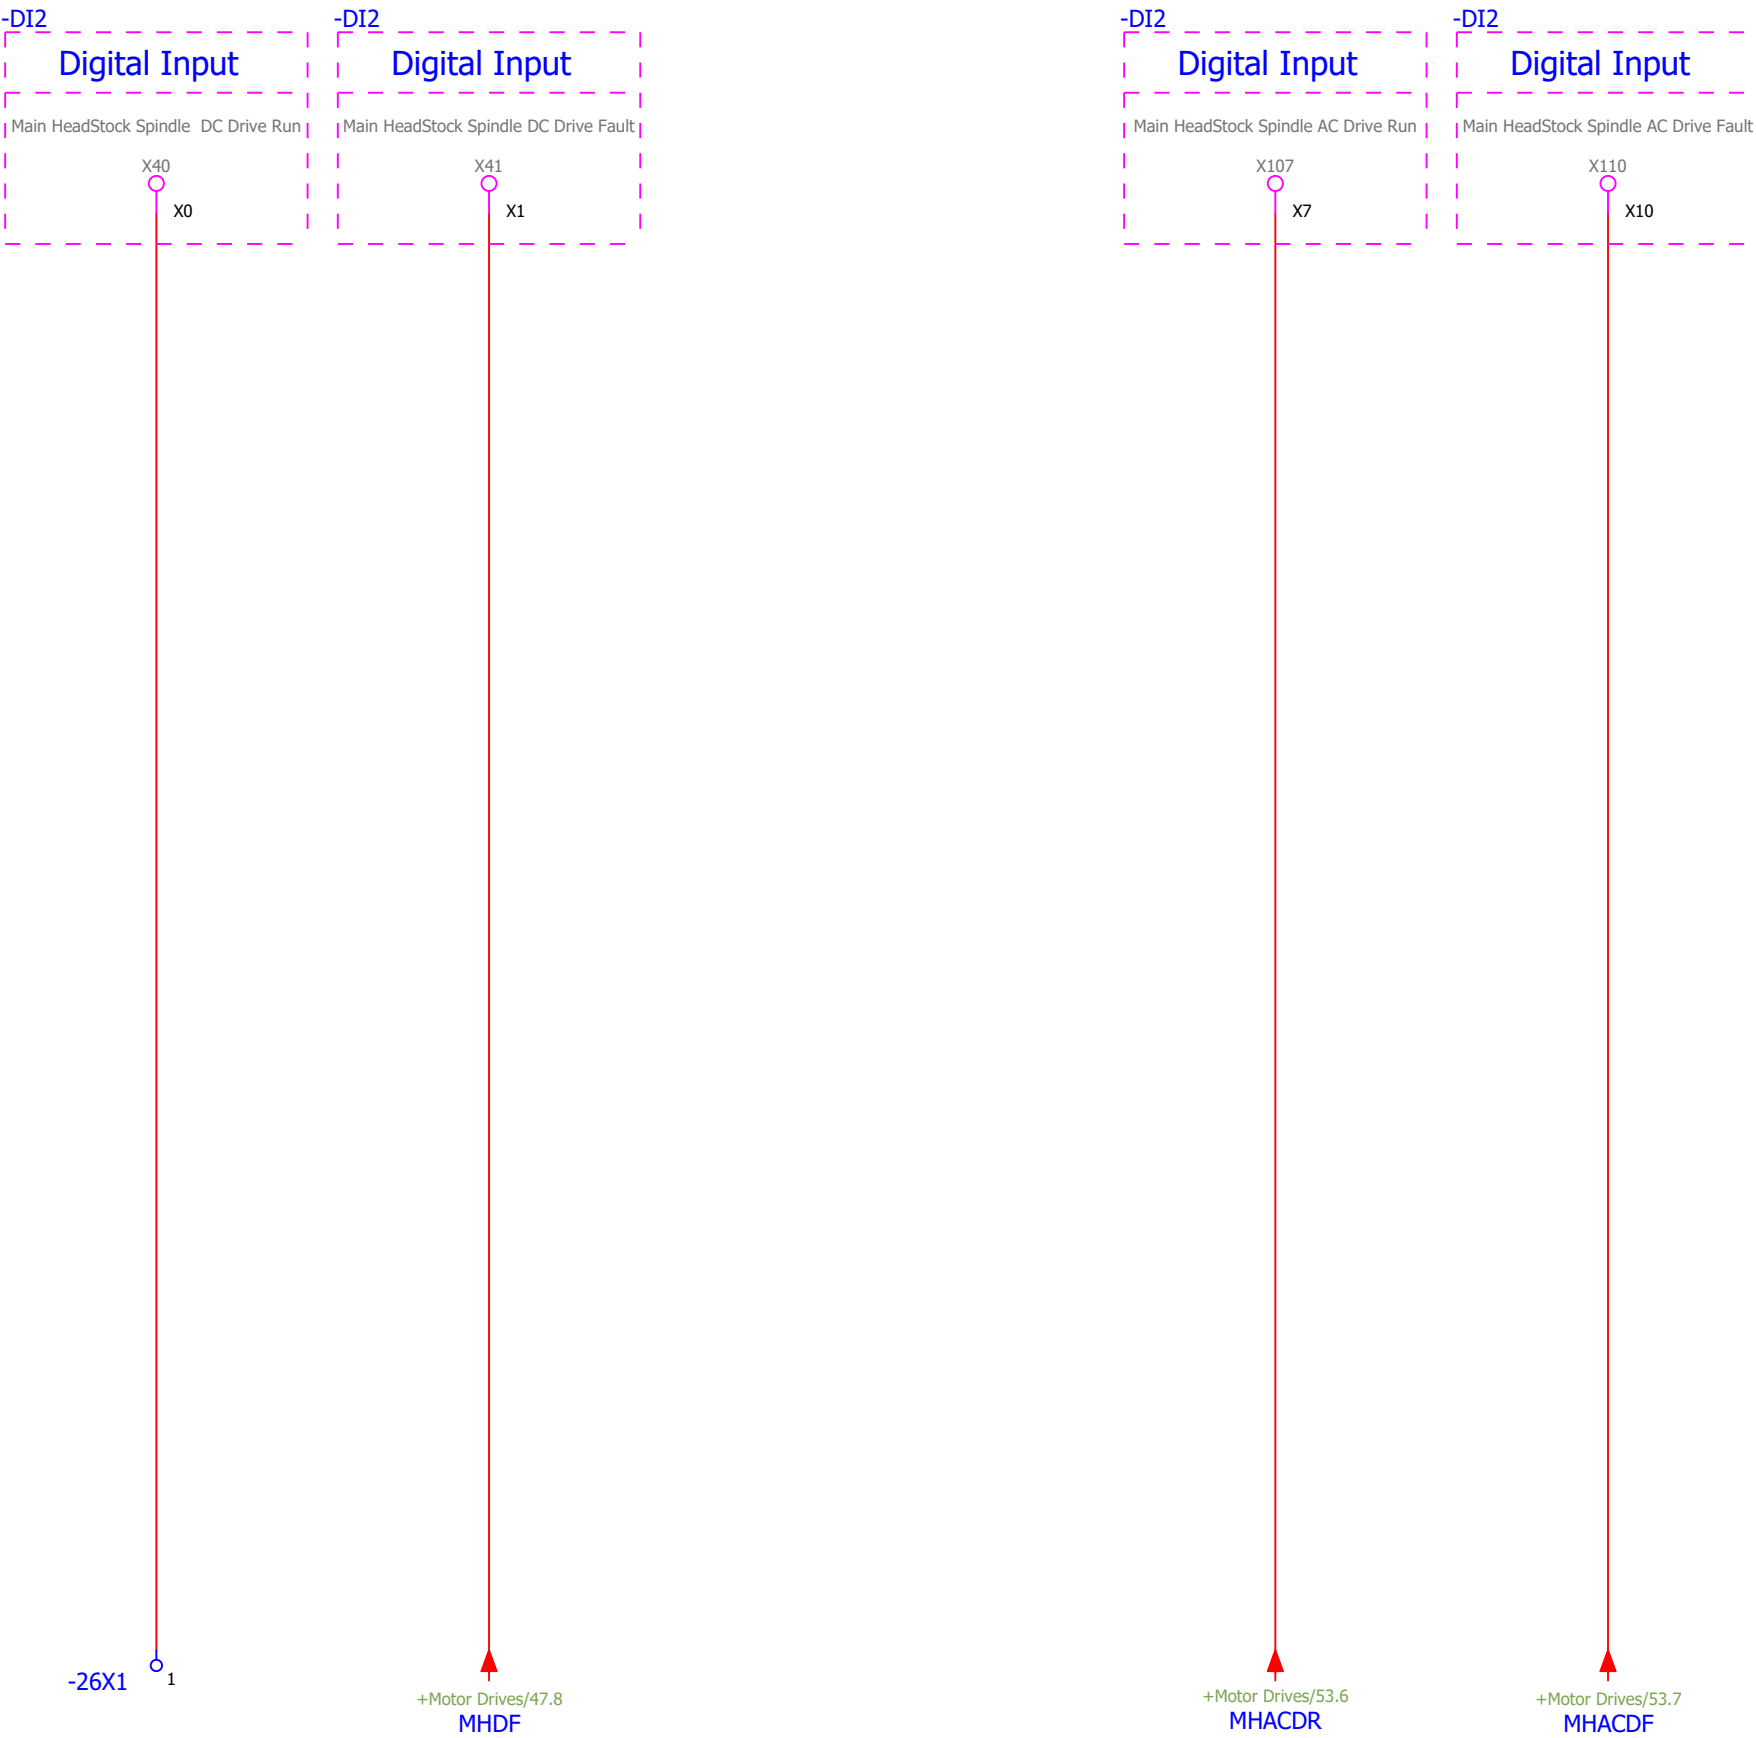


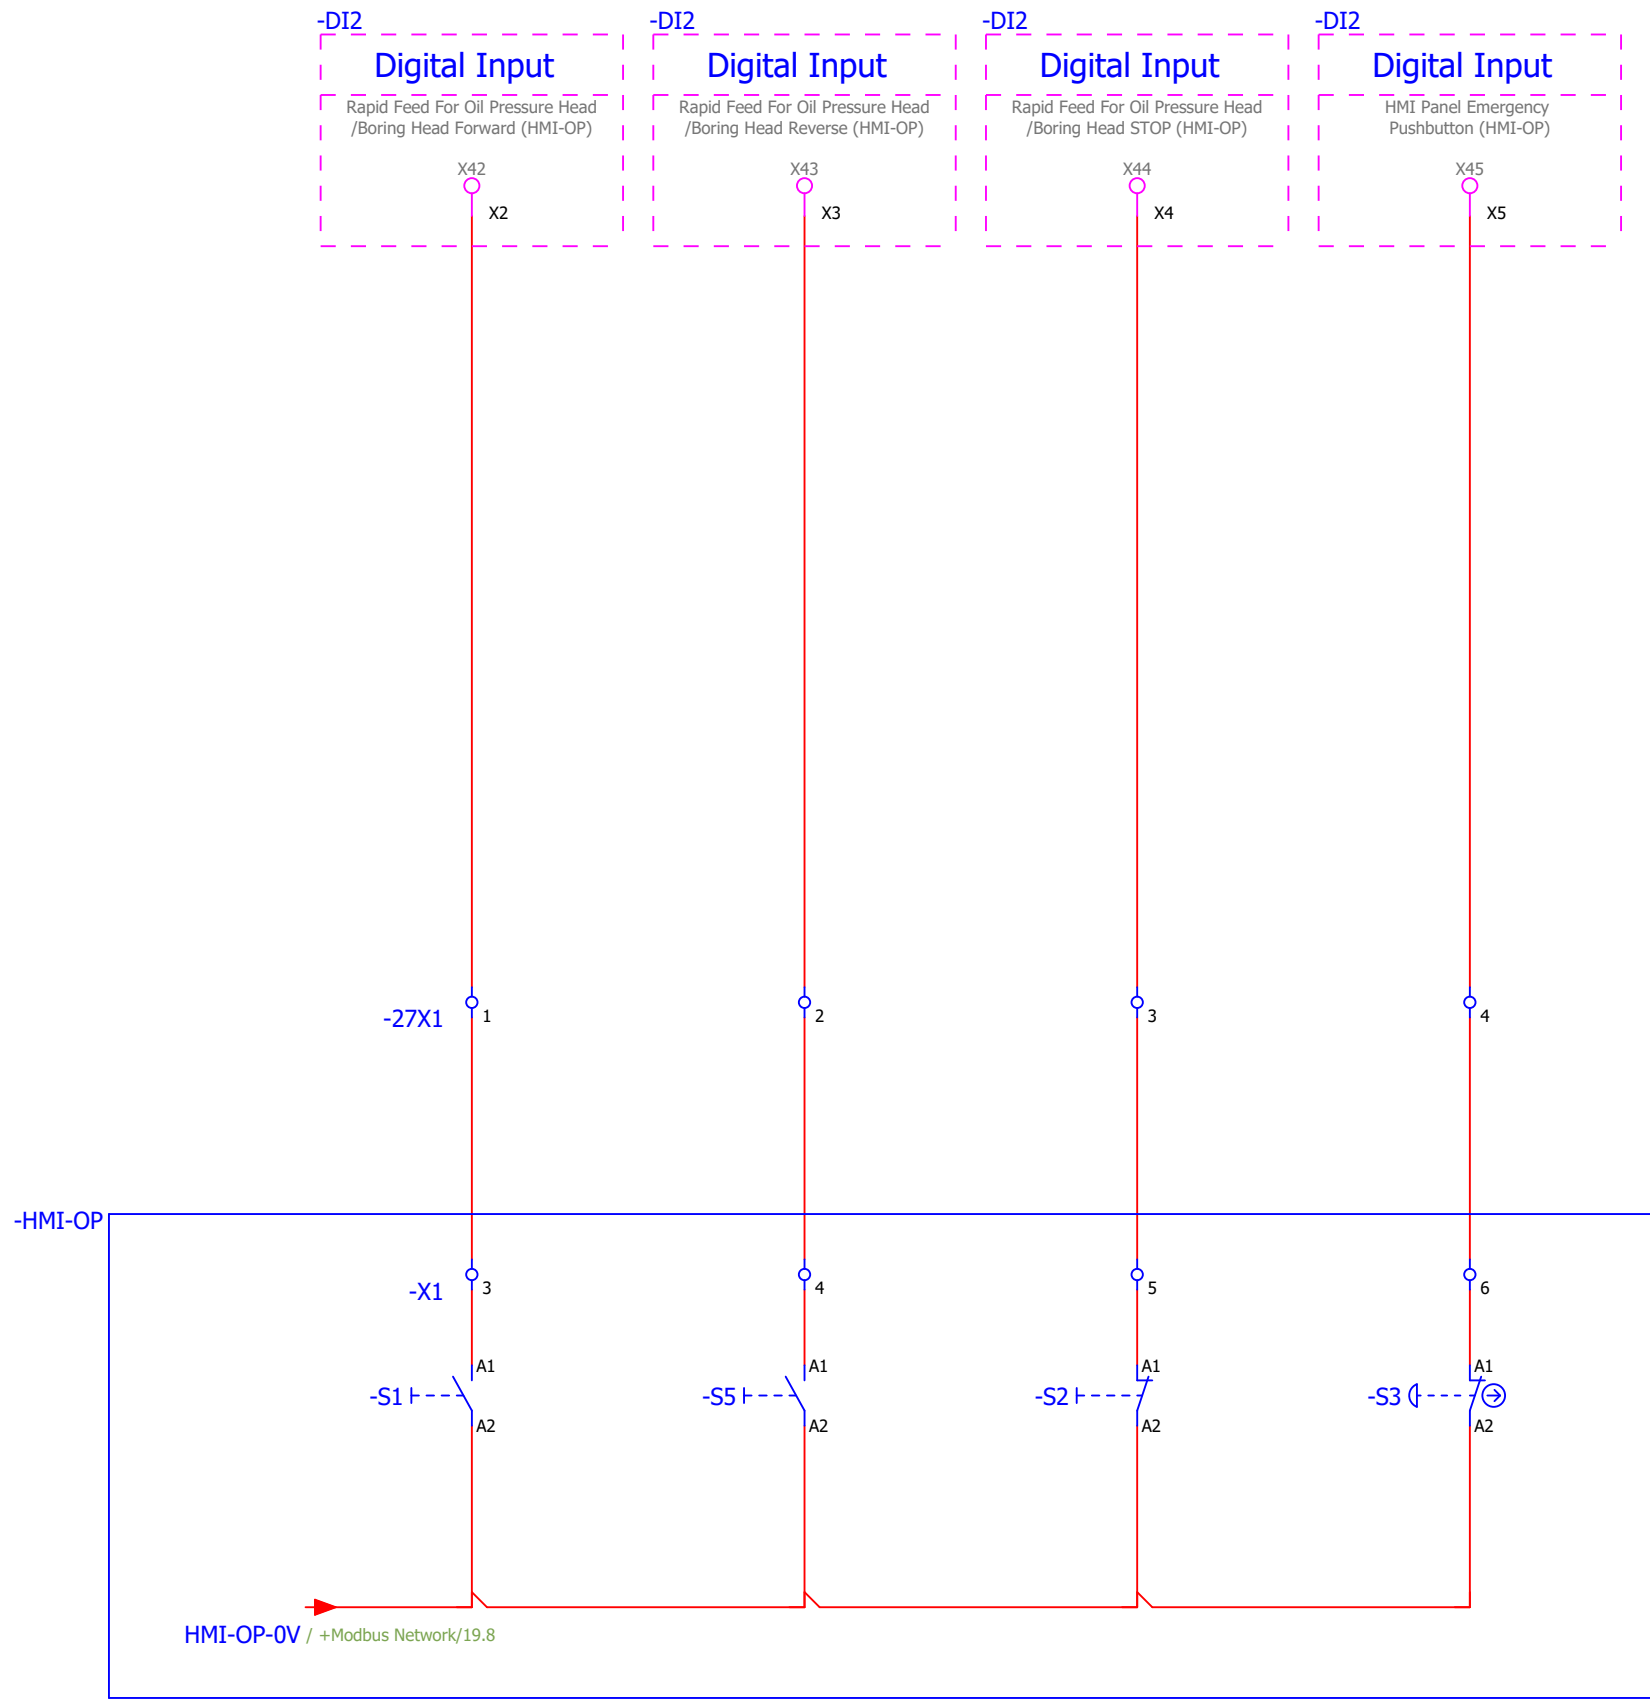


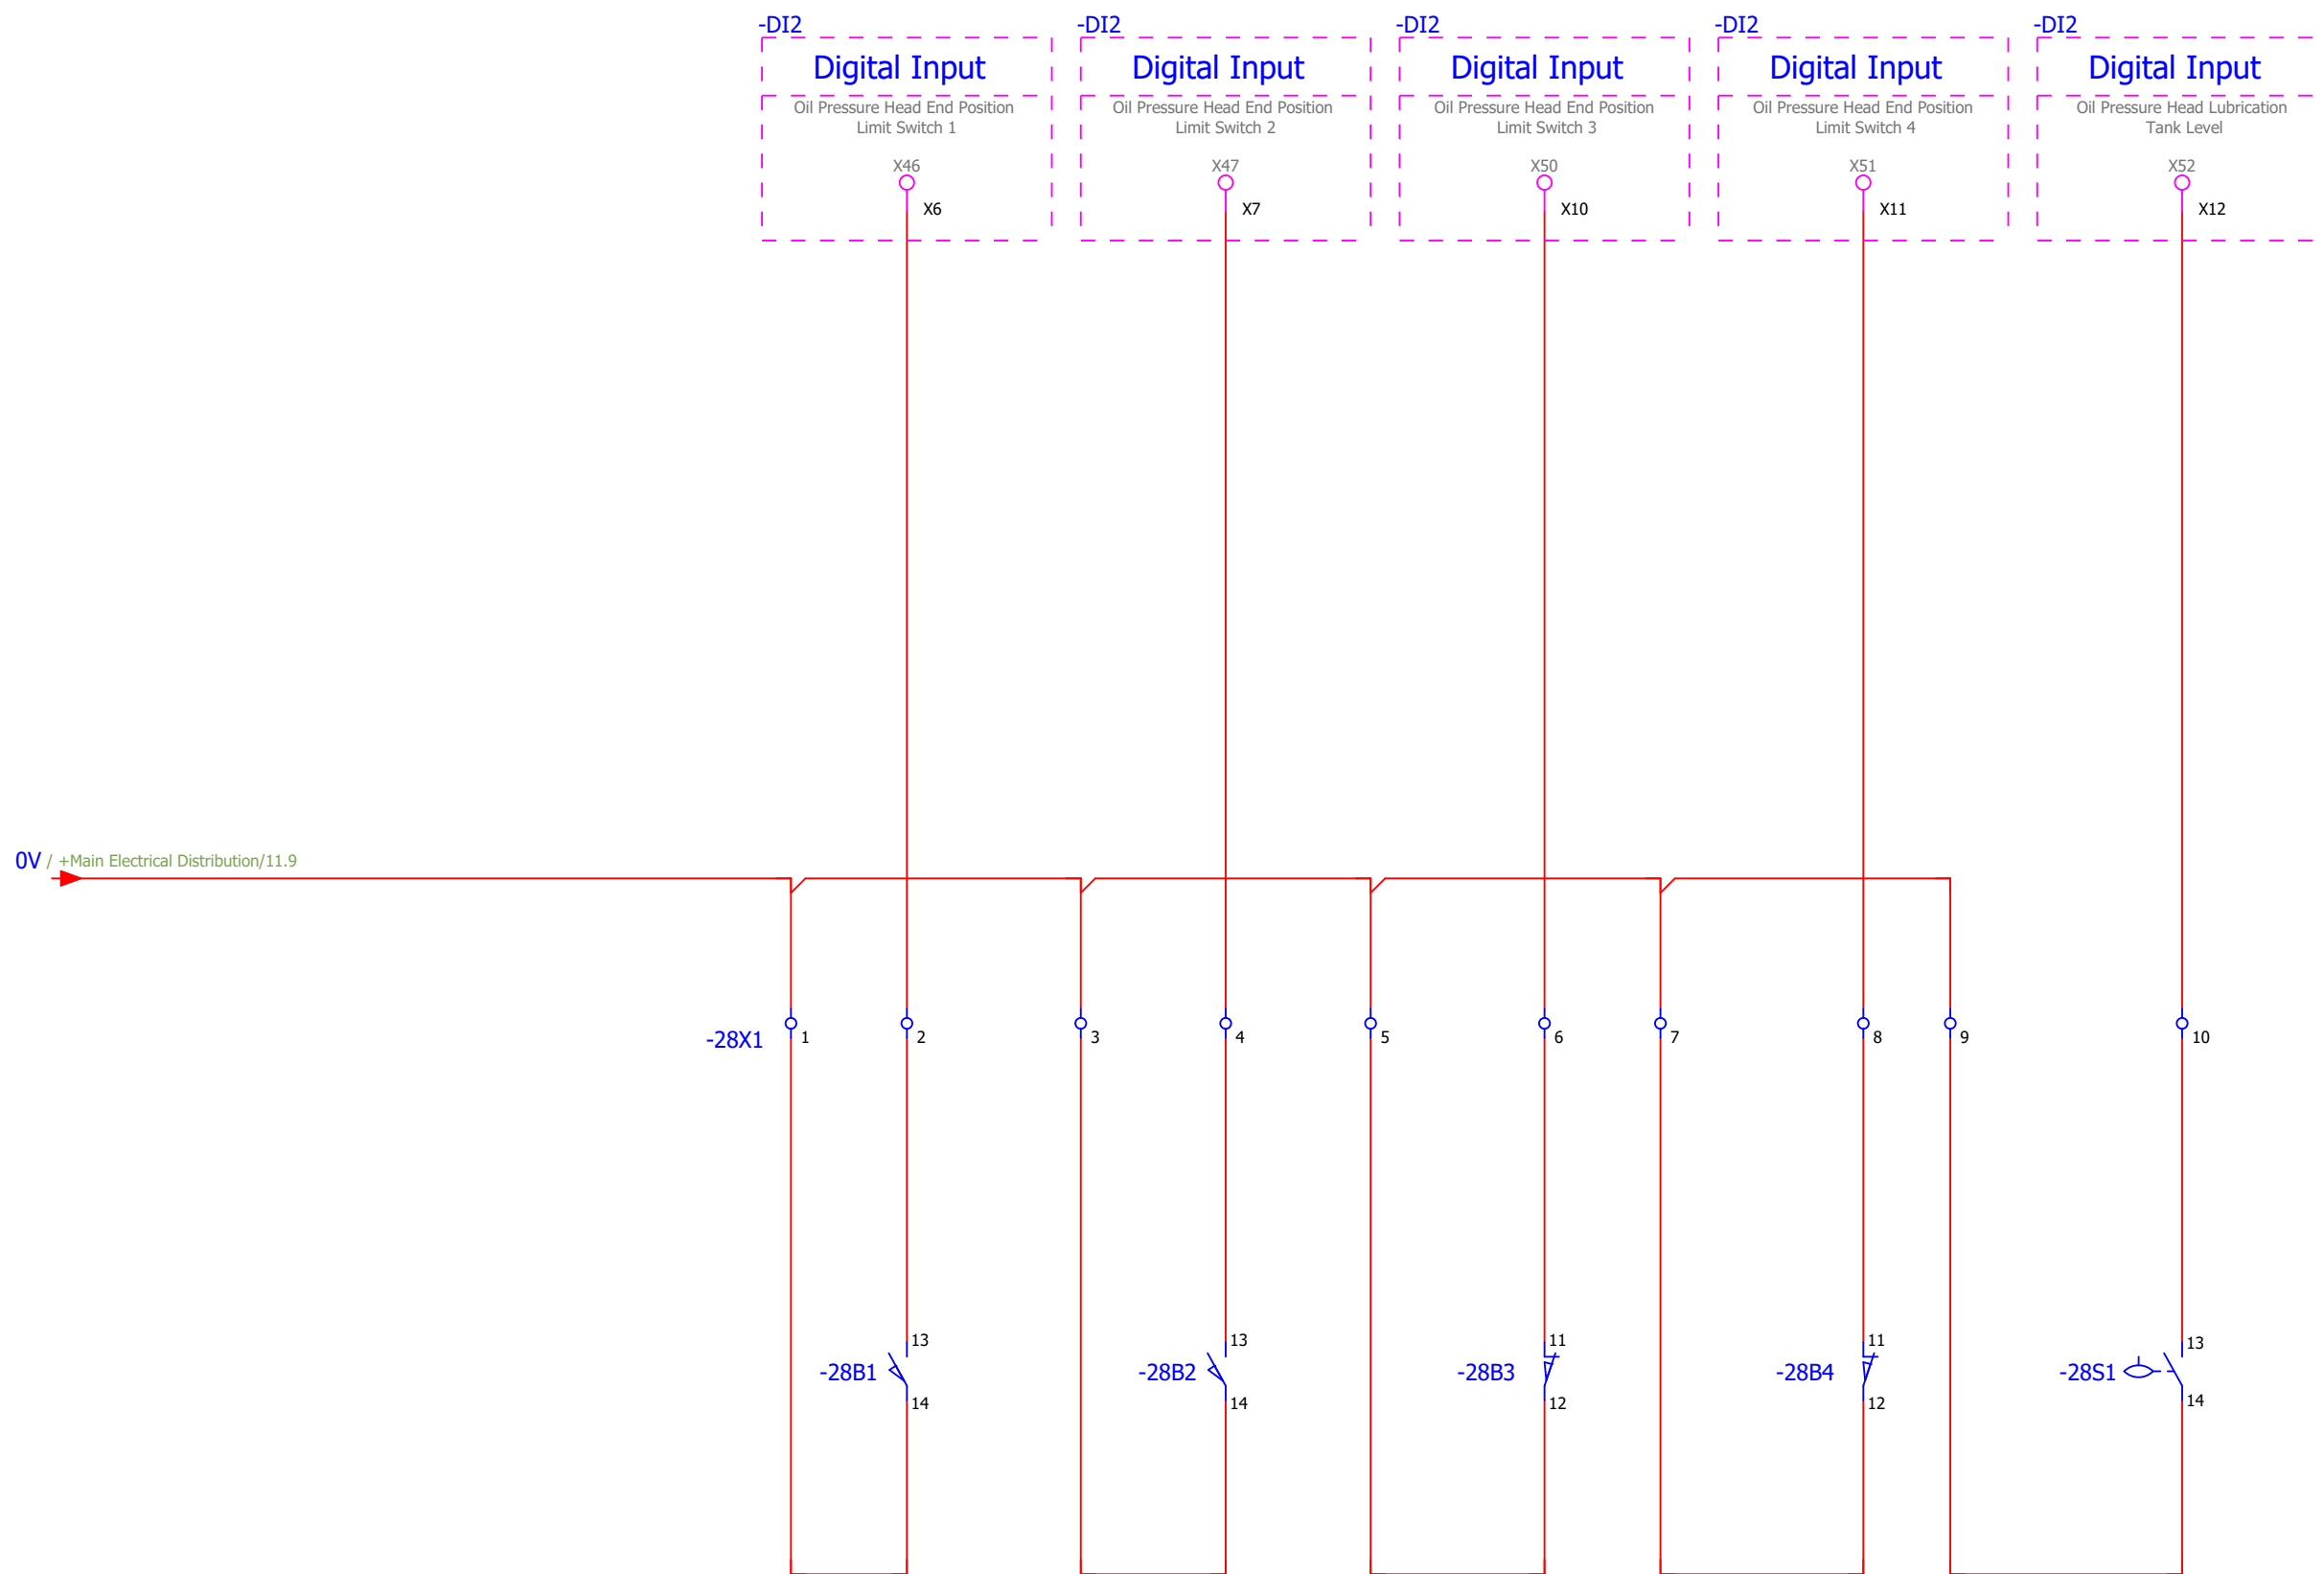


As Built				Project Description : Deep Hole Machin (DHD)	Page Description : Oil Pressure Head (Limit & Level Switch)		Job Number : ELEC-007		= DHD			
For Manufacturing	1404.10.14	Morteza Pourhasan							+ PLC Digital Inputs			
For Check	1404.9.15	Morteza Pourhasan	+989158875113						Software Version : EPLAN P8 2.9 SP1	Project Start : 8/30/2025	Last Edition : 10/13/2026	Page 28
Modification	Date	Design & Confirm	Contact US									Page 28 / 77

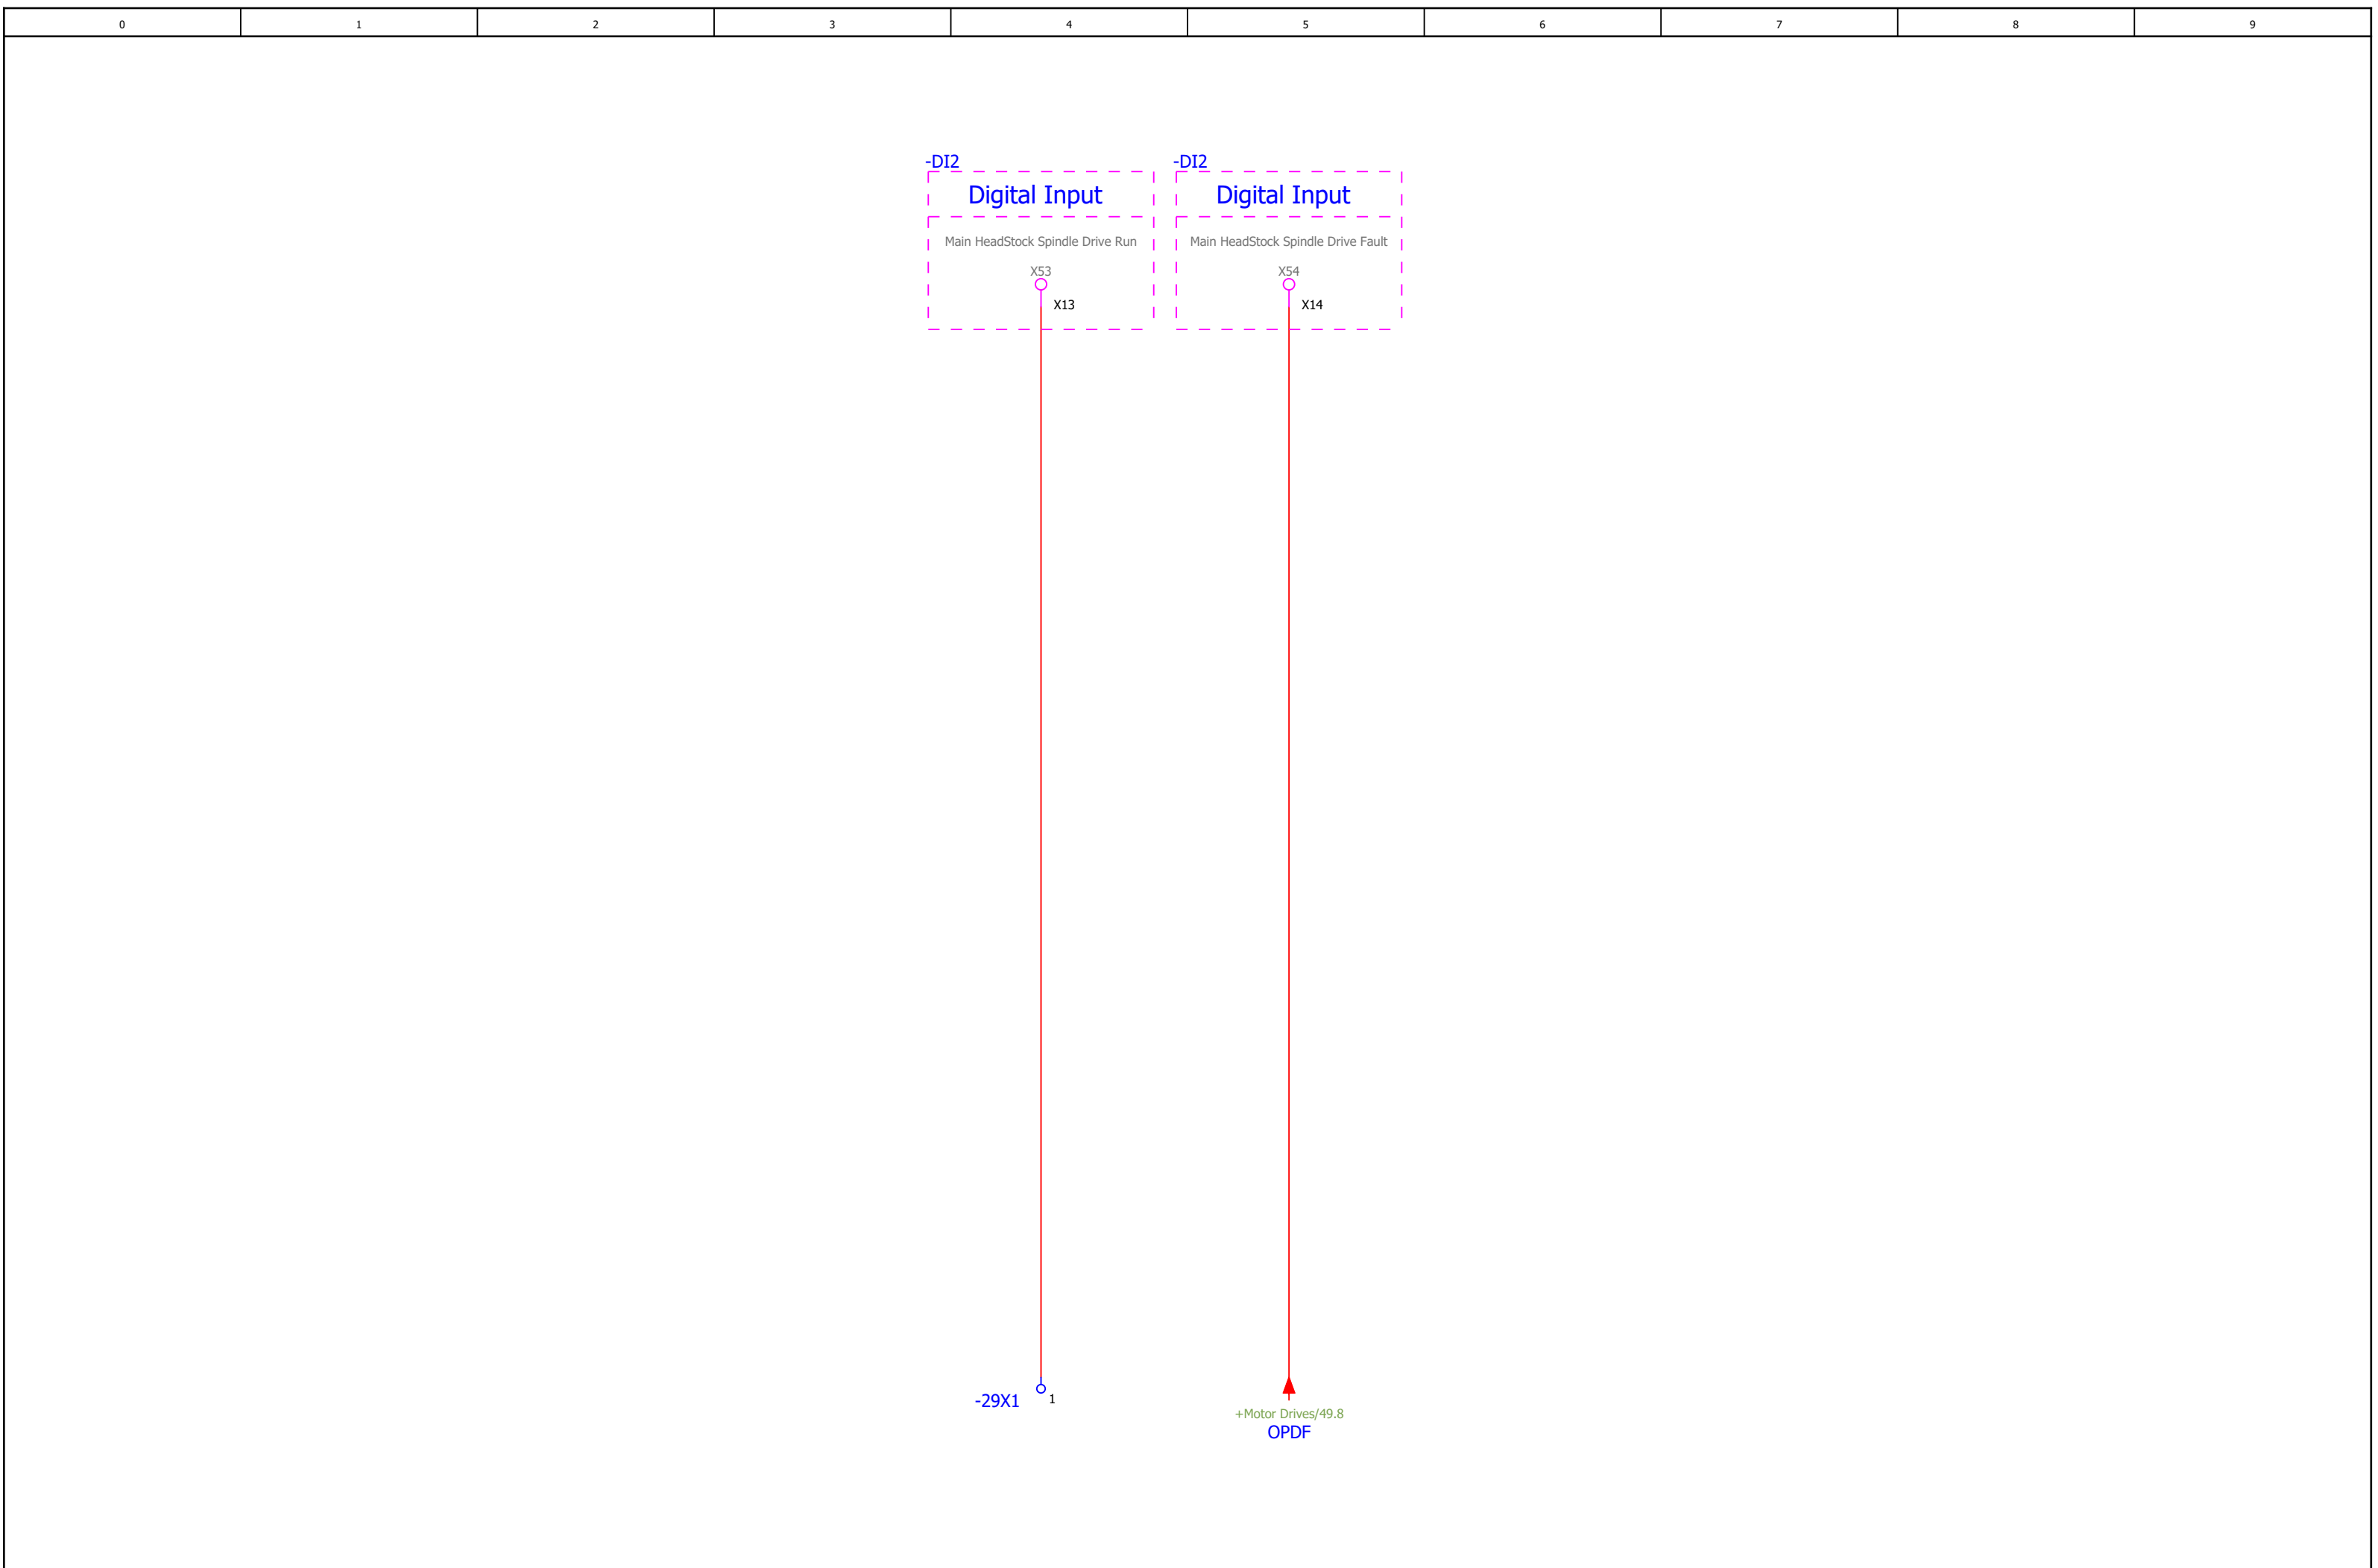

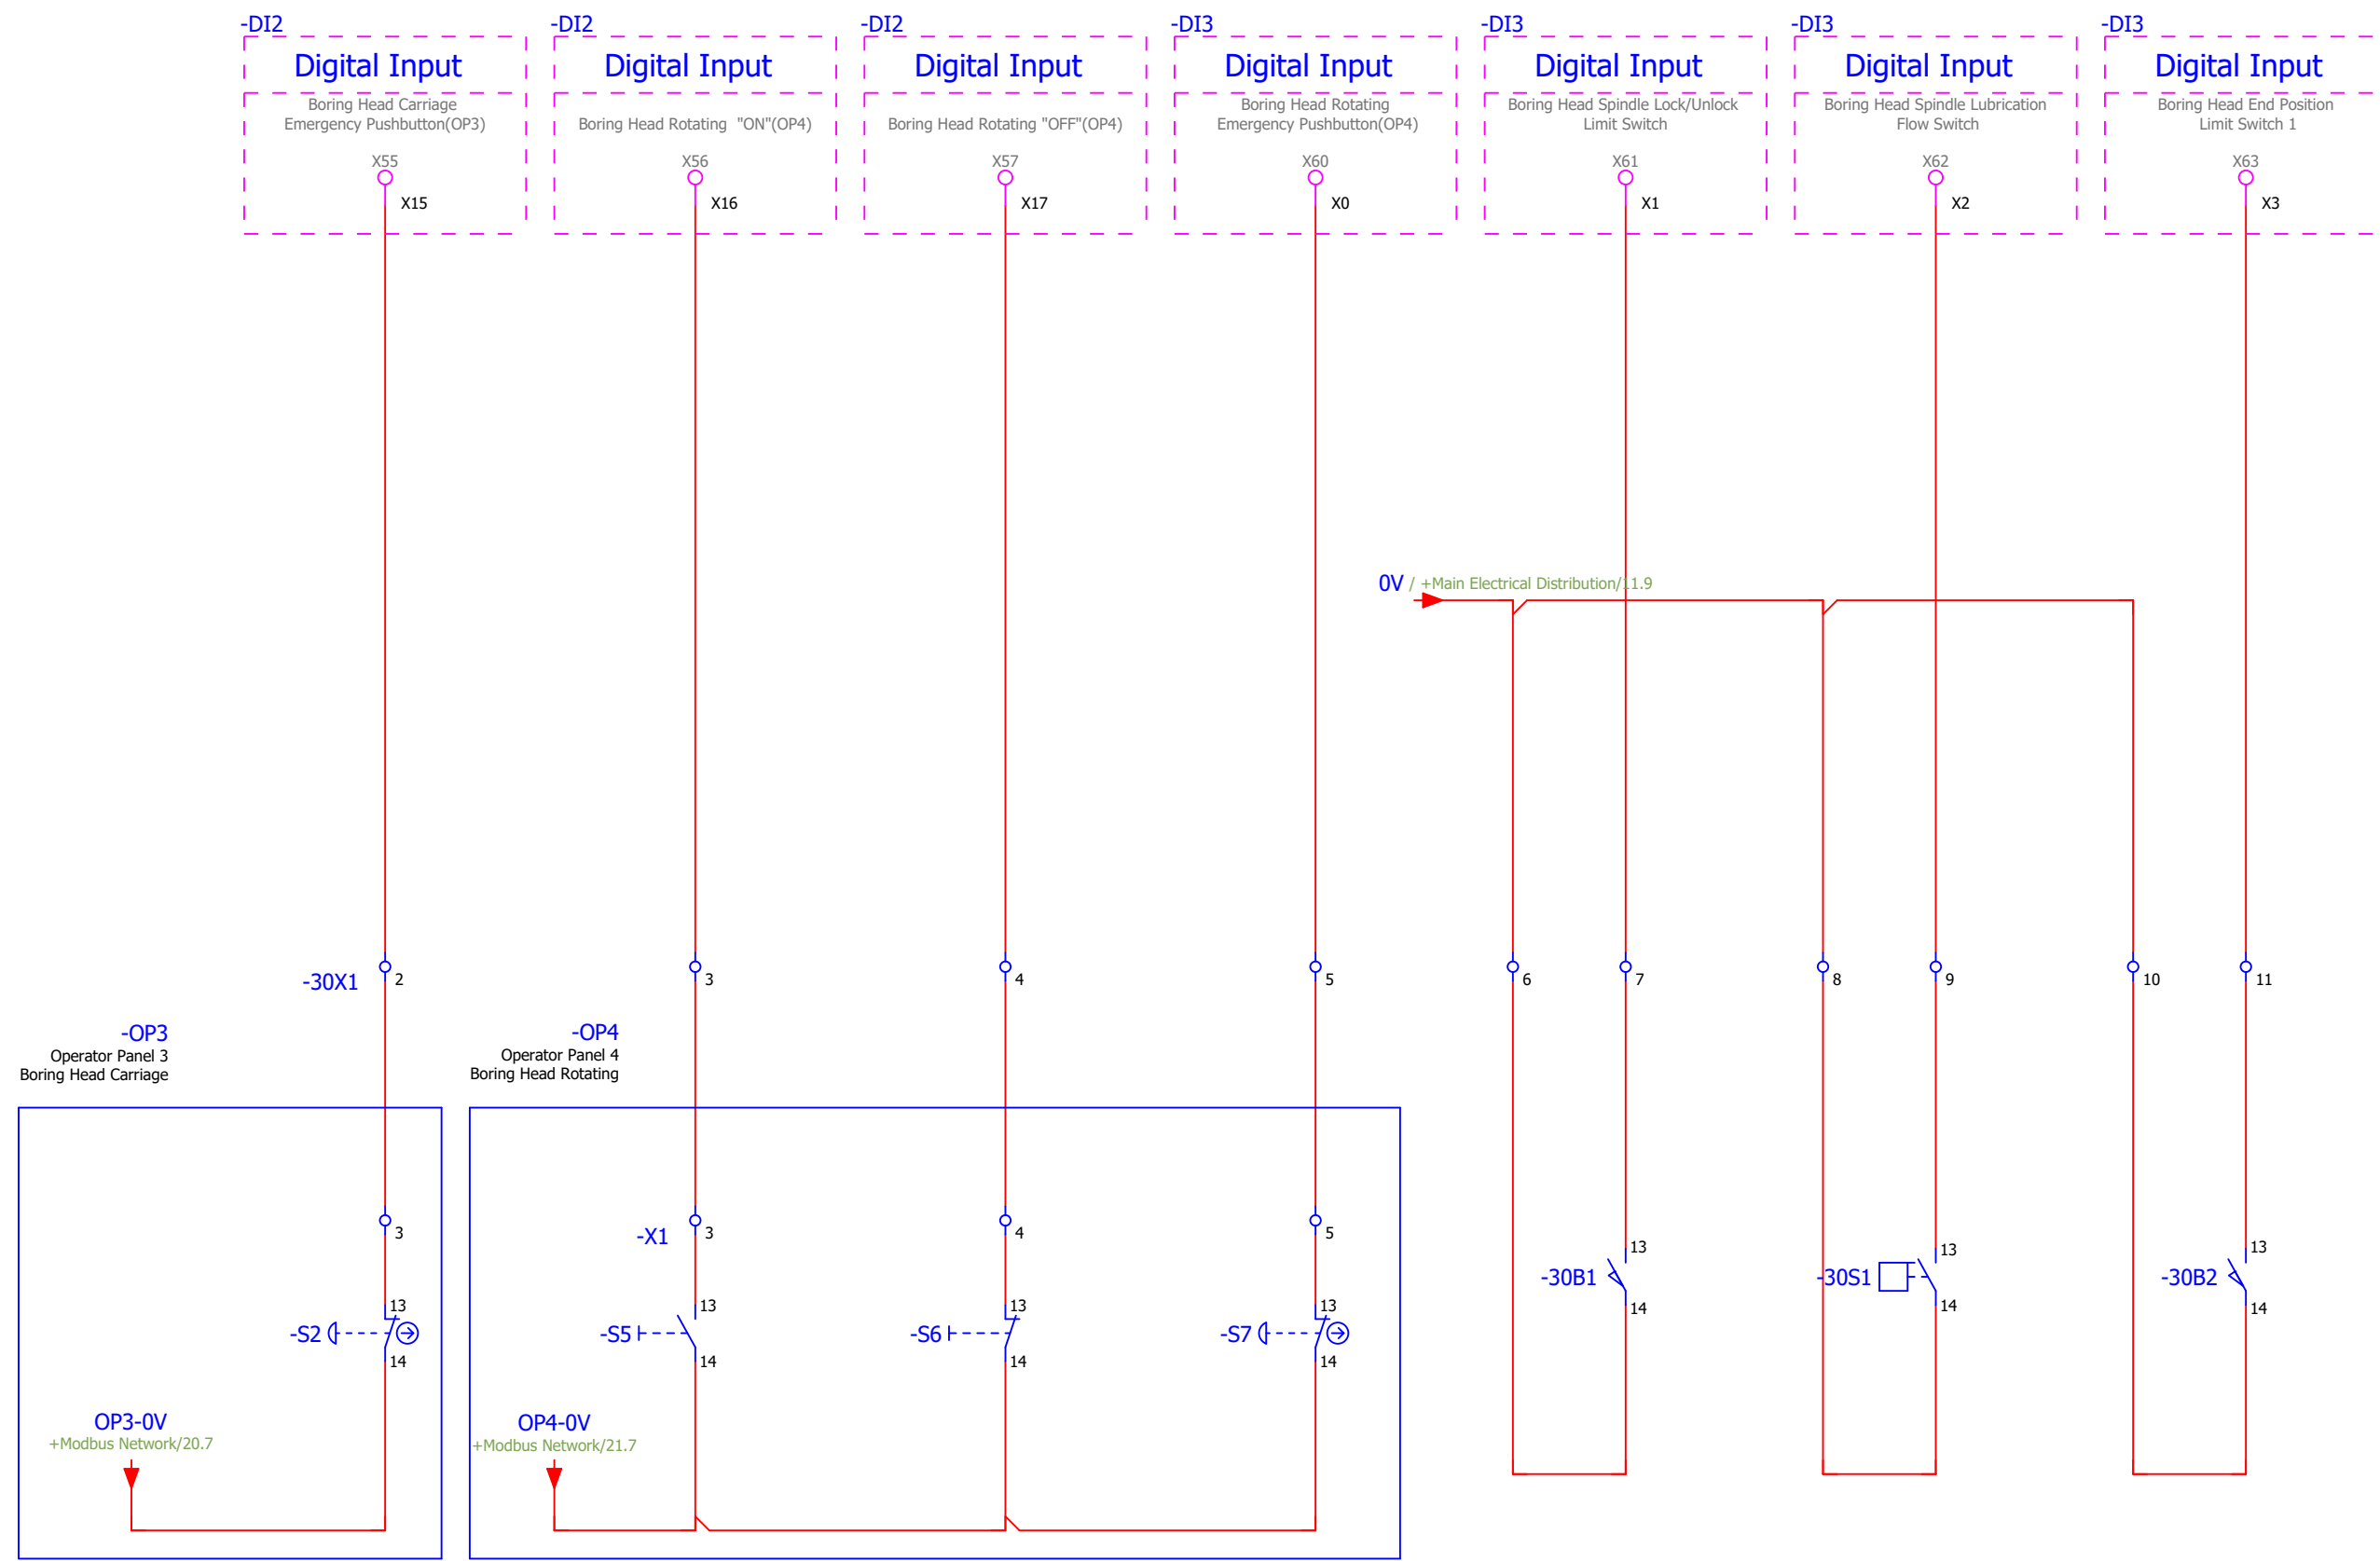

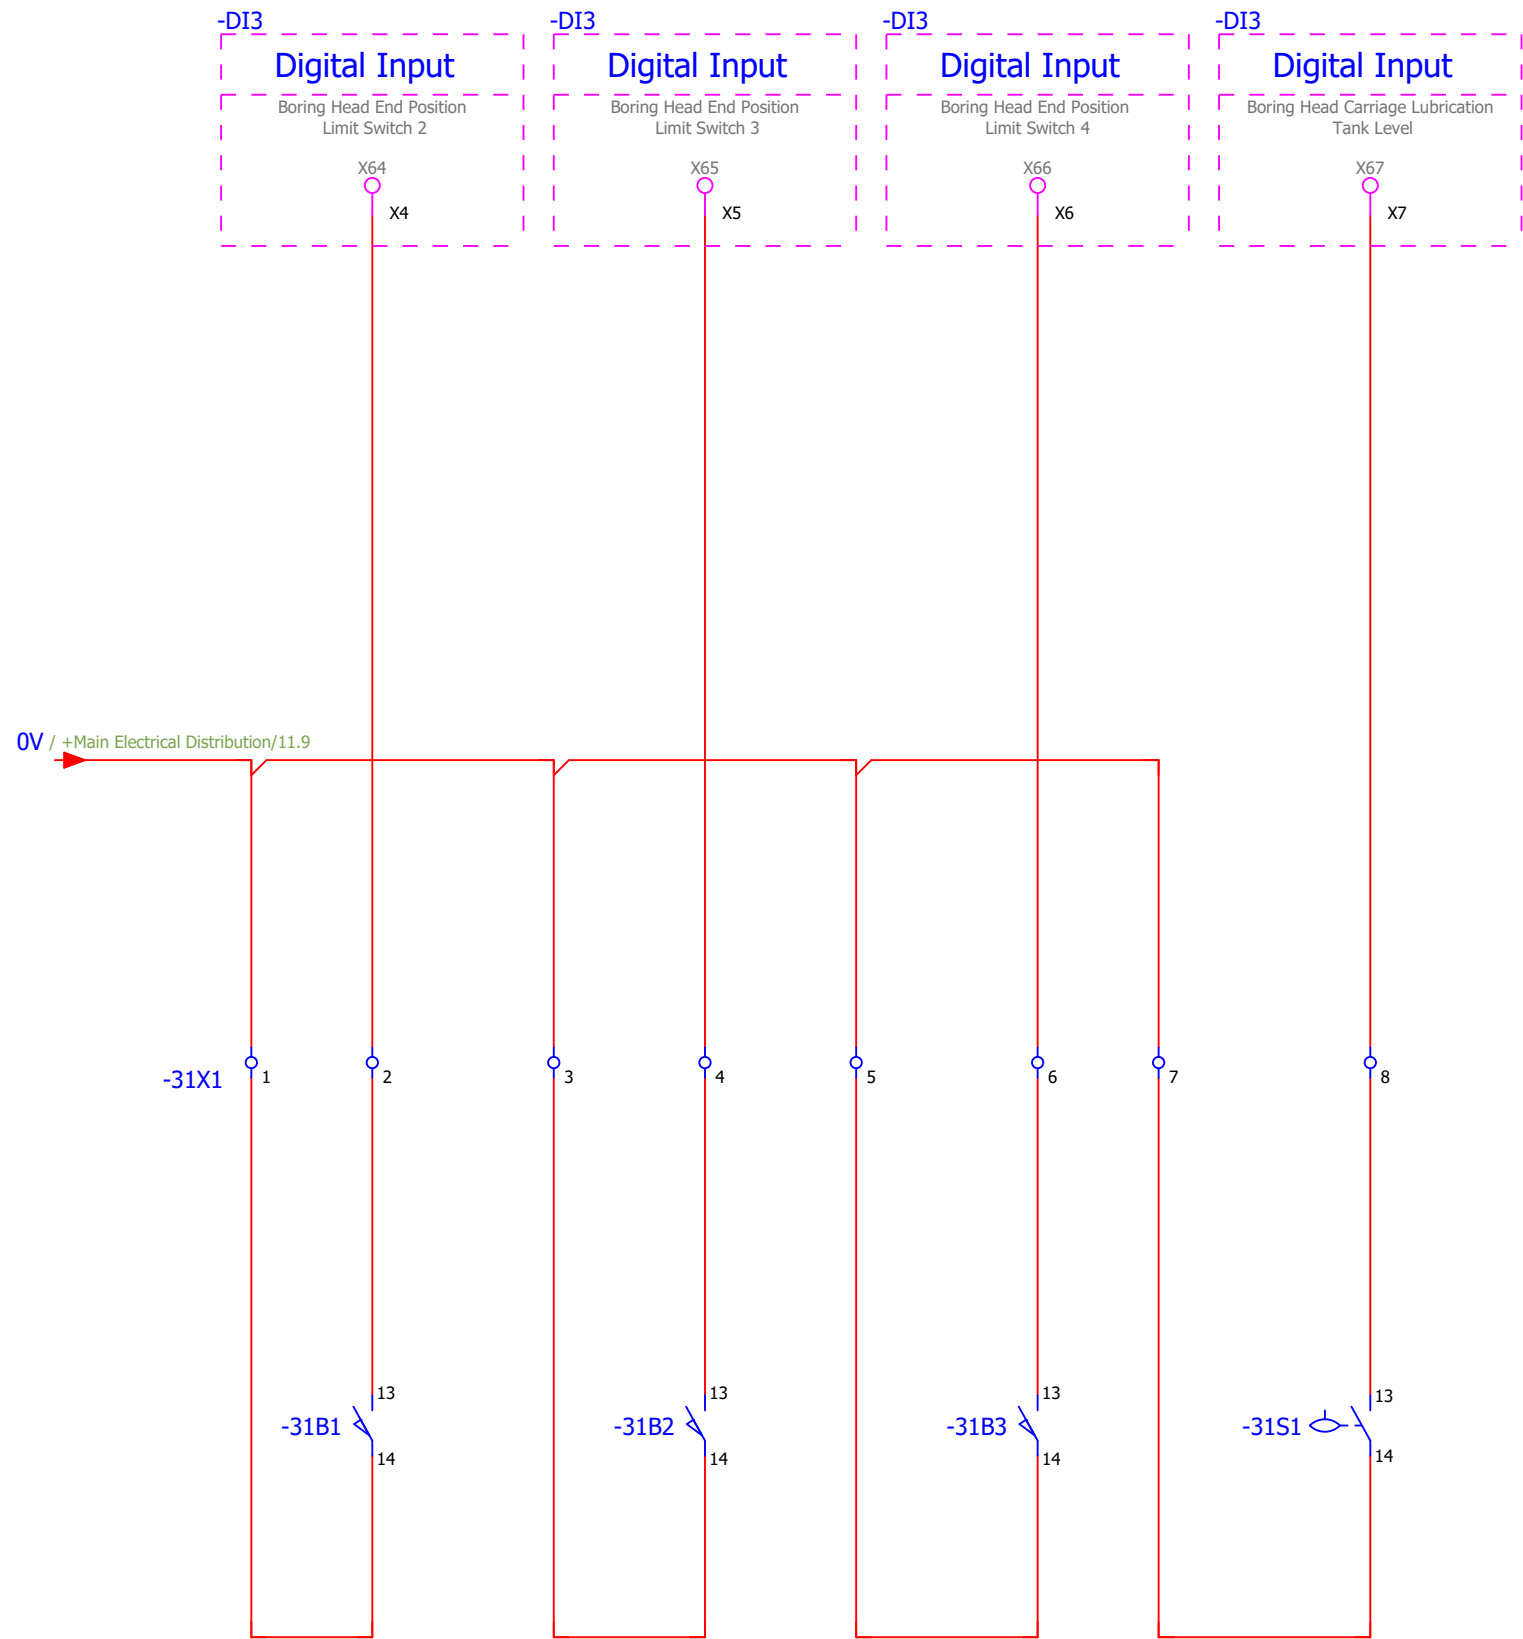

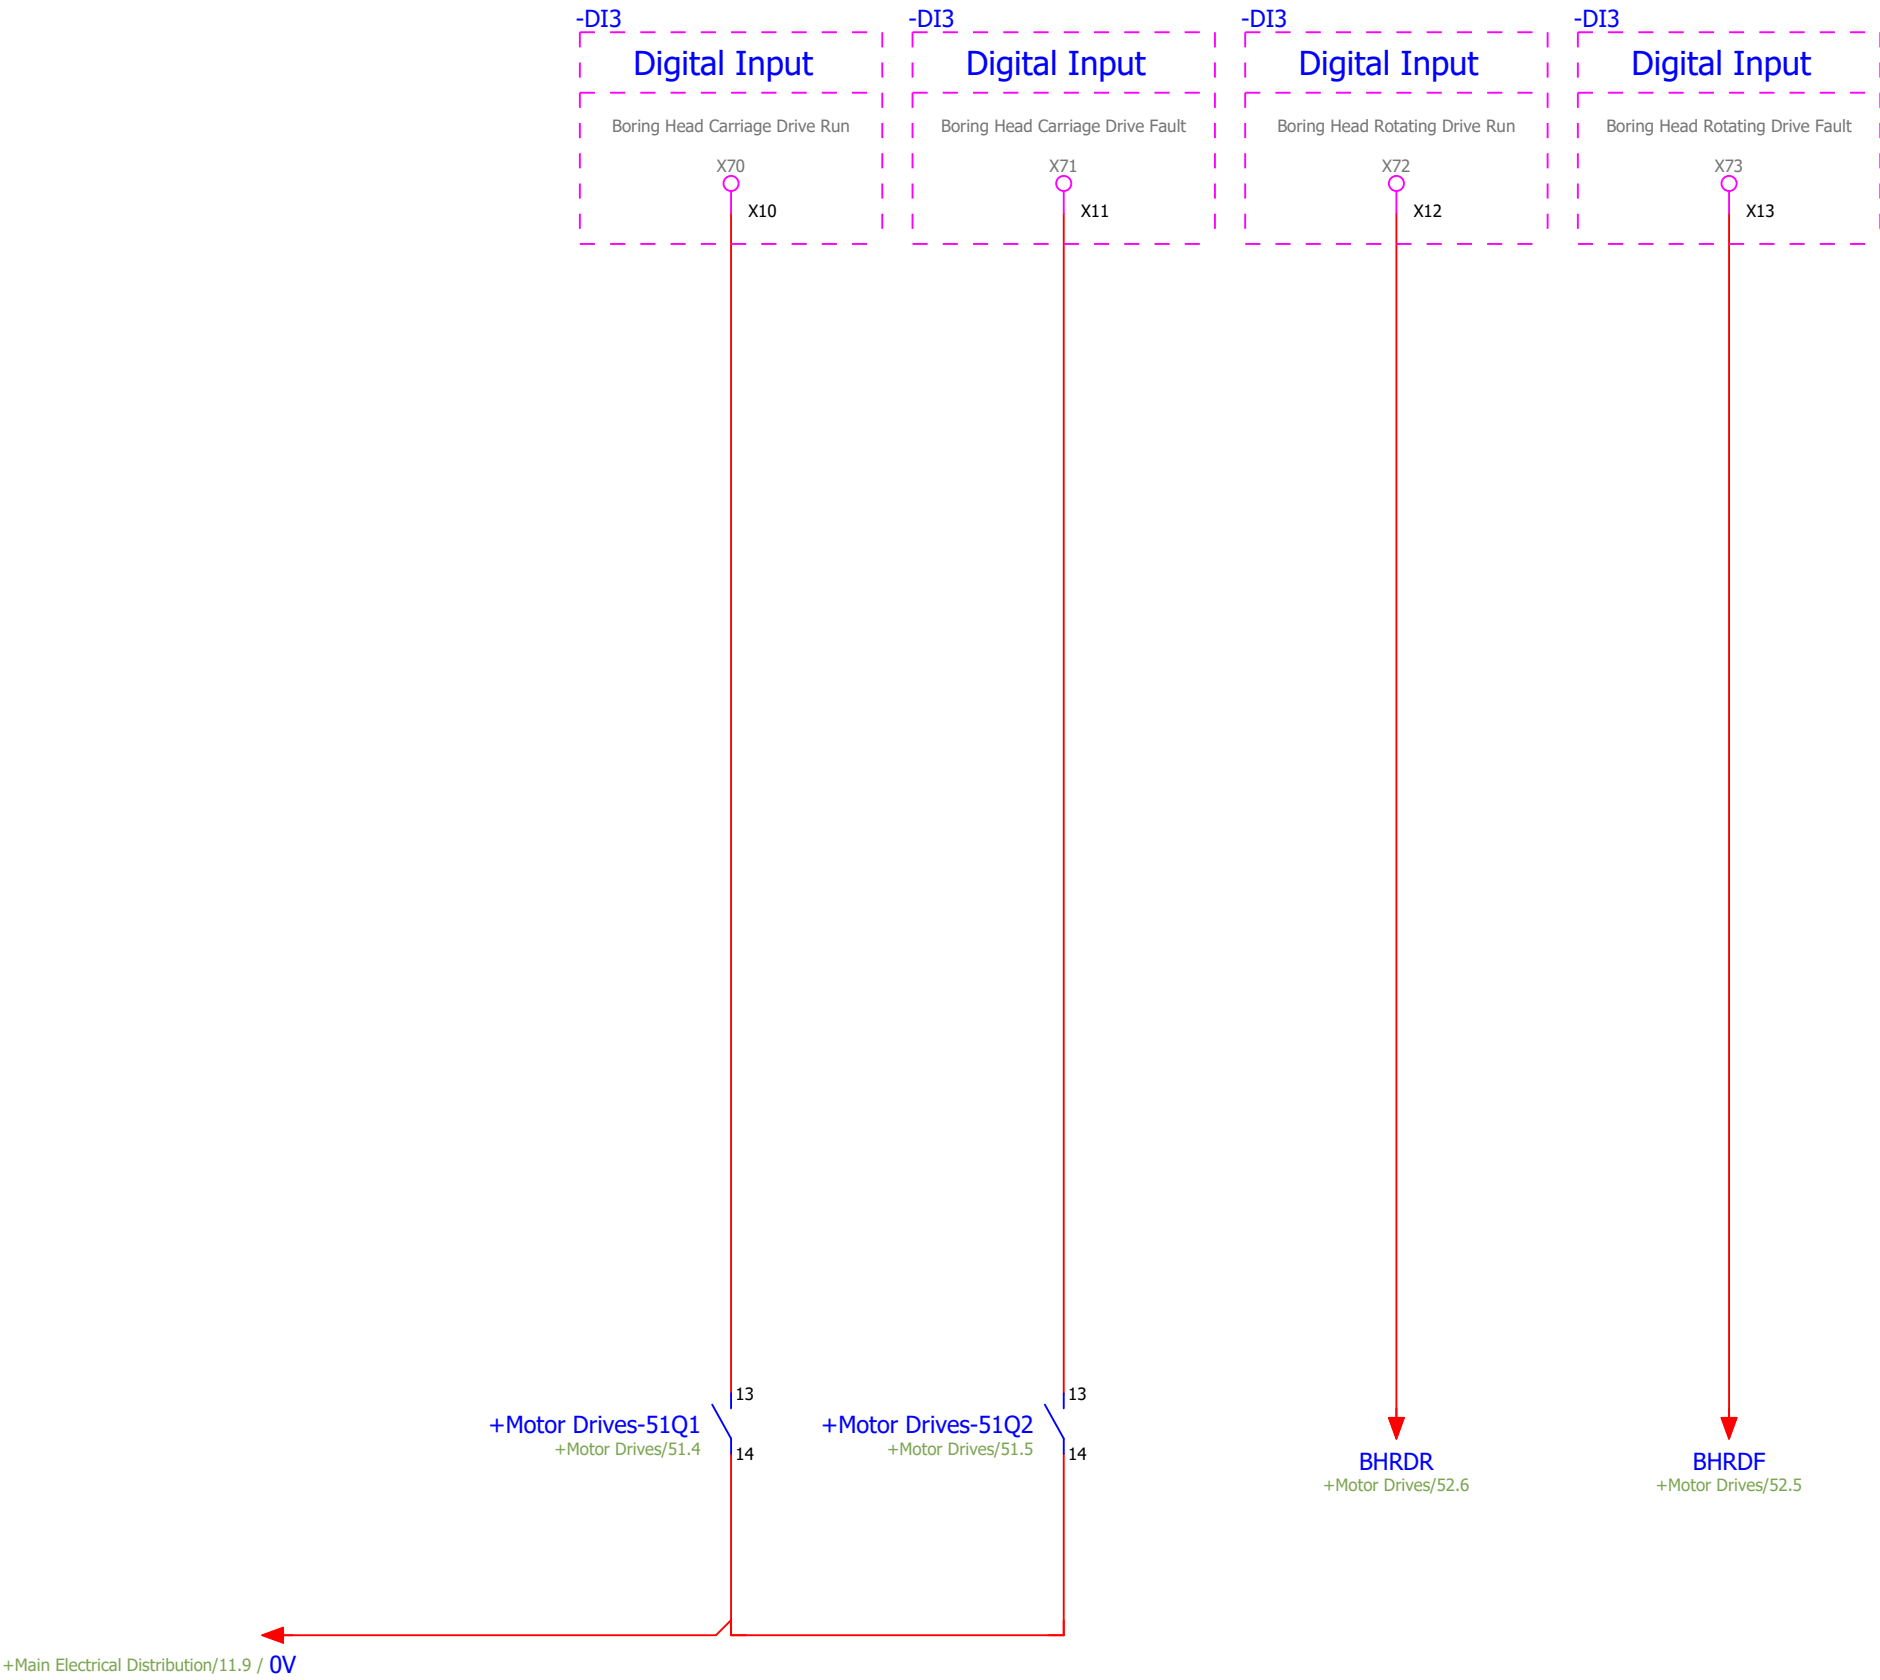

As Built			
For Manufacturing	1404.10.14	Morteza Pourhasan	
For Check	1404.9.15	Morteza Pourhasan	+989158875113
Modification	Date	Design & Confirm	Contact US


Project Description :
Deep Hole Machin (DHD)


Page Description :
Boring Head (Drive Status)




Job Number :	ELEC-007
Software Version :	EPLAN P8 2.9 SP1
Project Start :	8/30/2025


= DHD	
+ PLC Digital Inputs	
Last Edition :	10/13/2026
Page	32 / 77

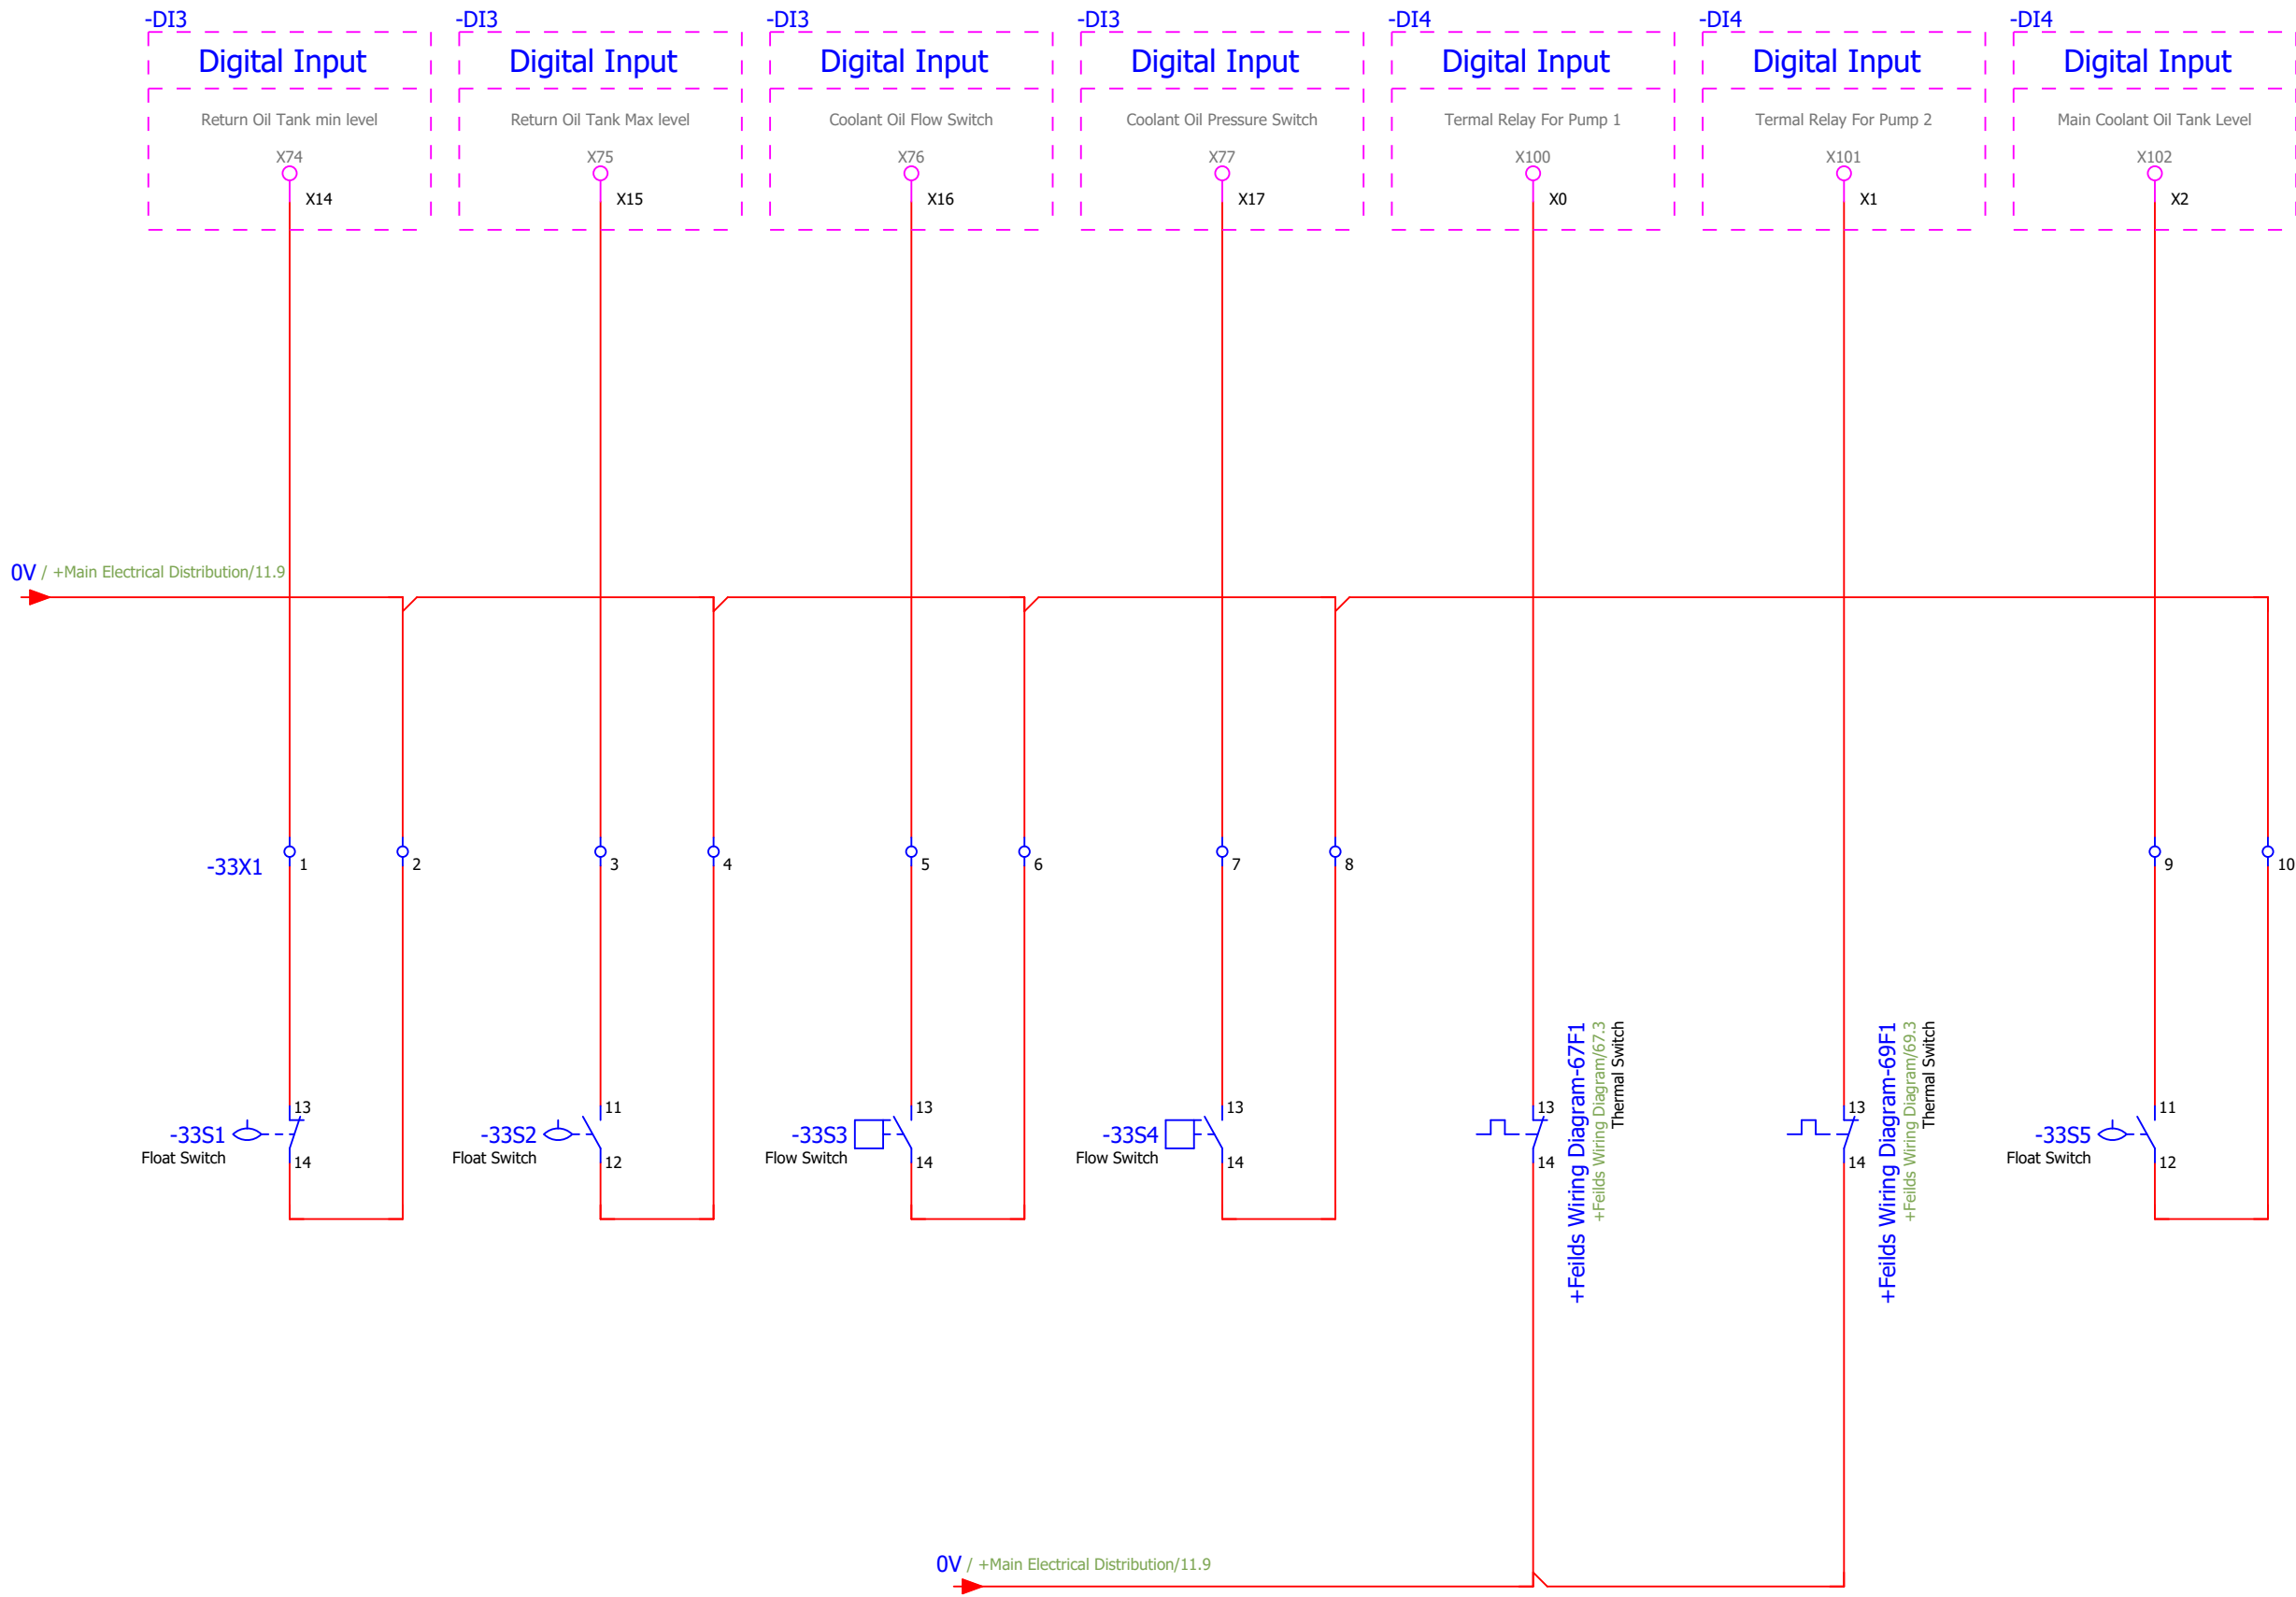


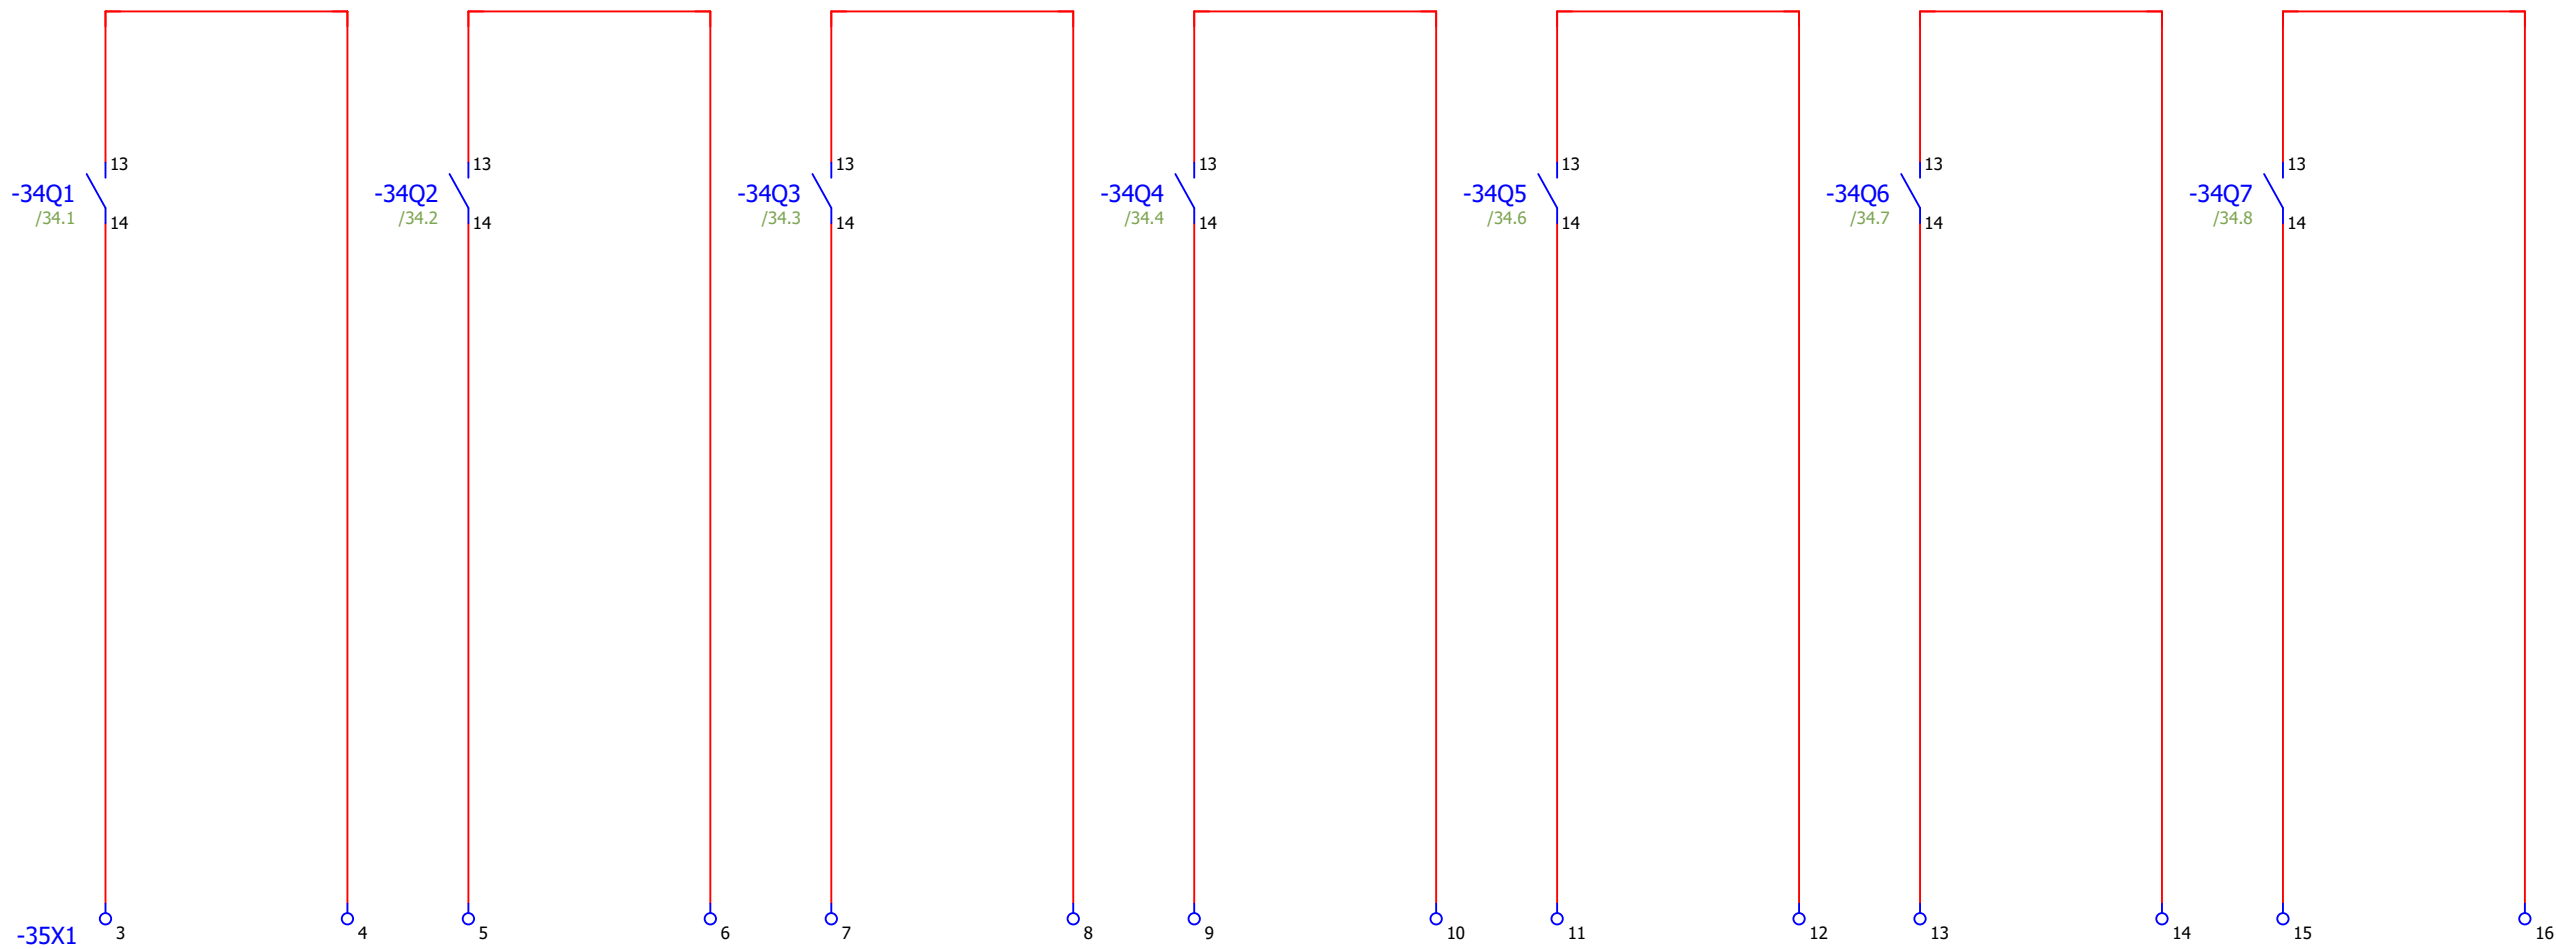

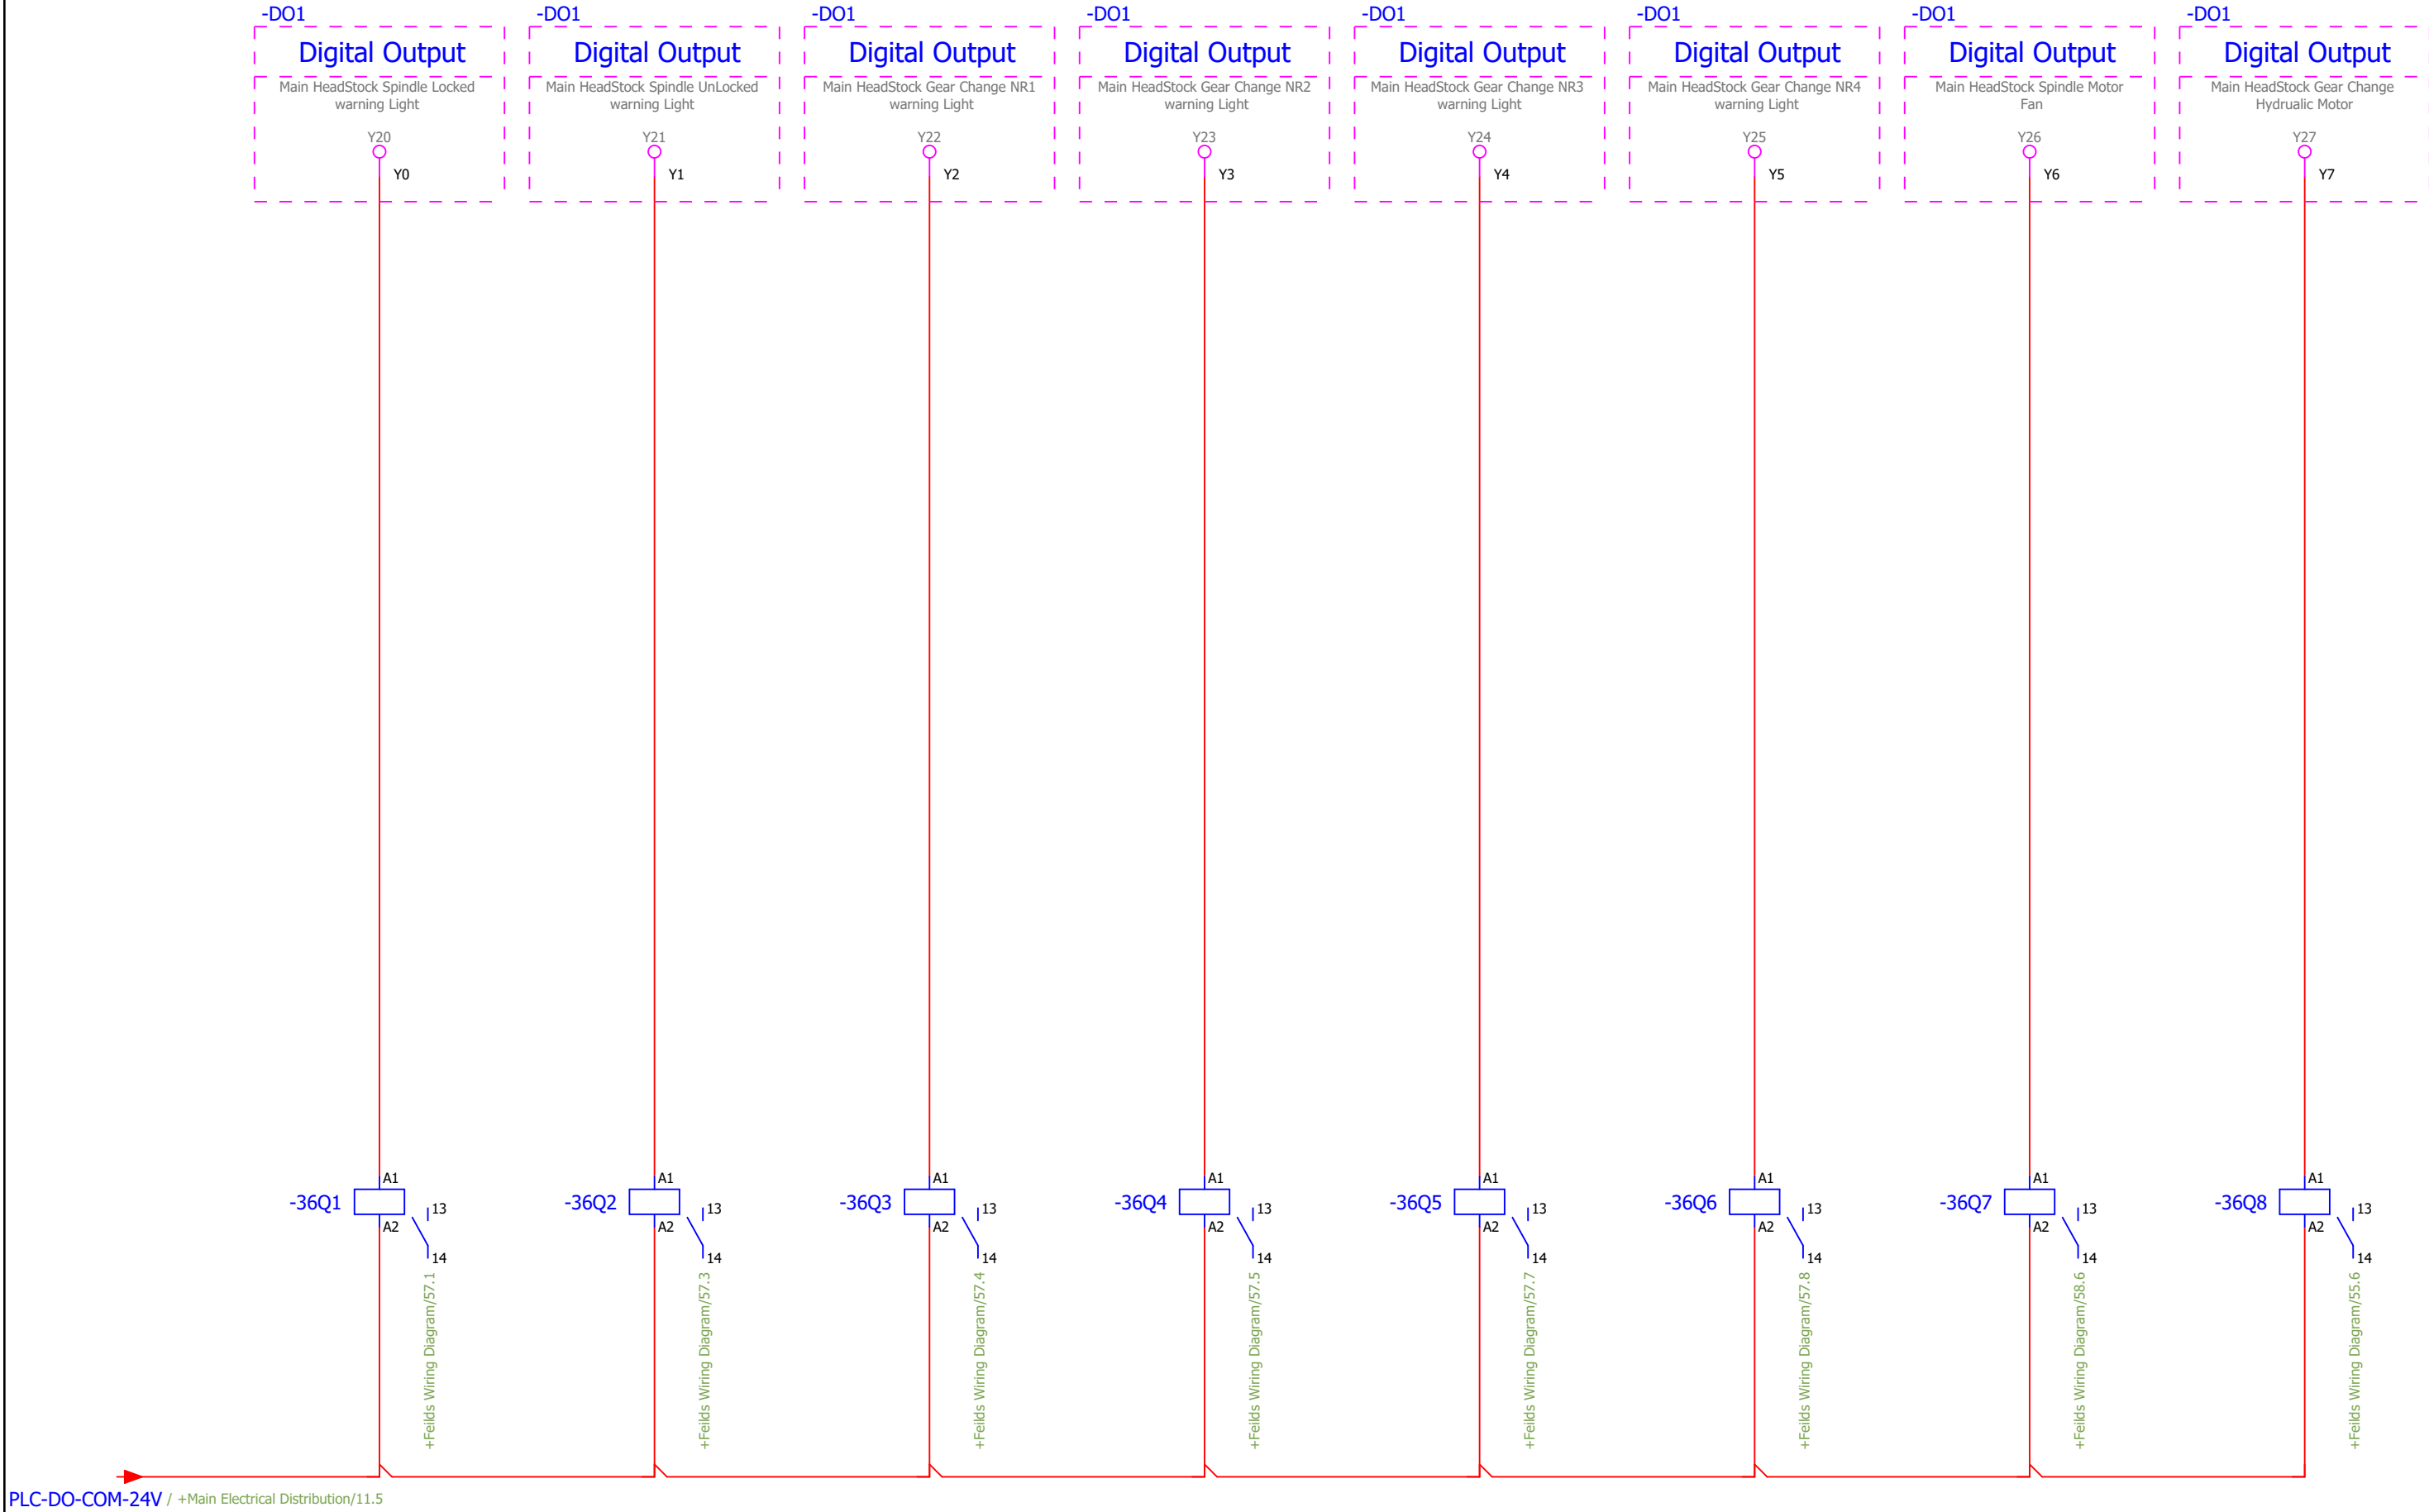


PLC-DO-COM-24V / +Main Electrical Distribution/11.5

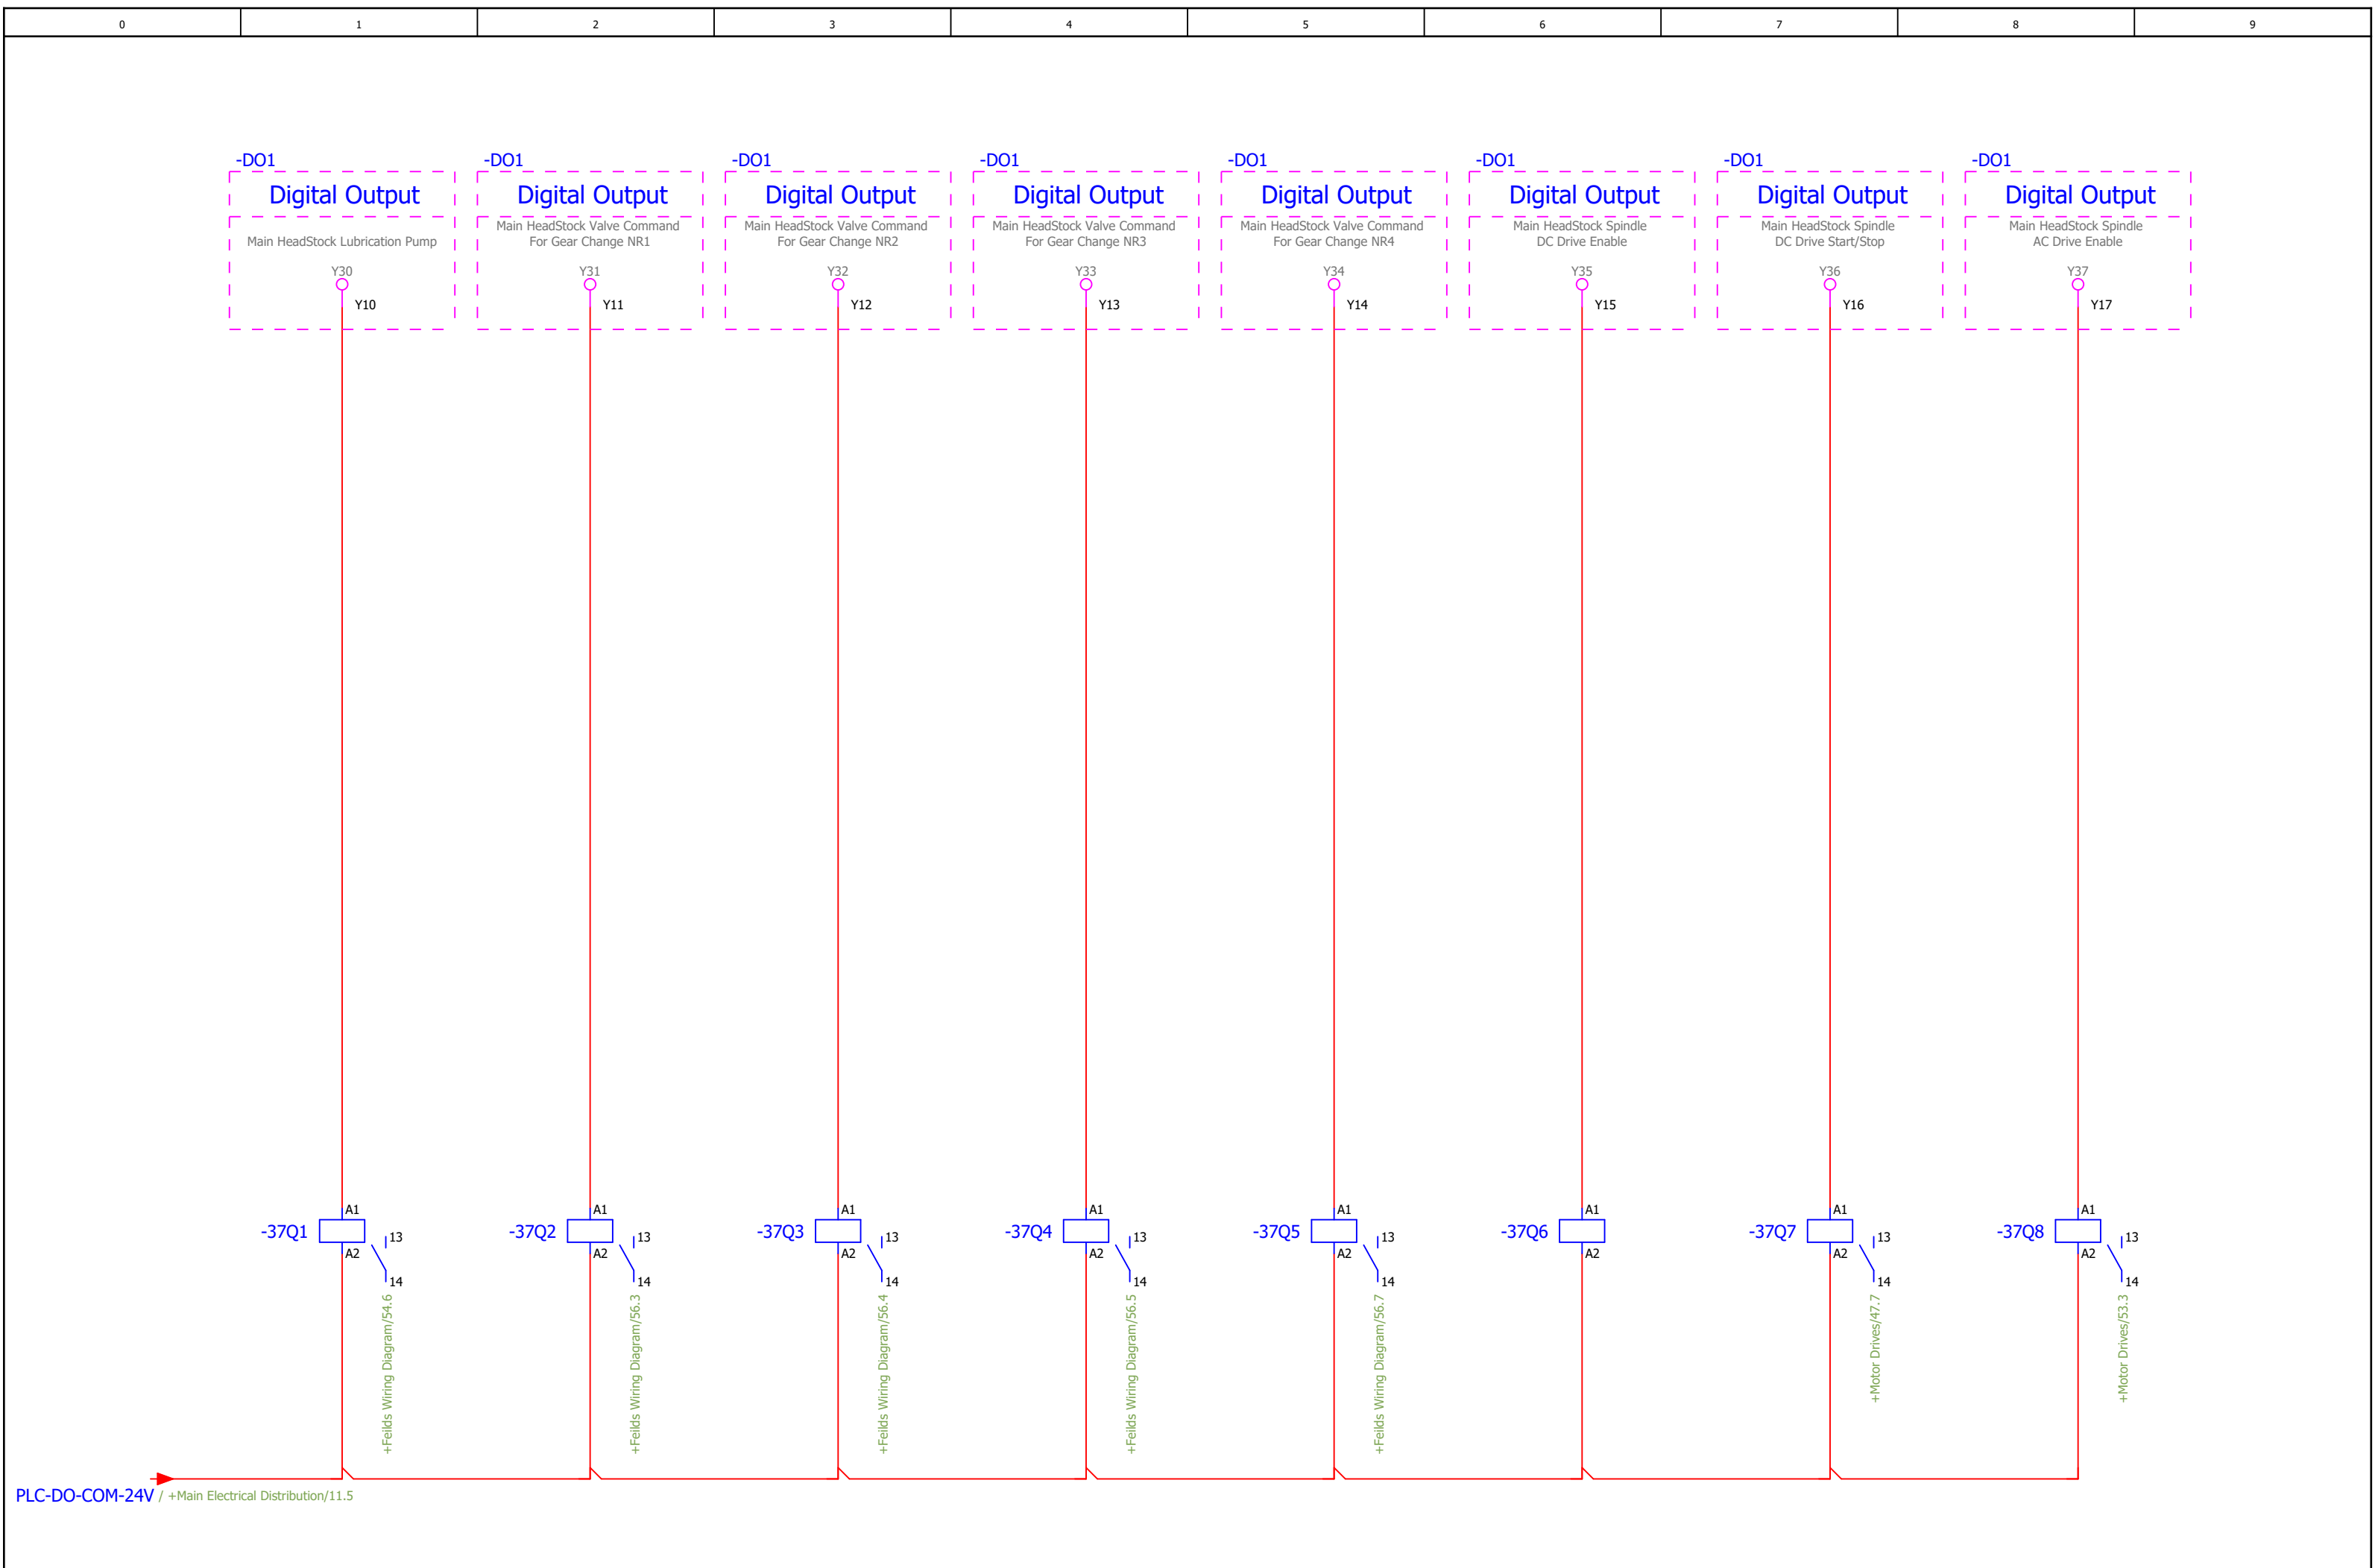


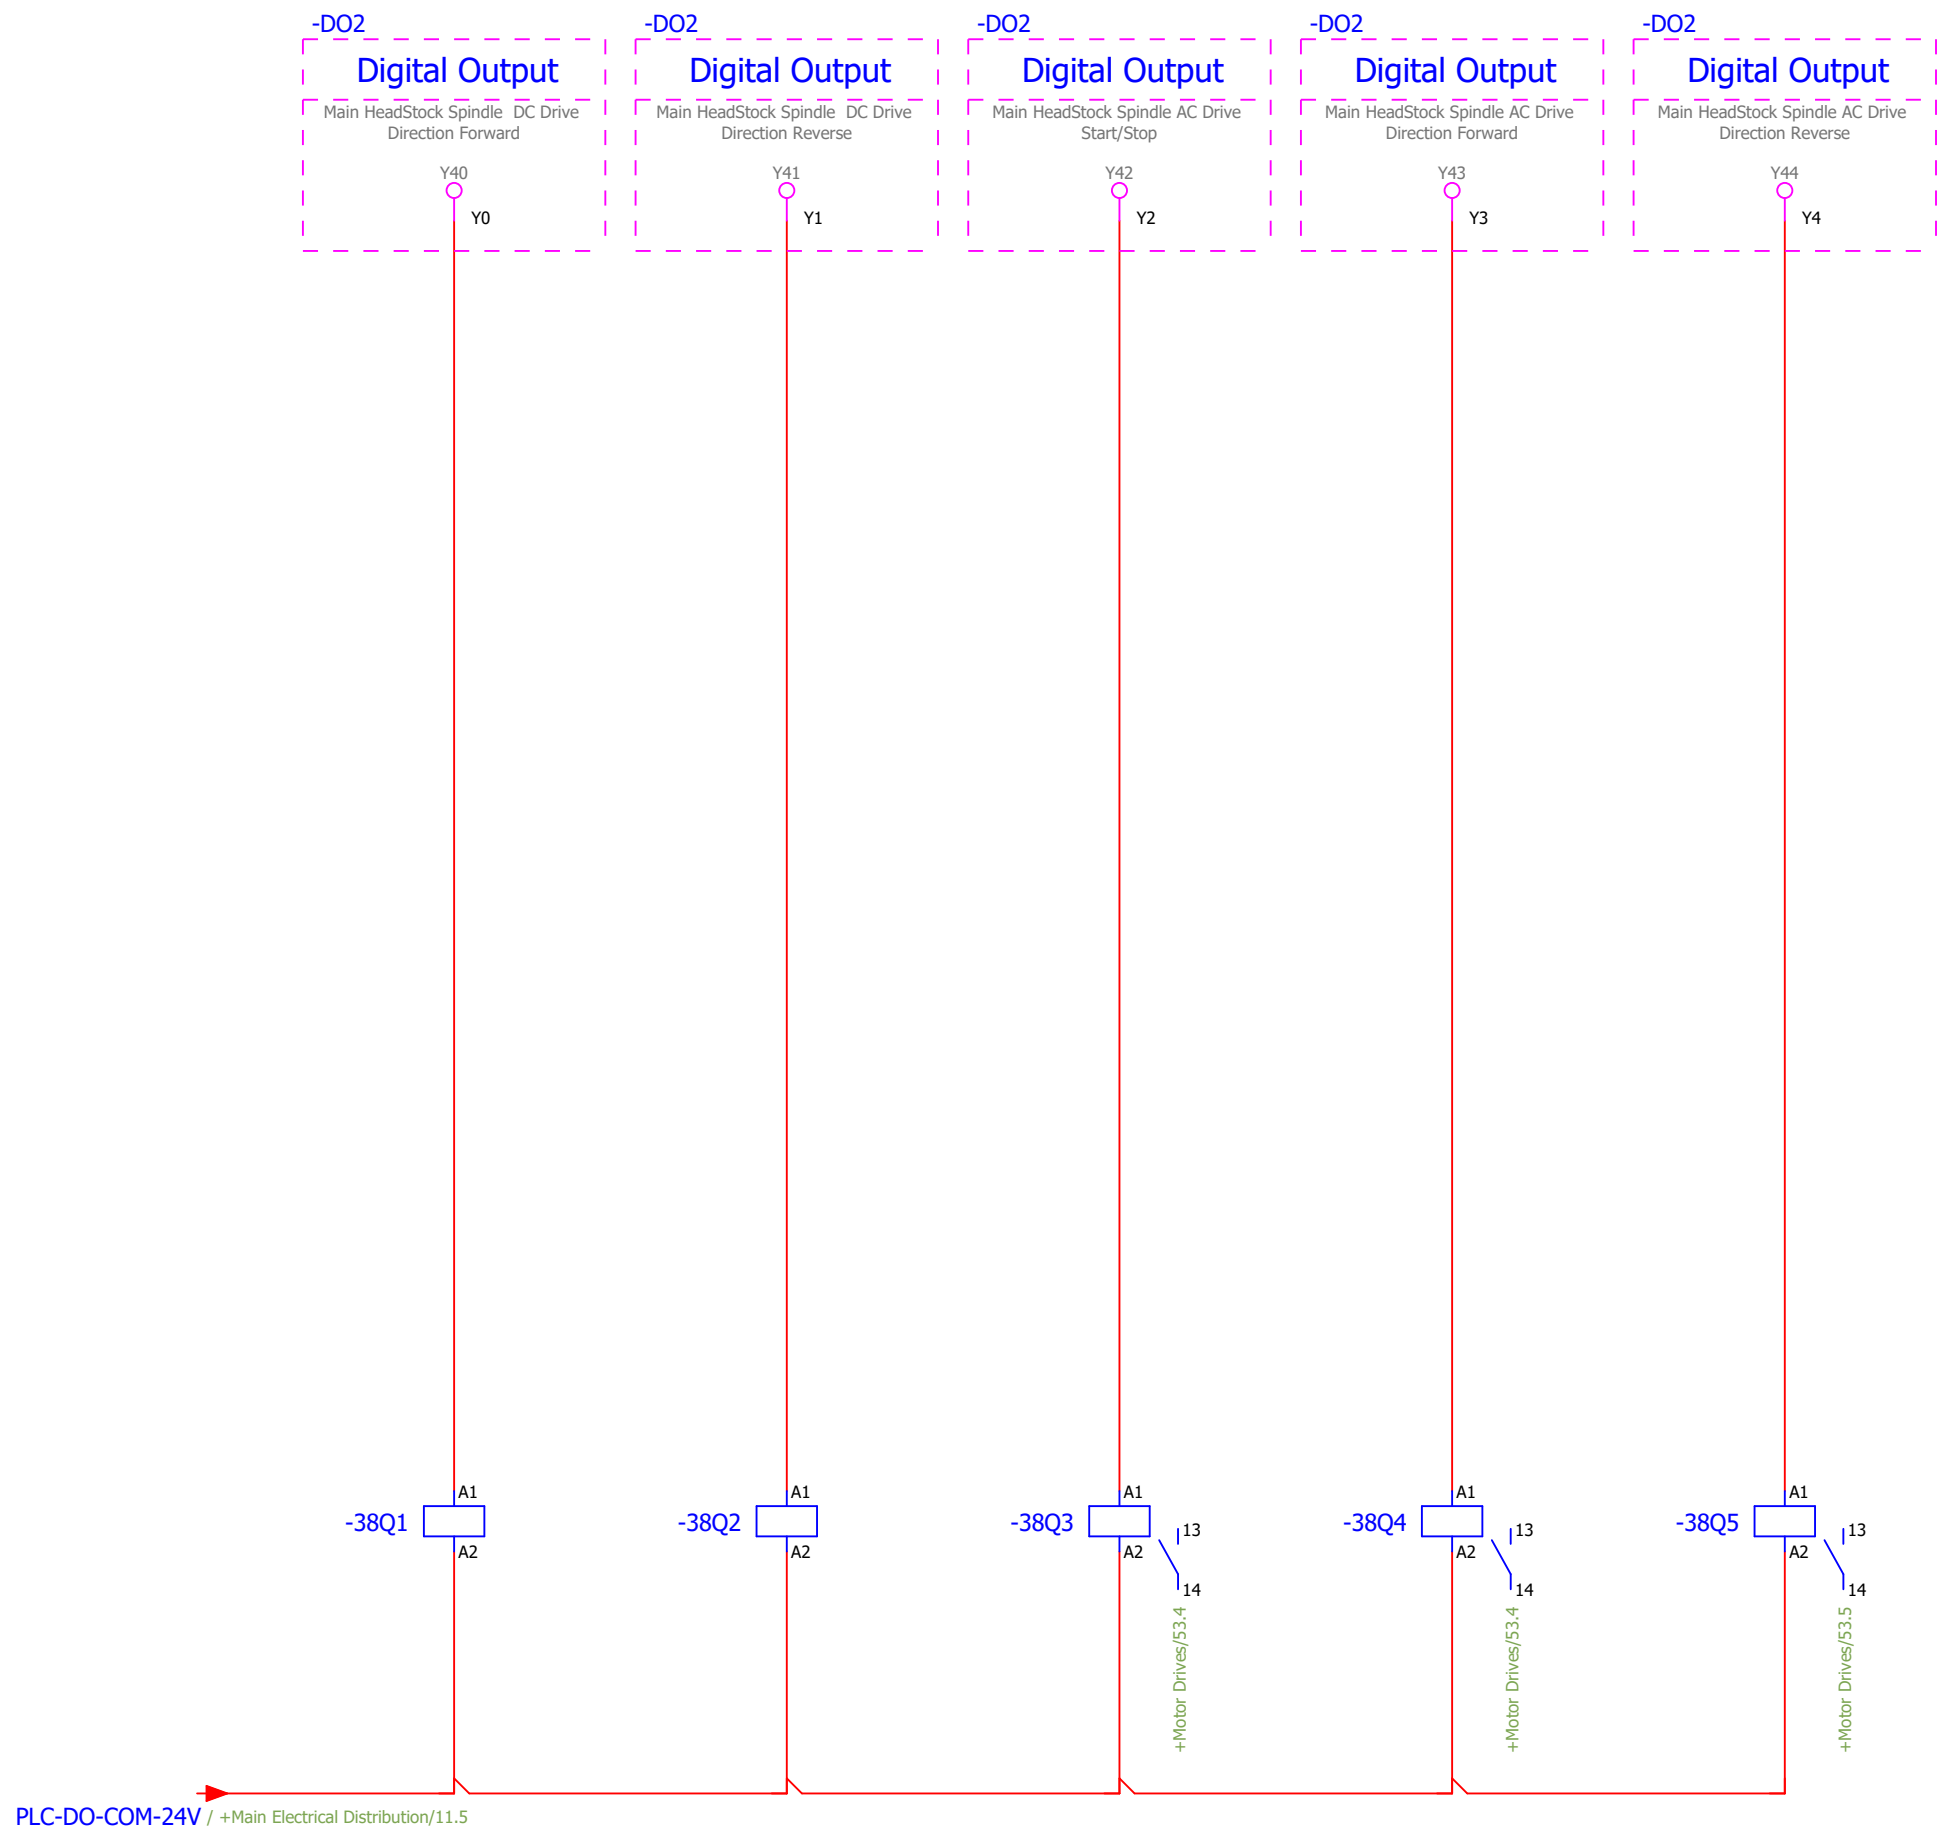




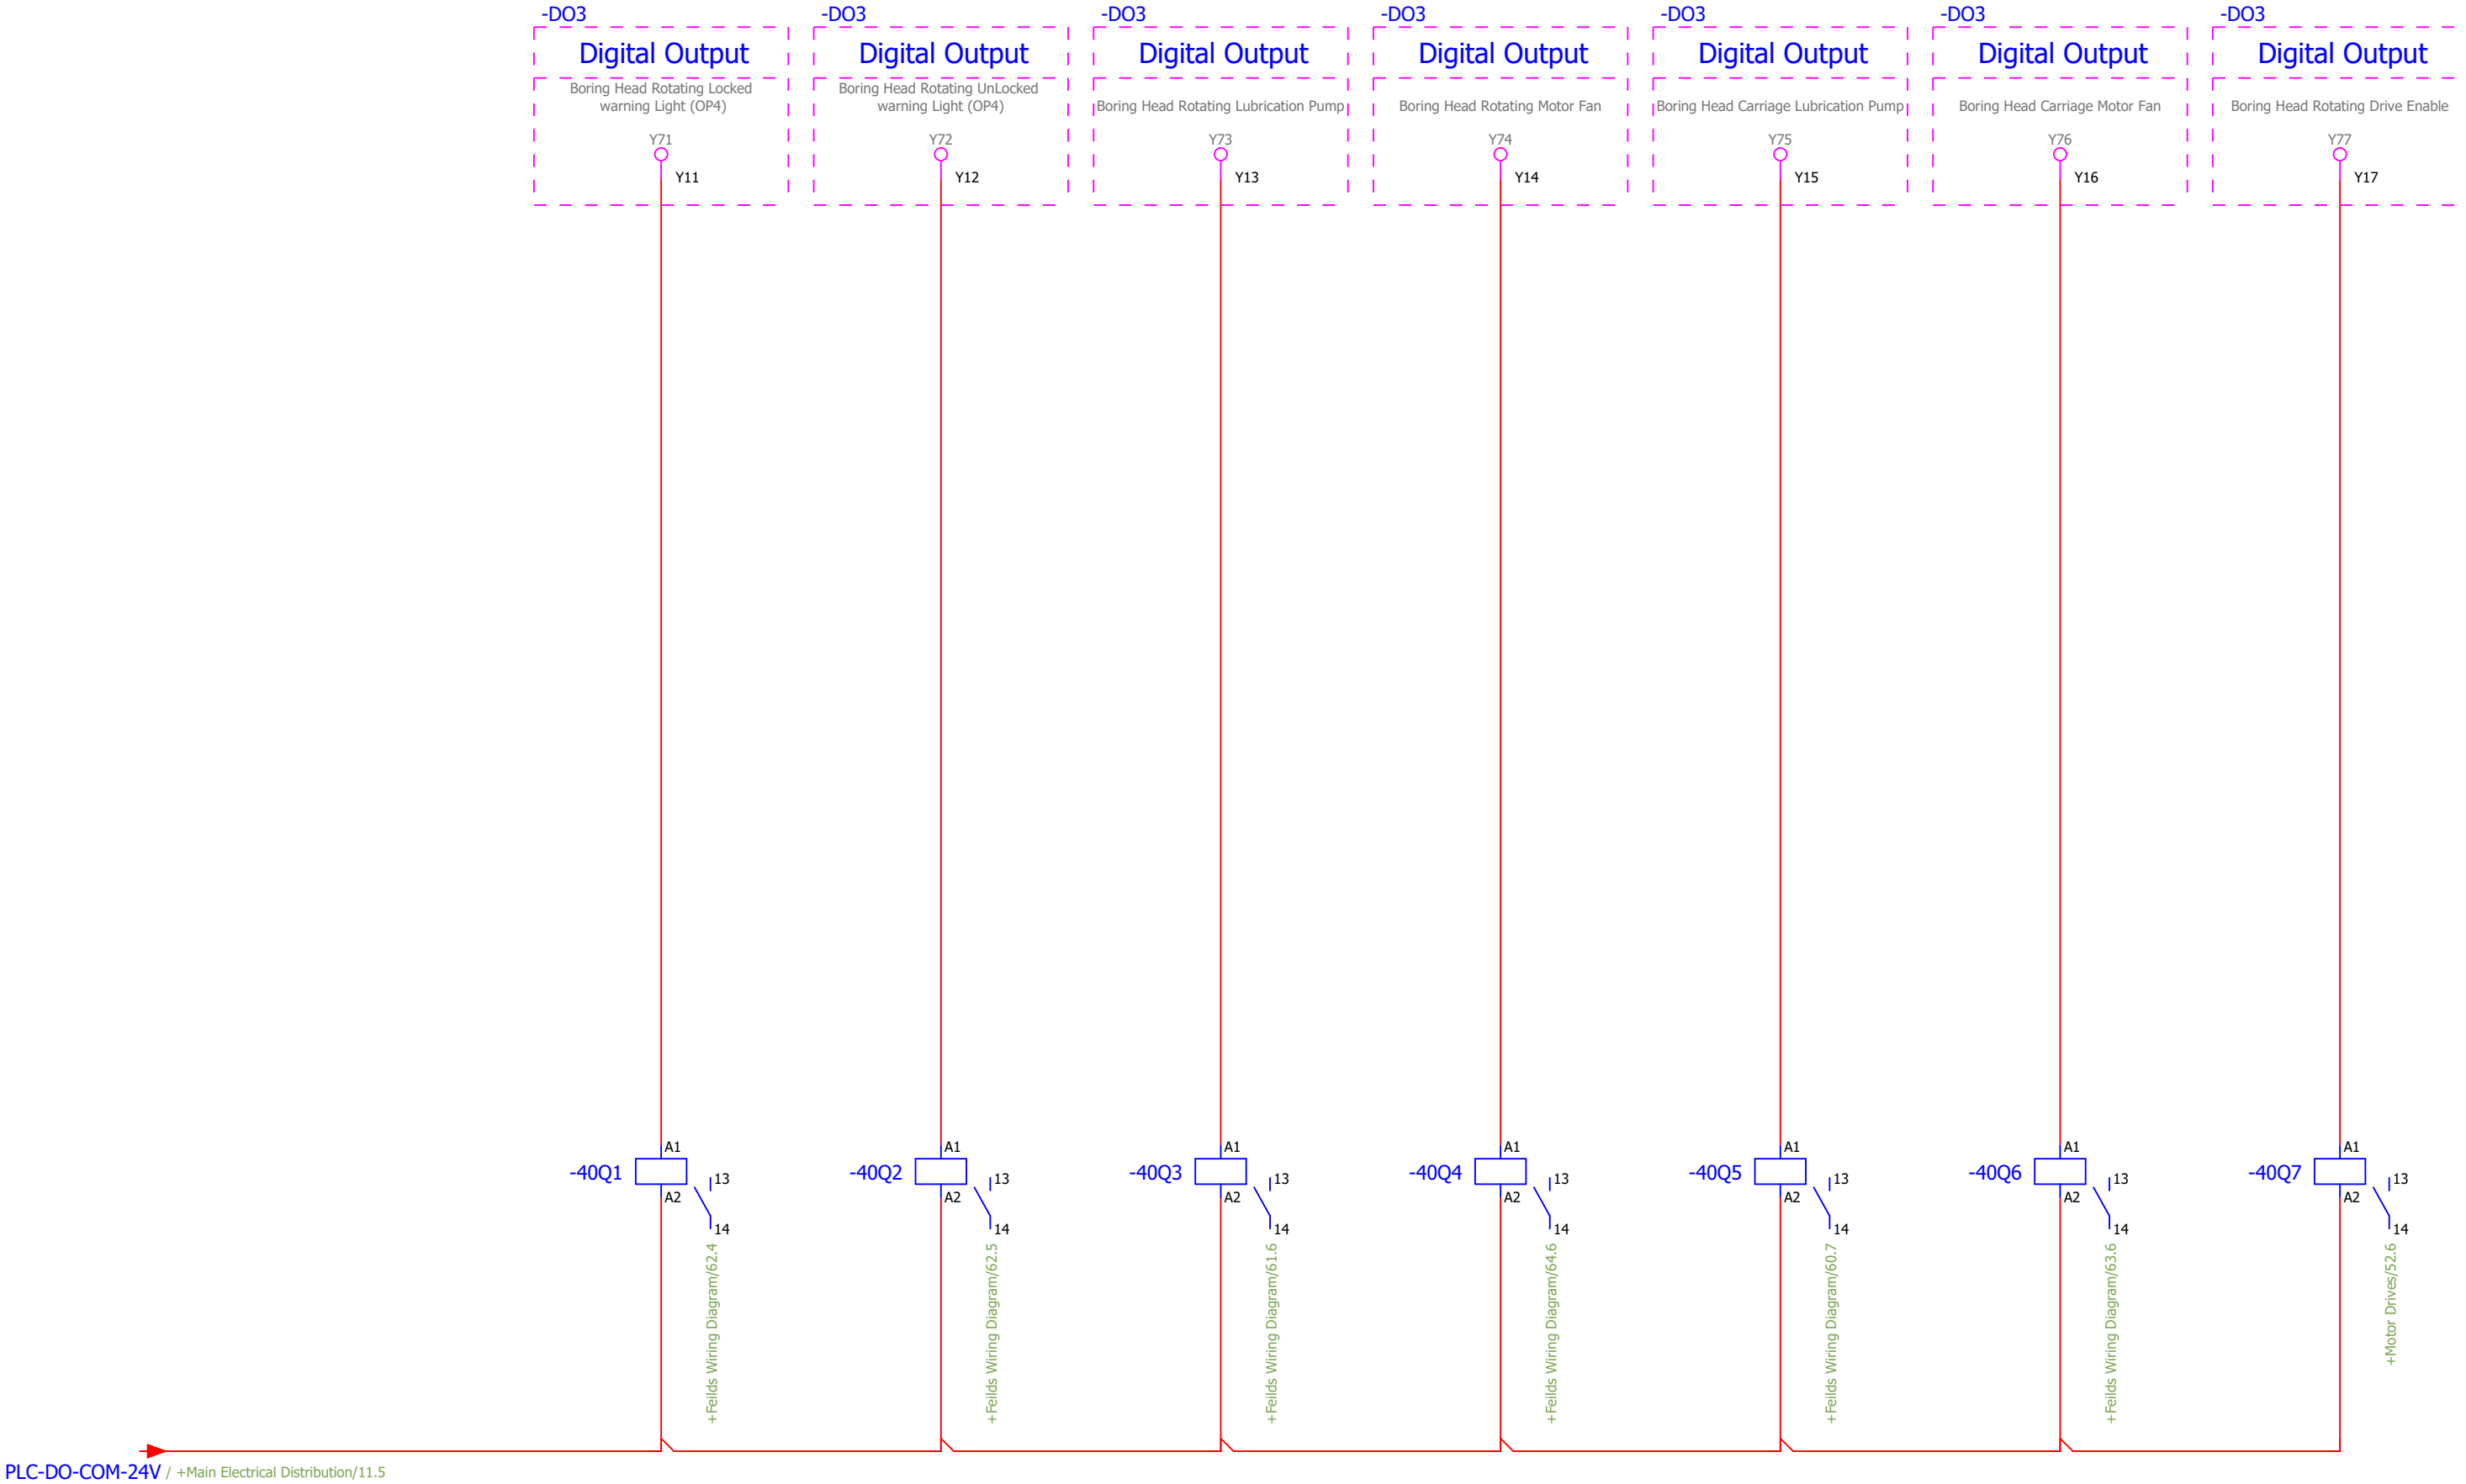


PLC-DO-COM-24V / +Main Electrical Distribution/11.5

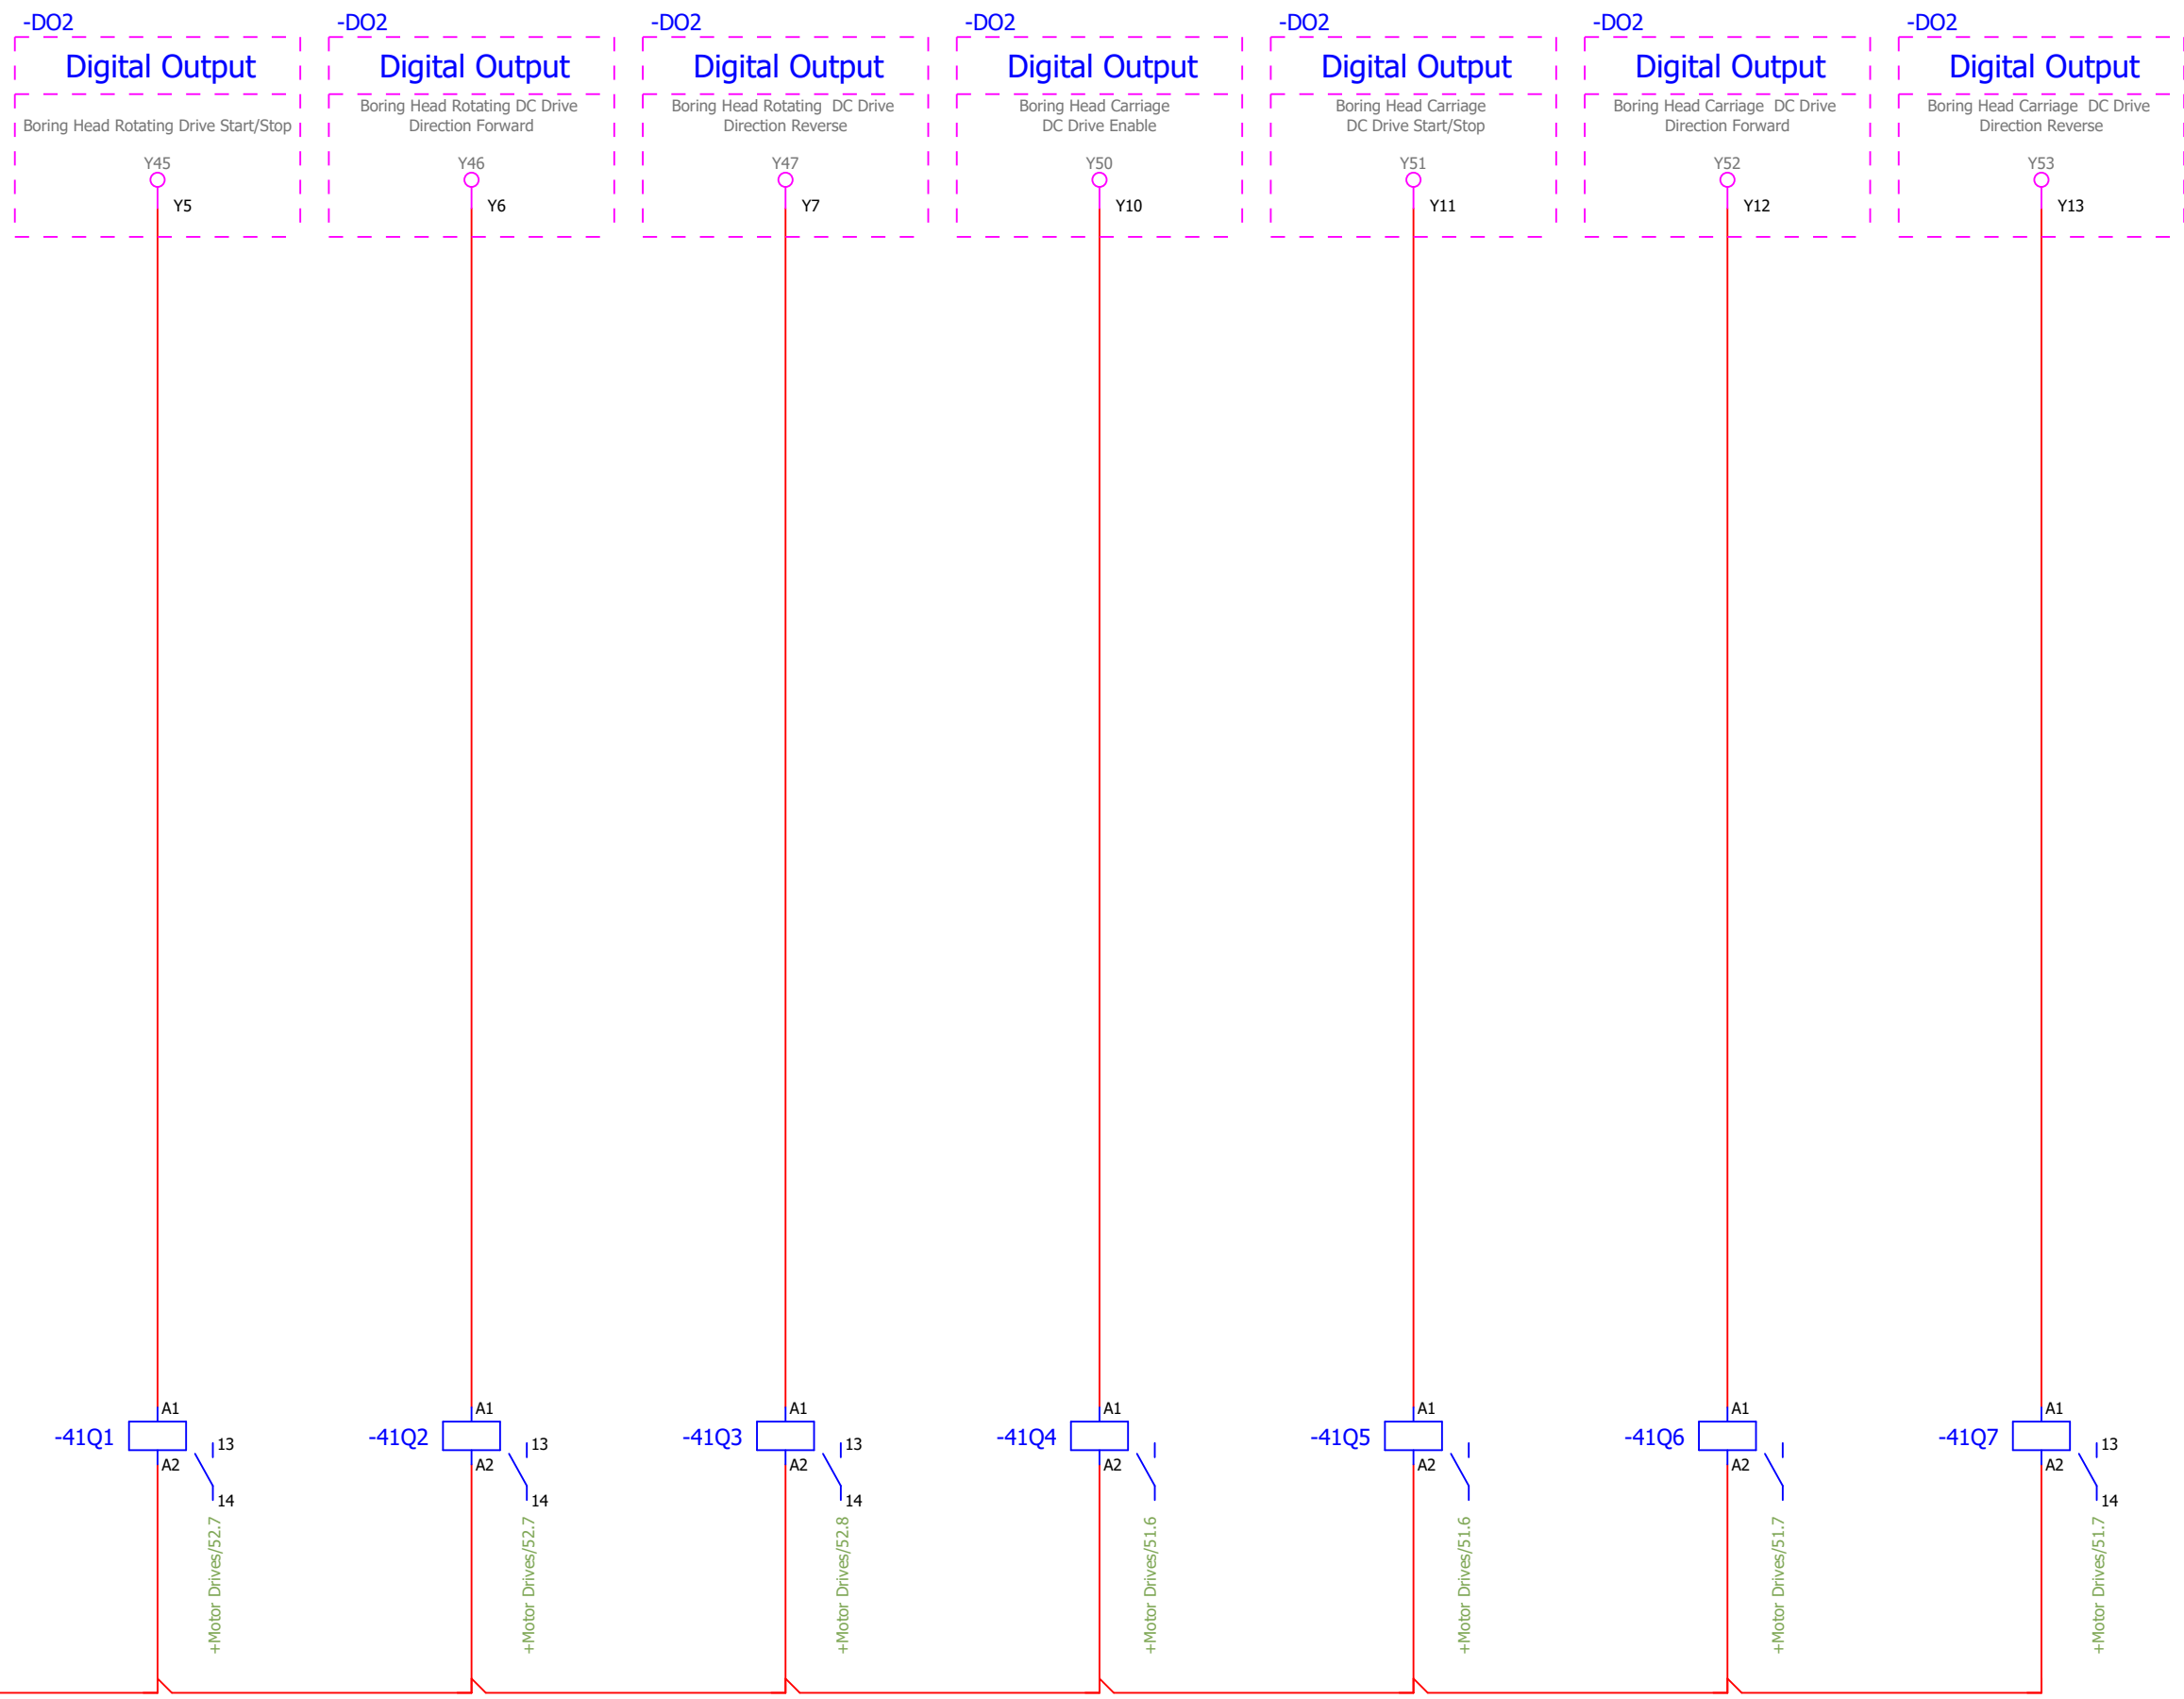


PLC-DO-COM-24V / +Main Electrical Distribution/11.5

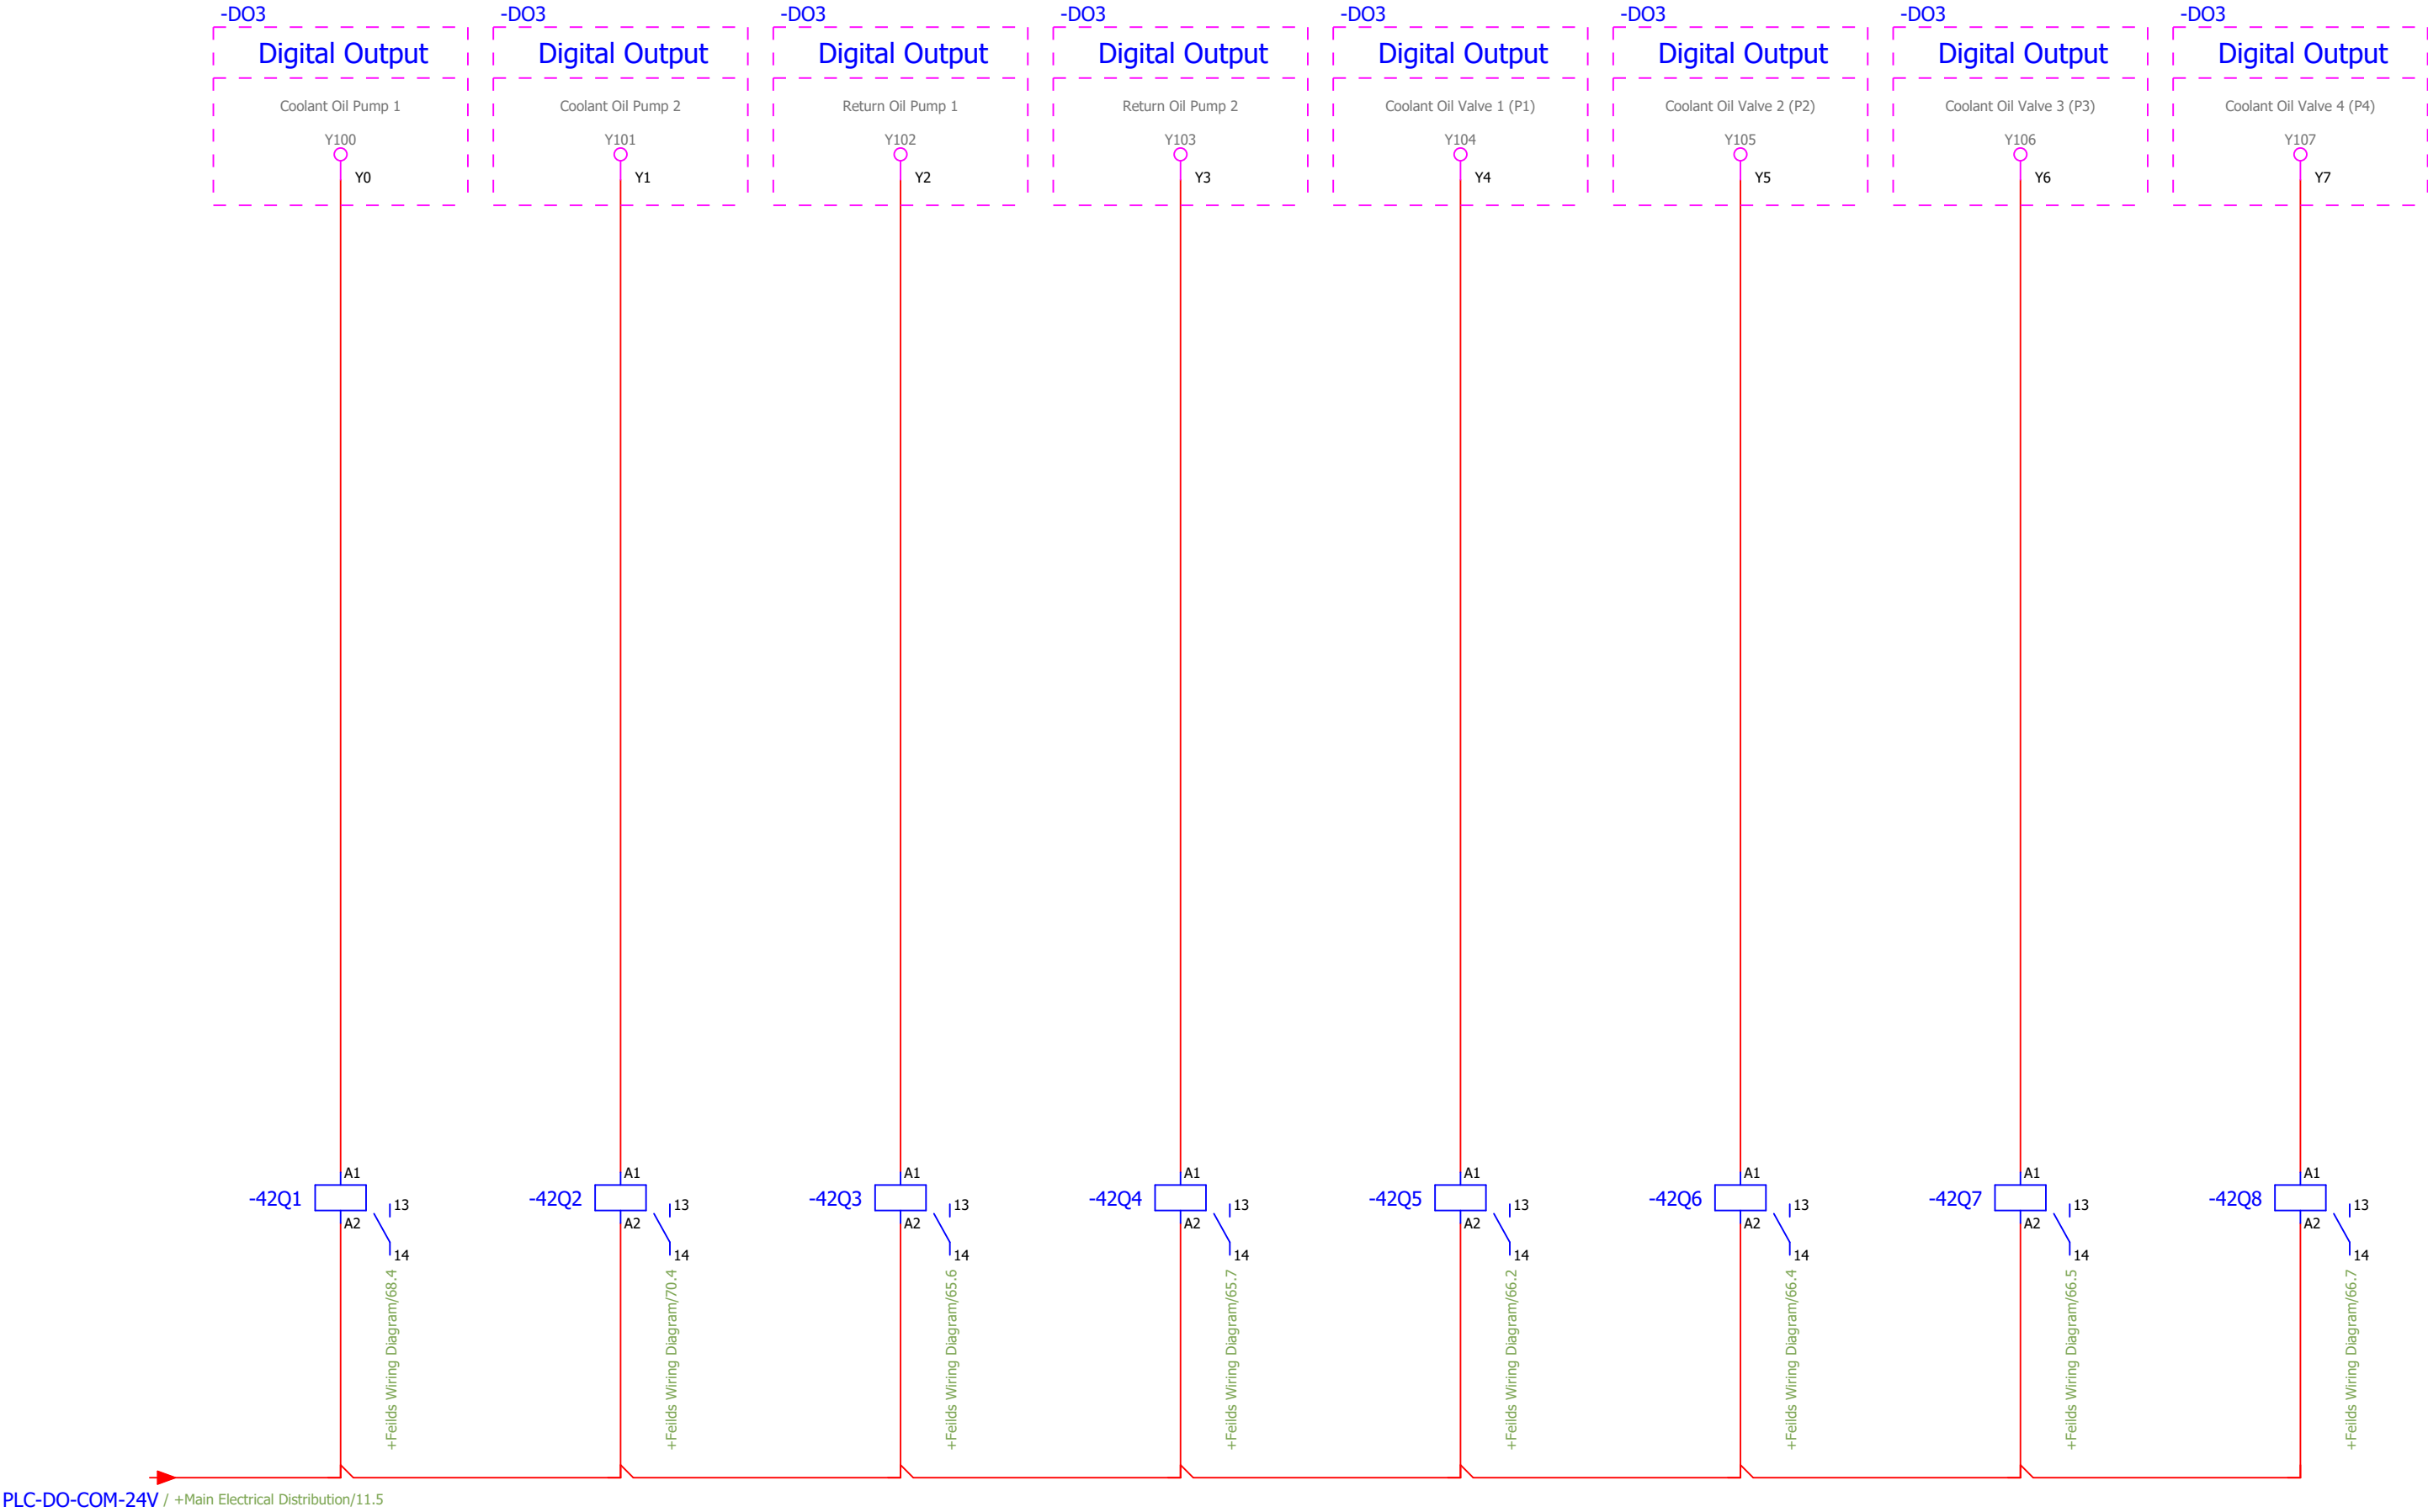







PLC-DO-COM-24V / +Main Electrical Distribution/11.5

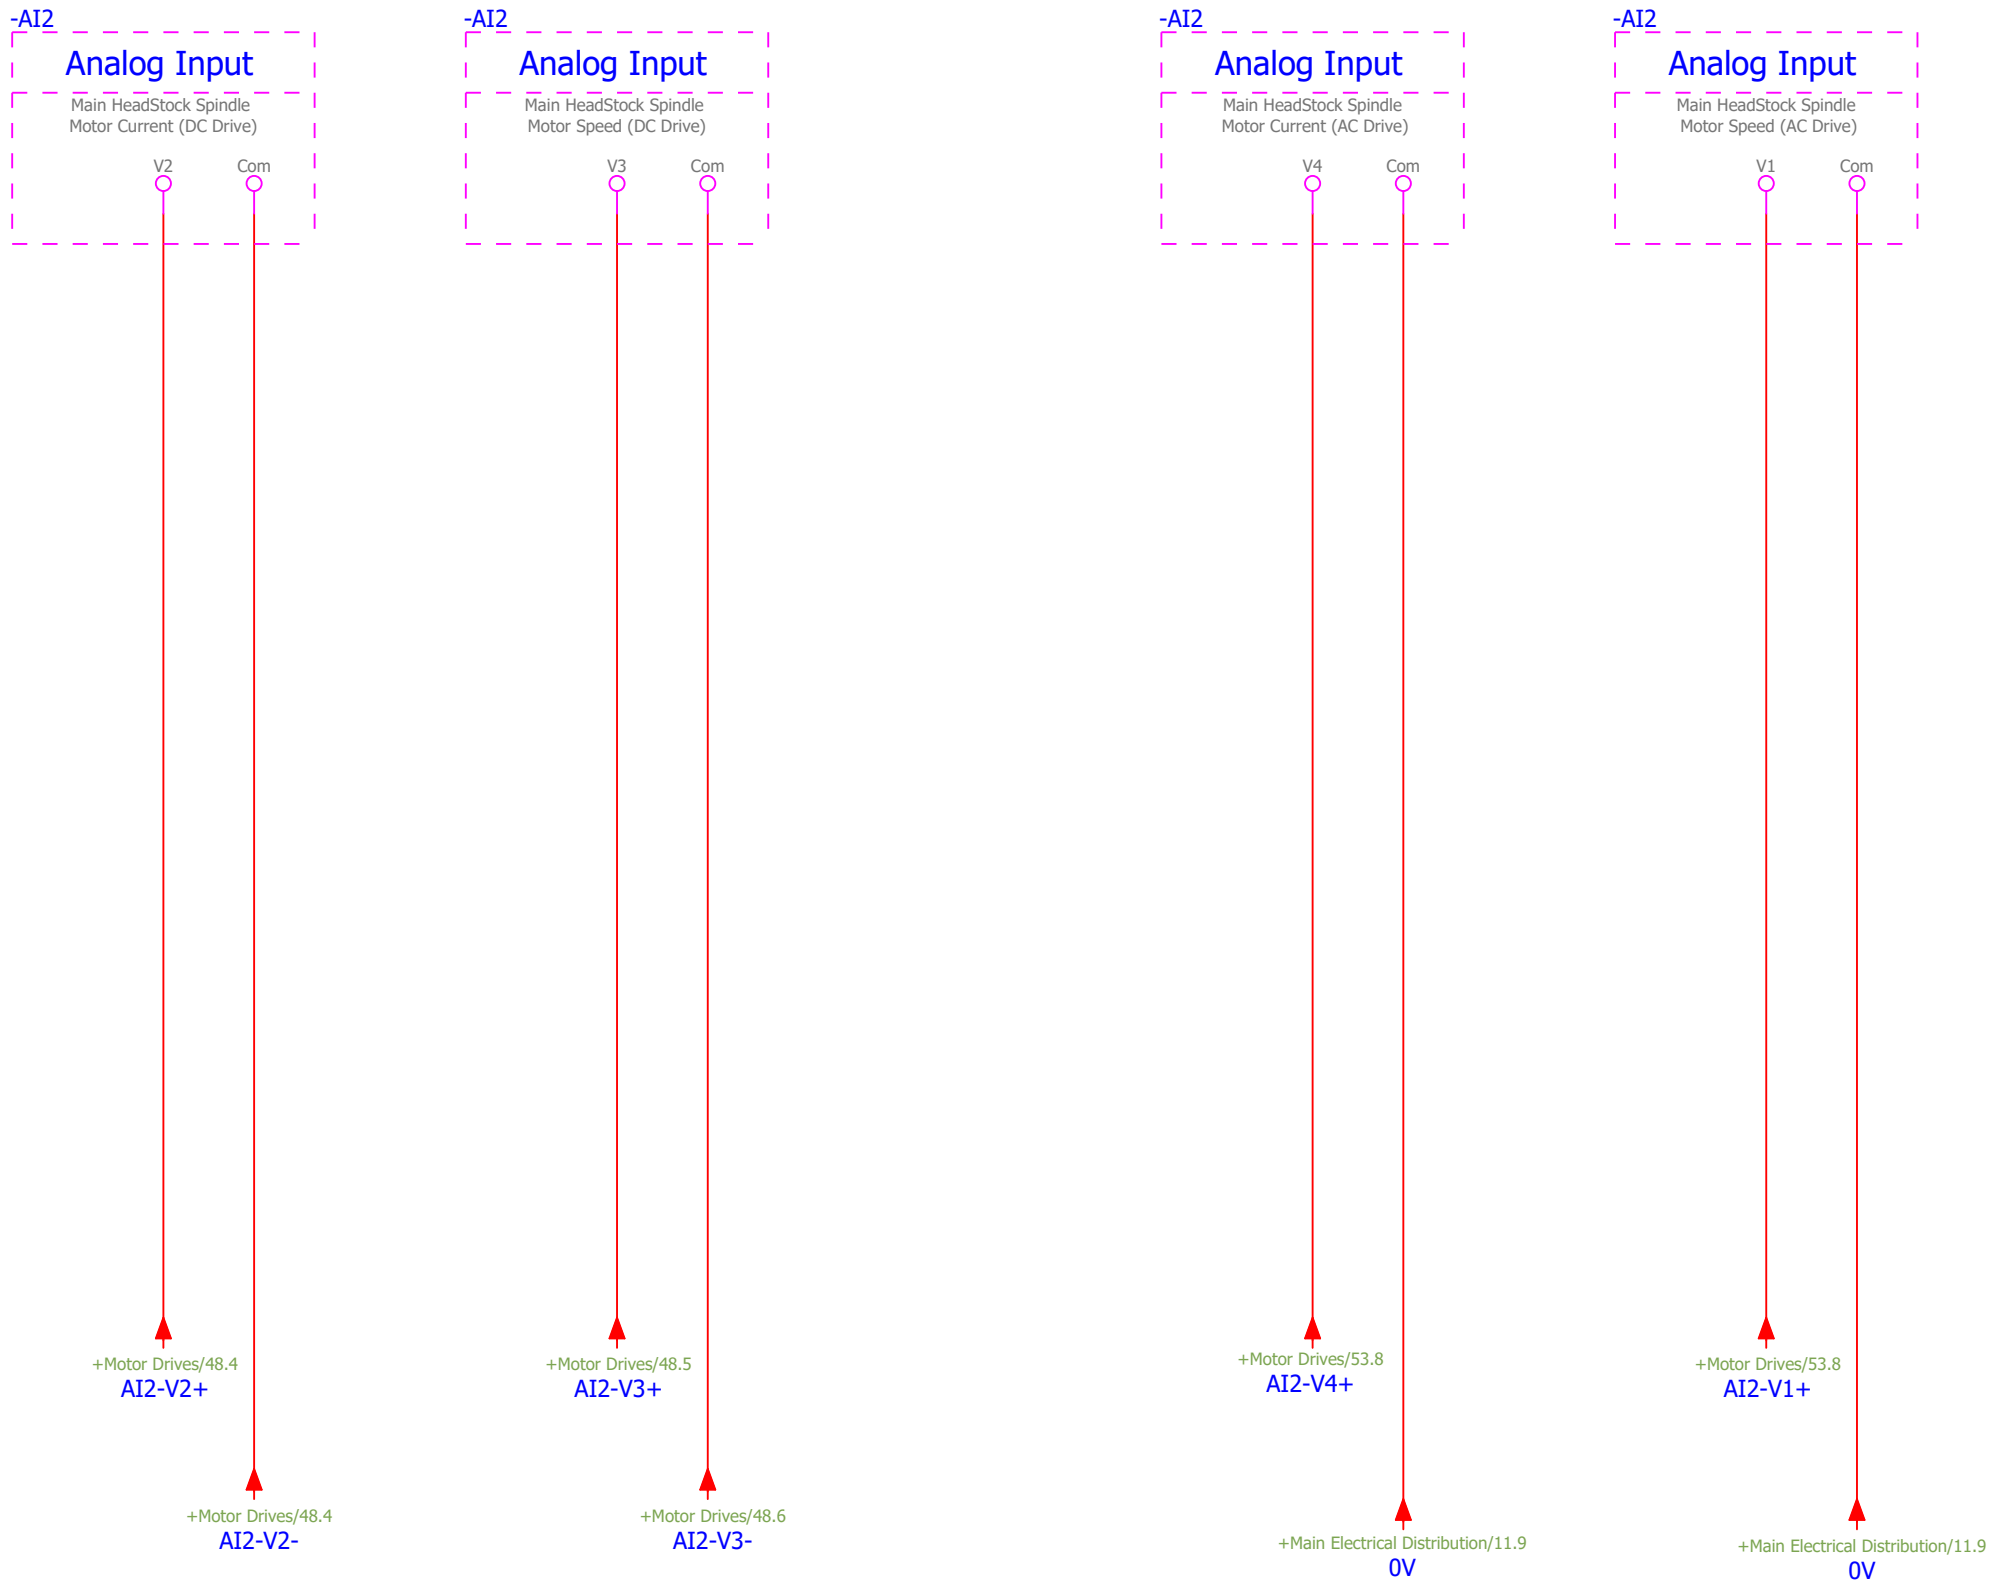


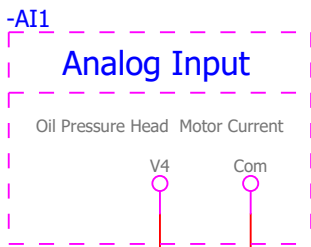



+Motor Drives/50.2
AI3-V1+


+Motor Drives/50.2
AI3-V1-

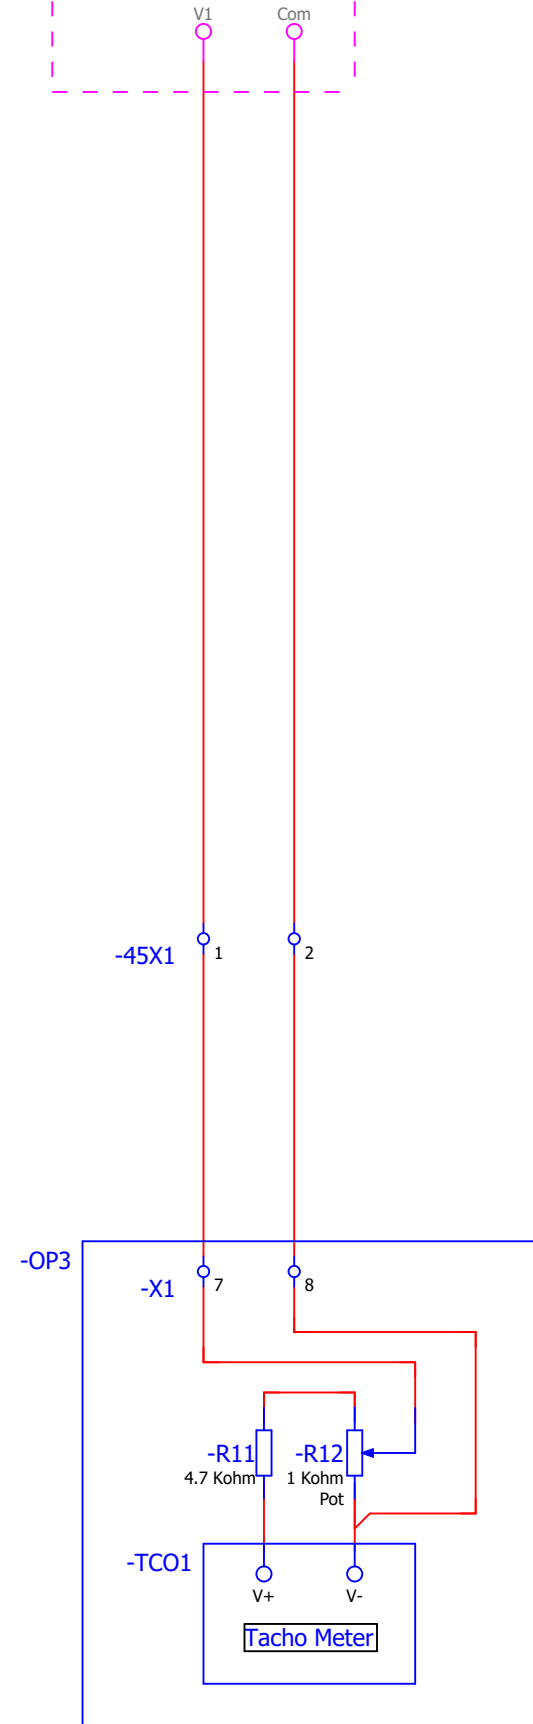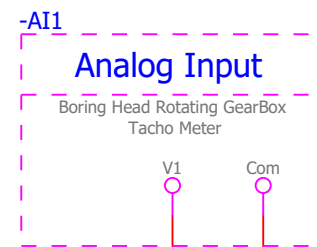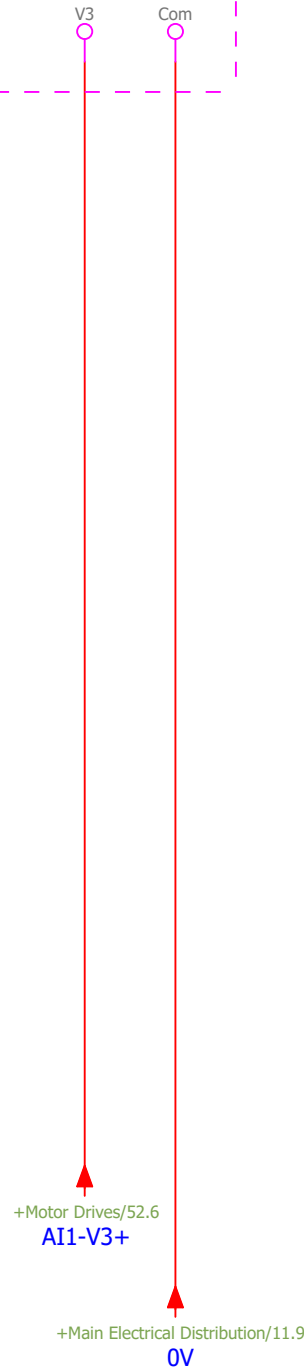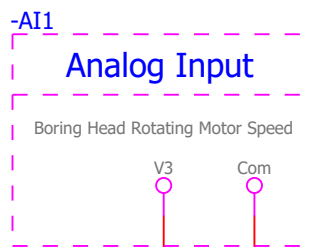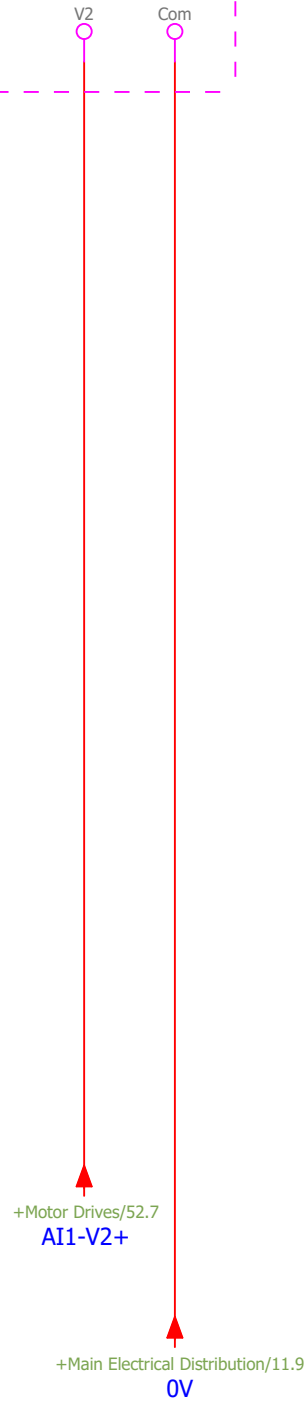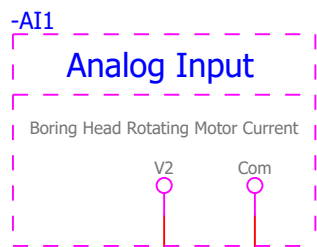


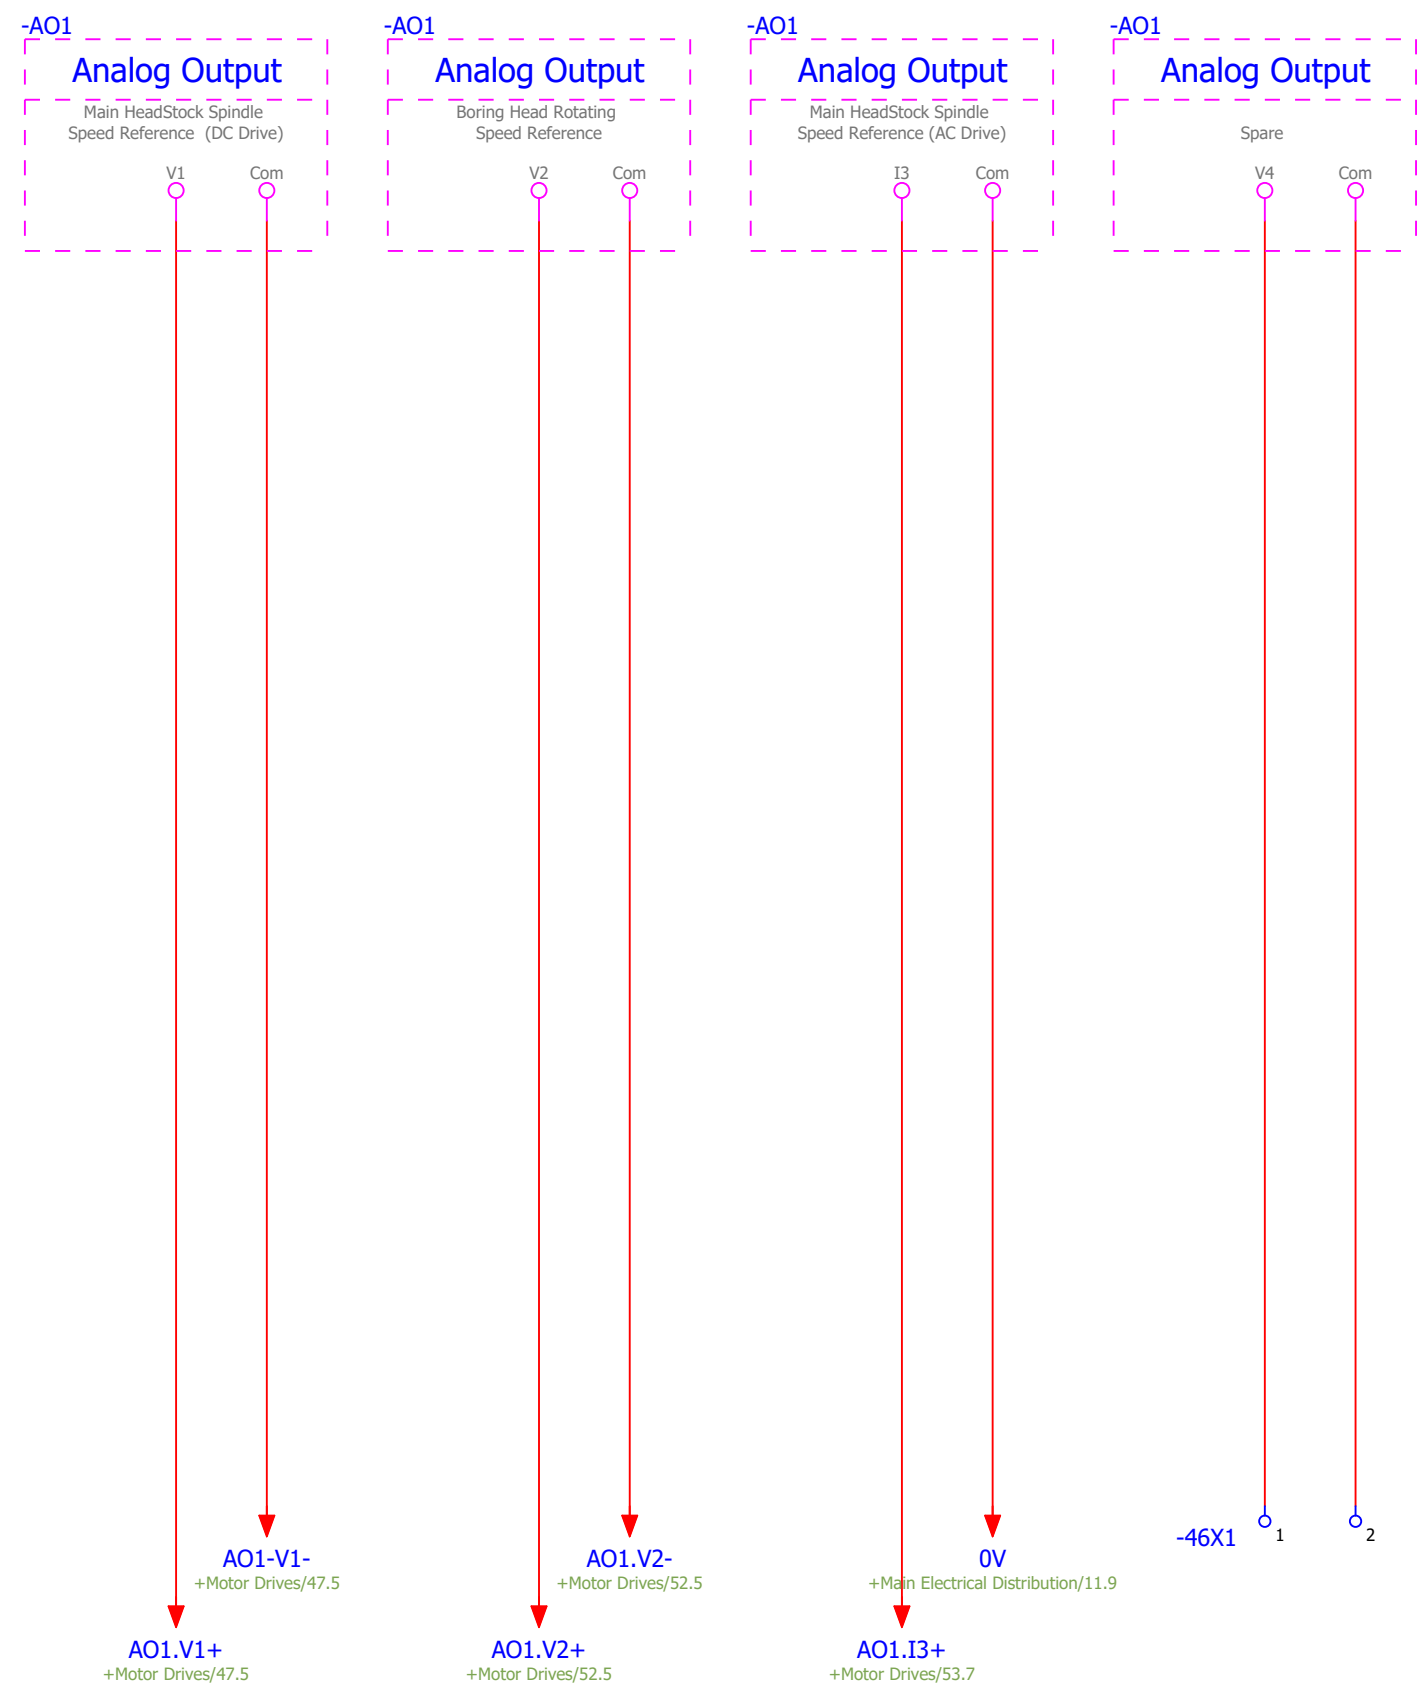


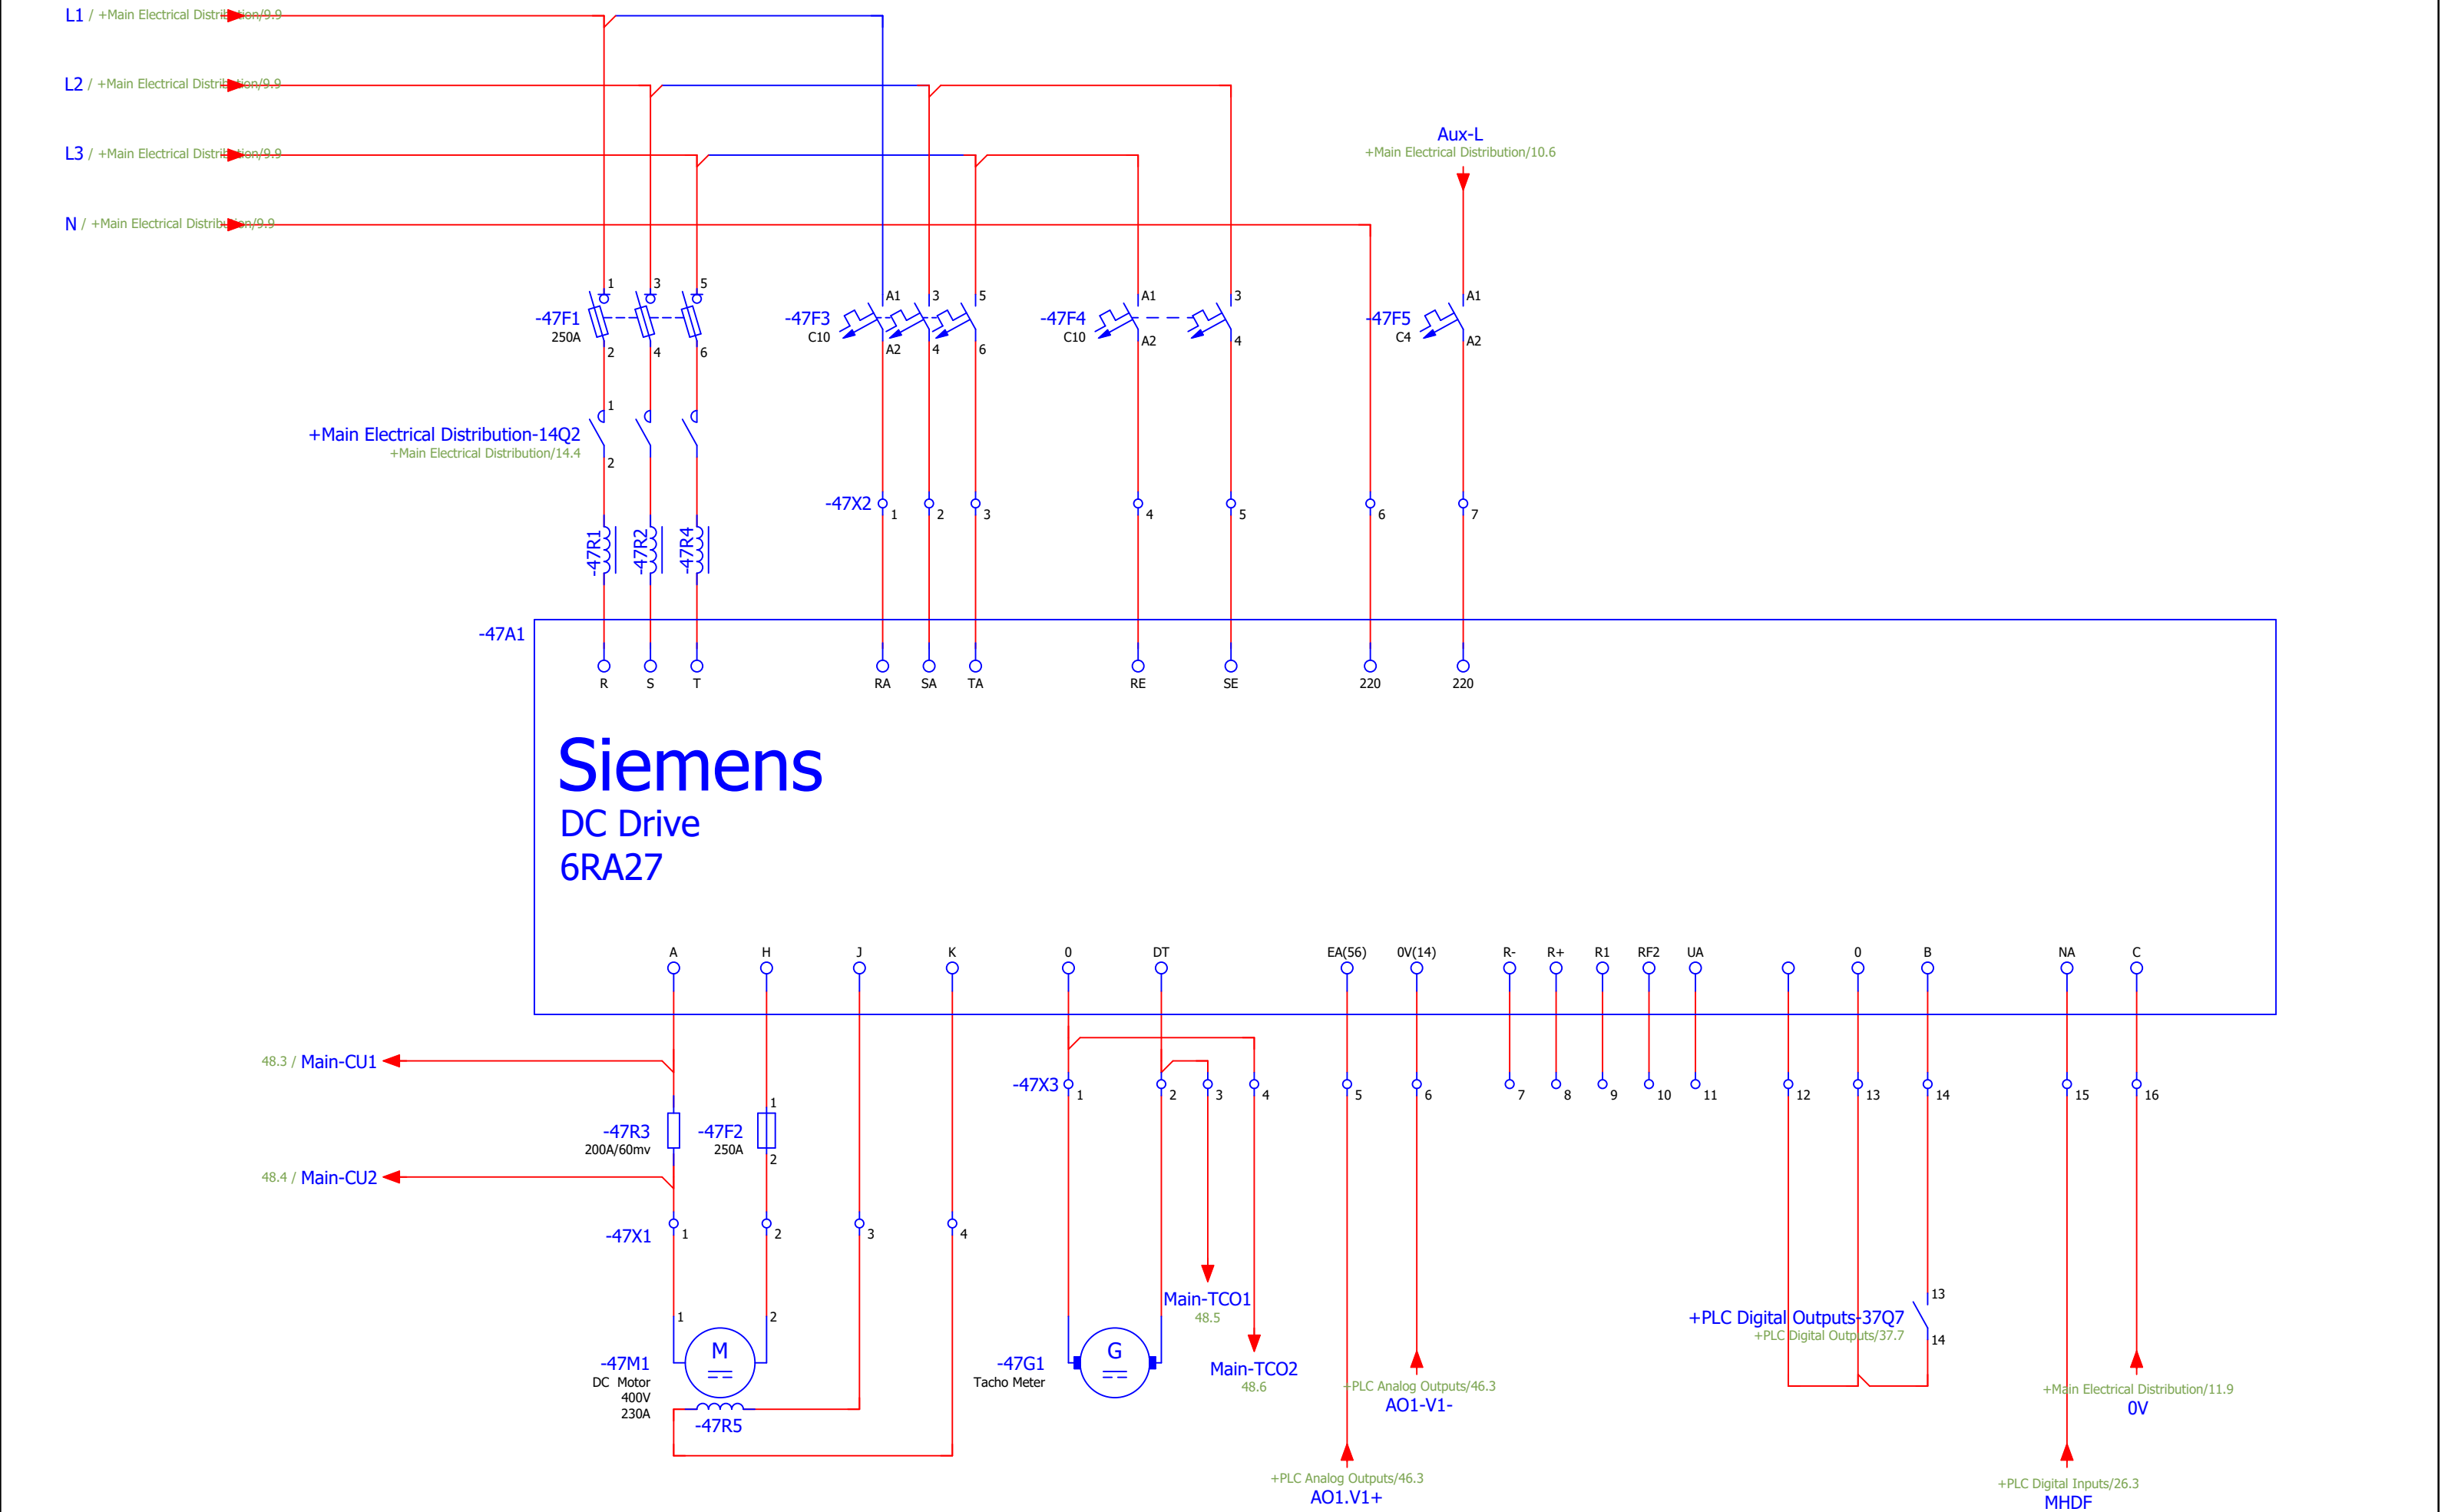


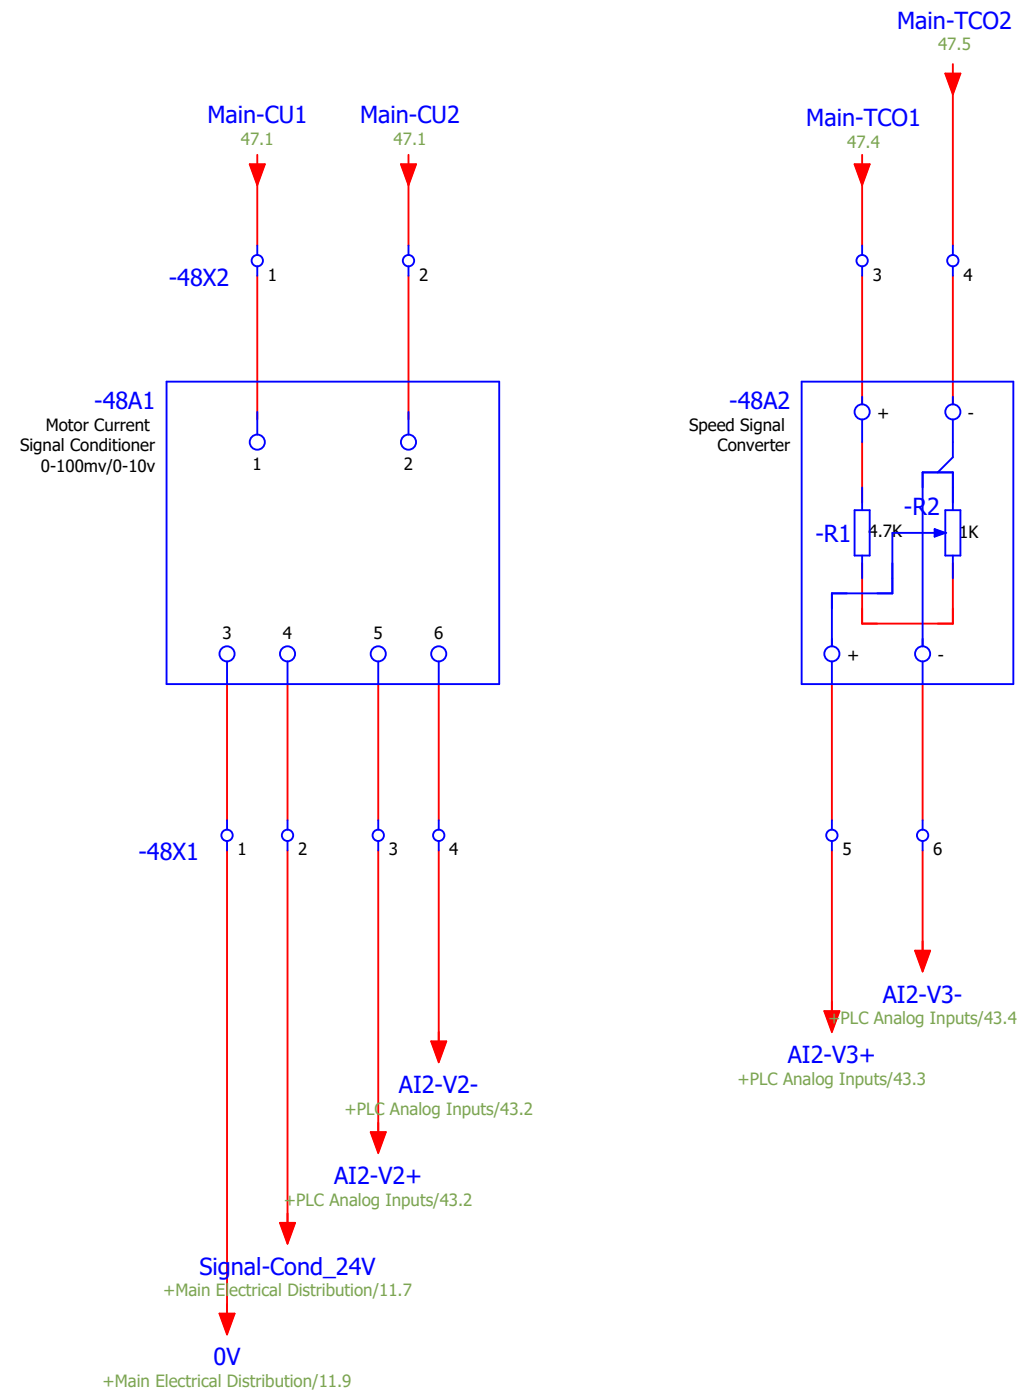

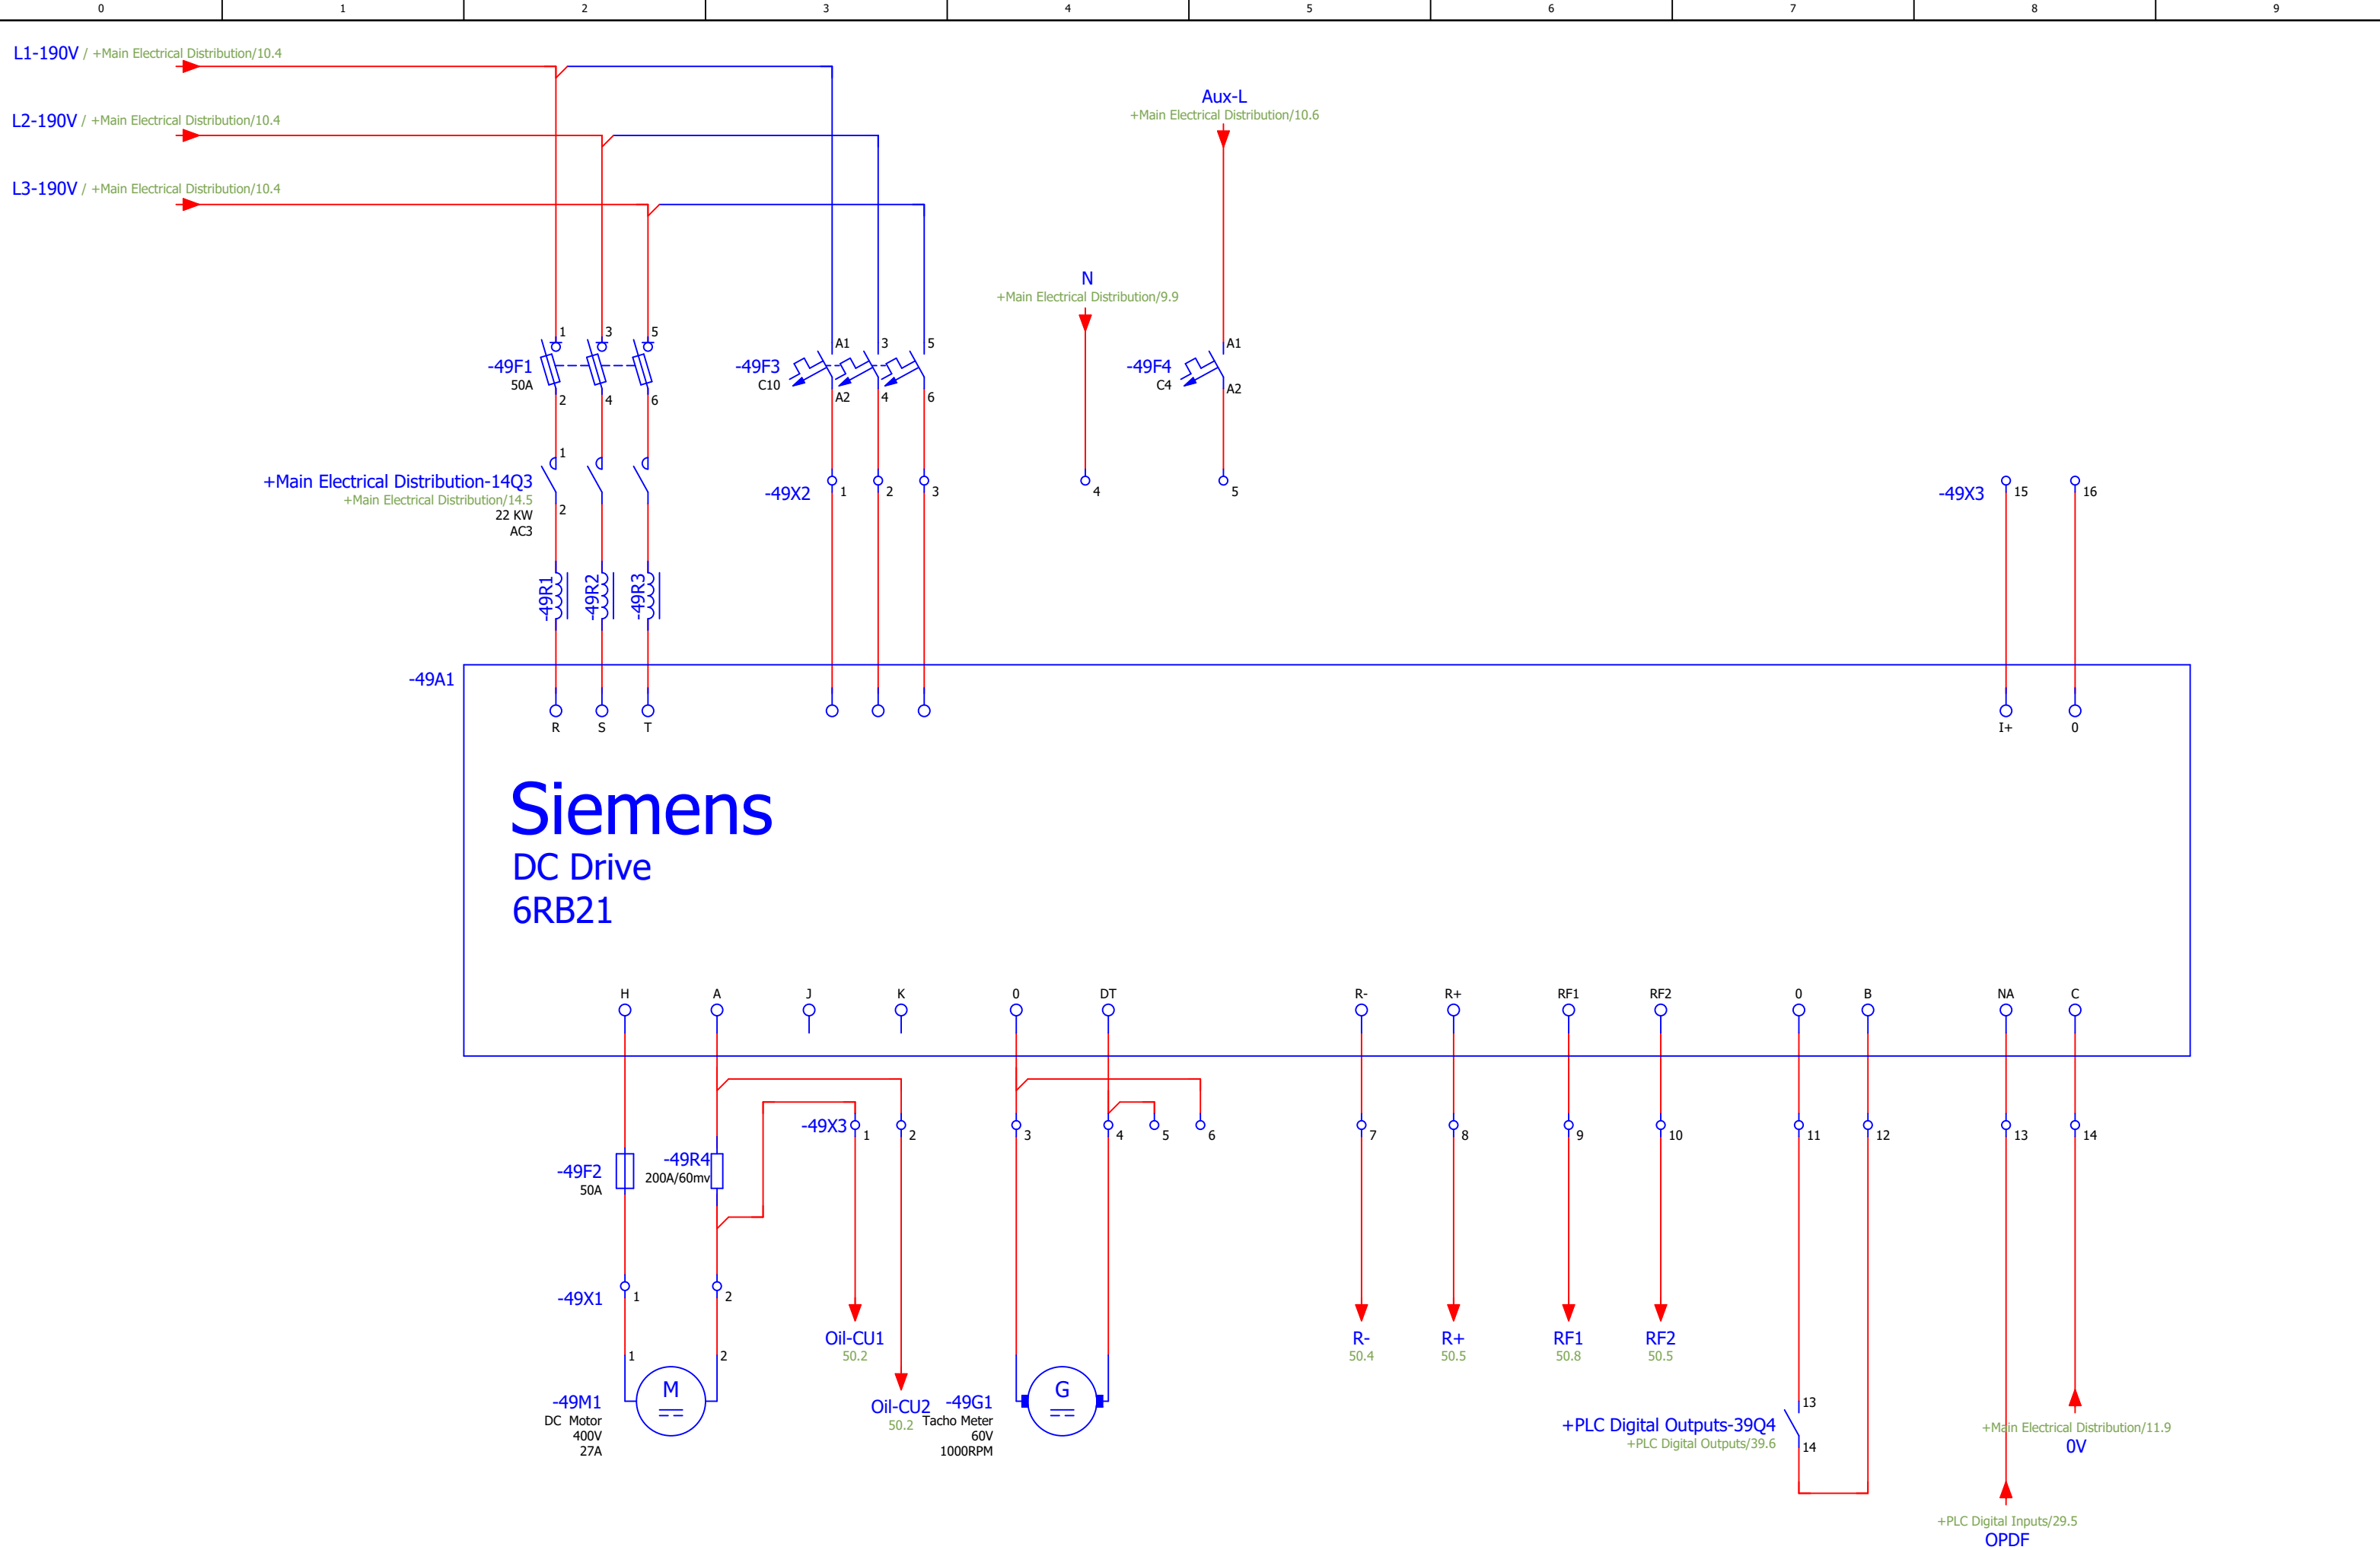


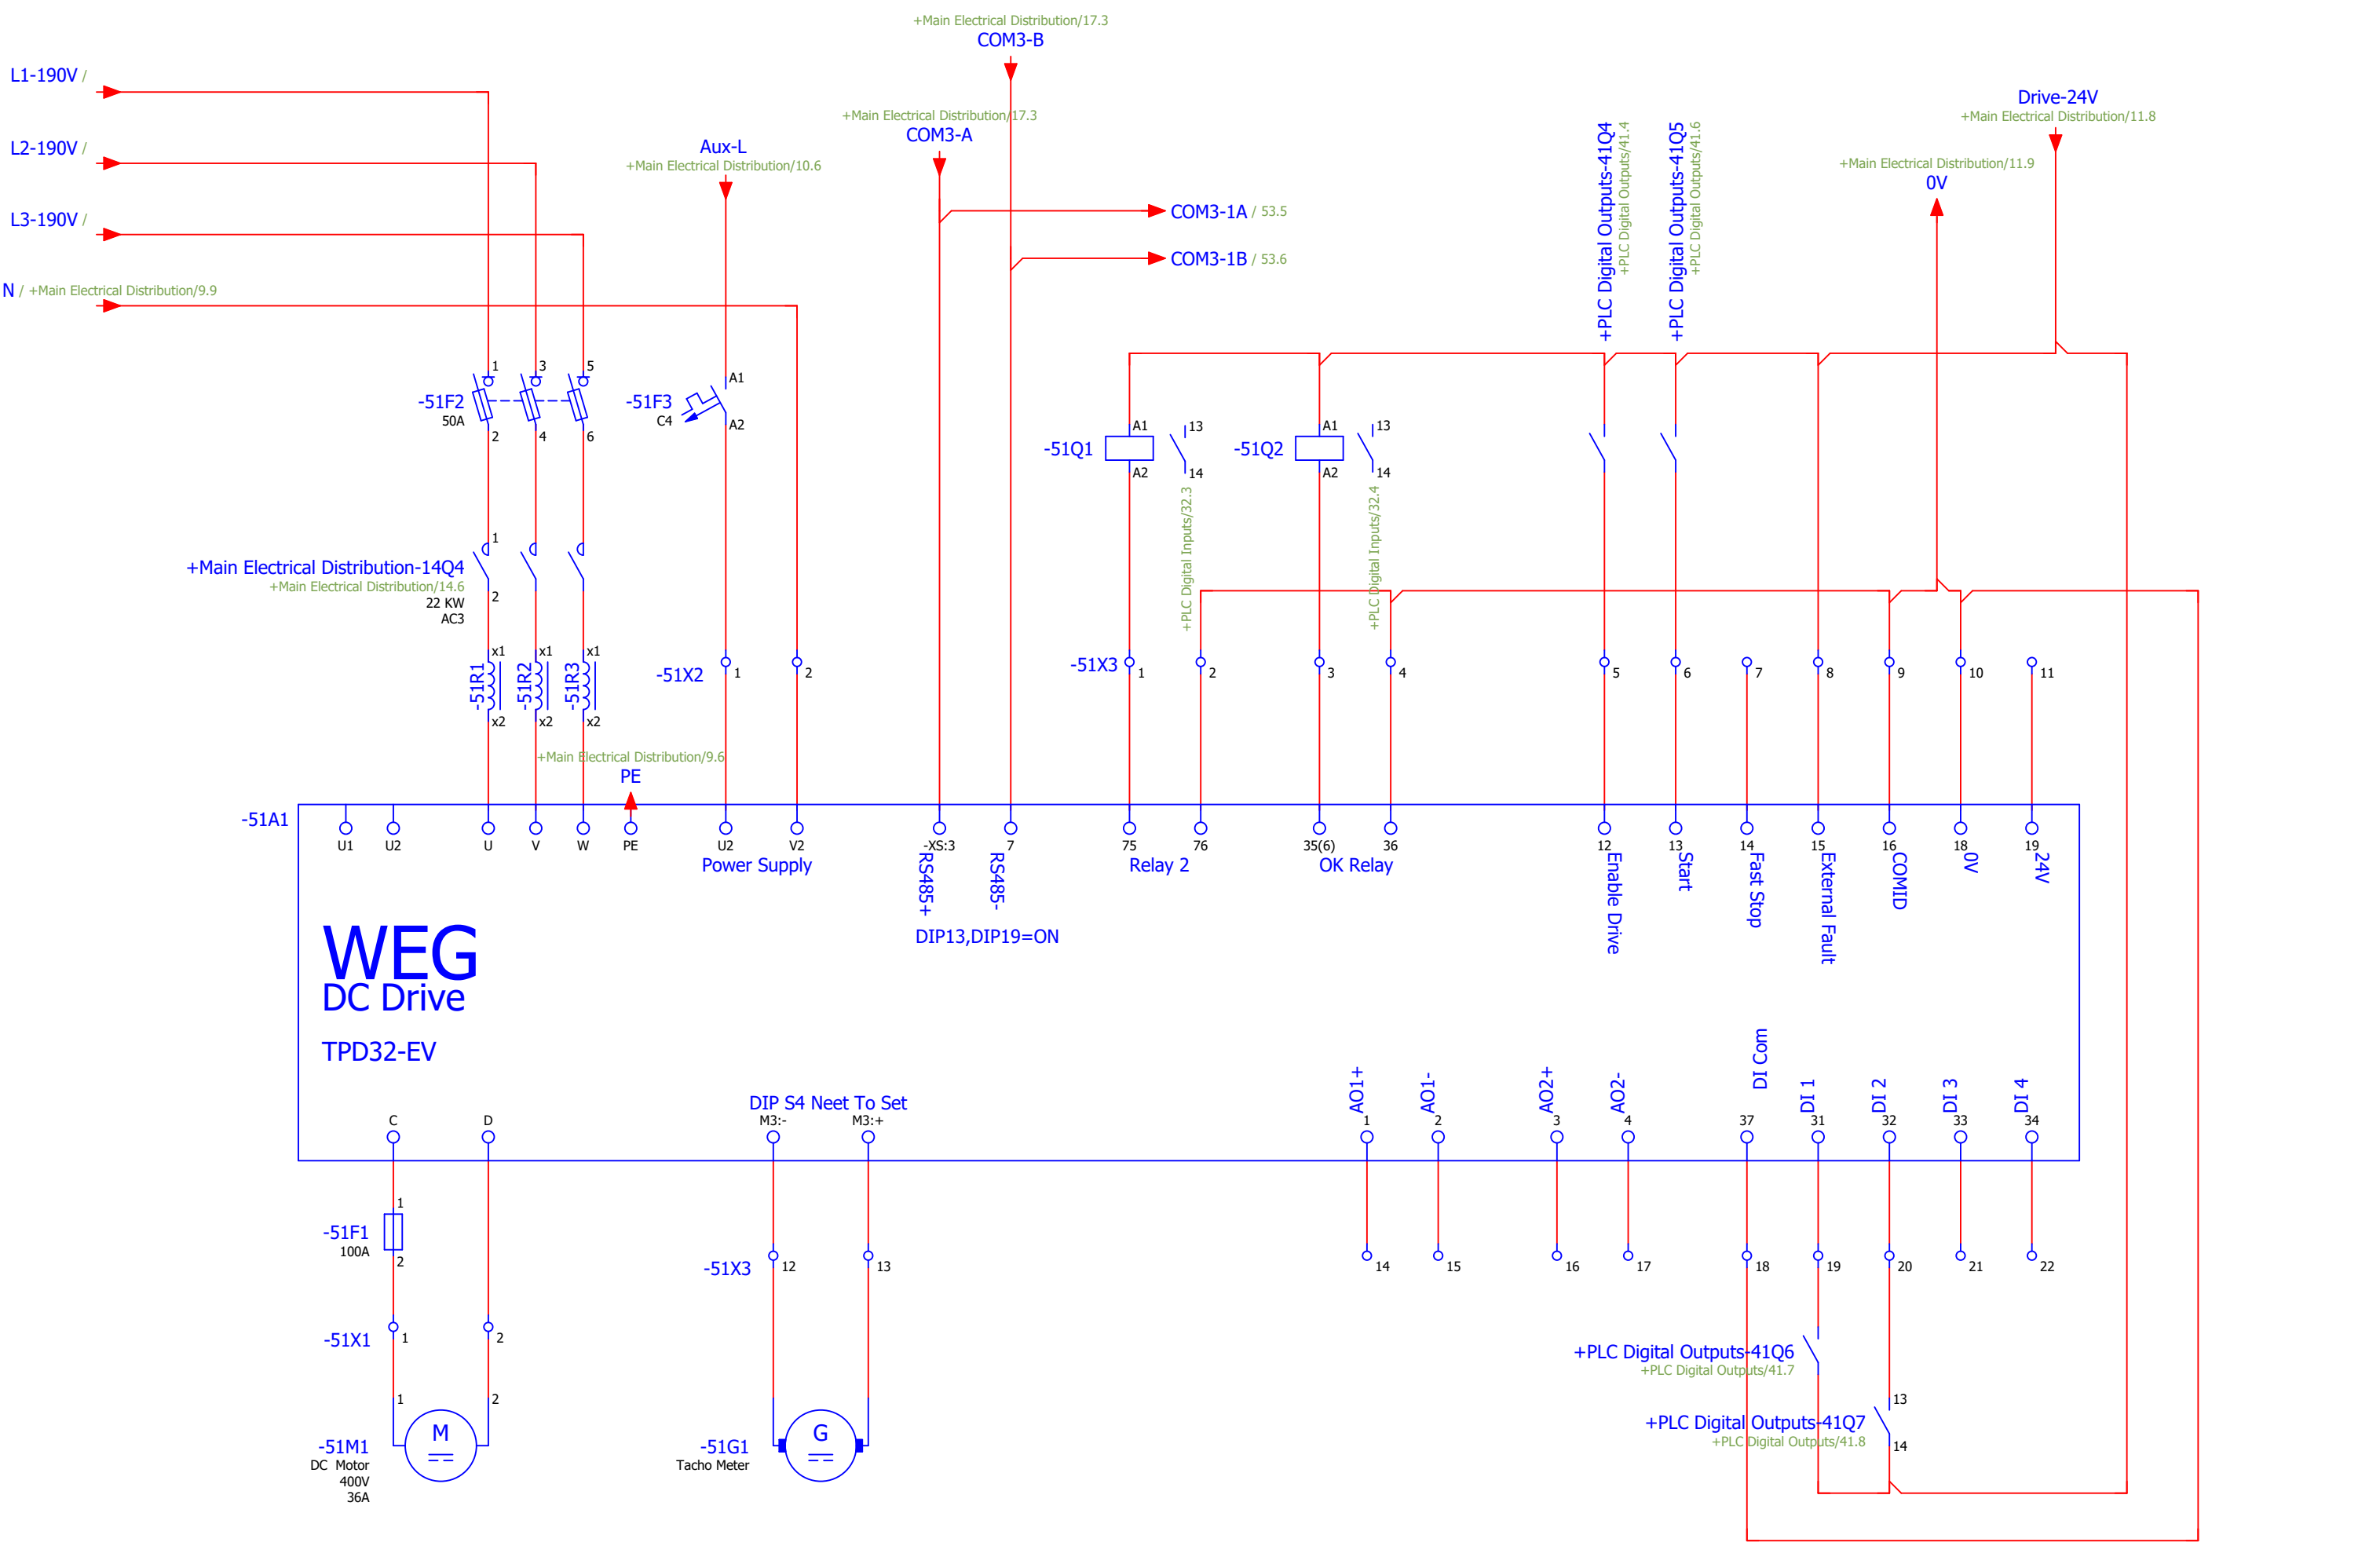


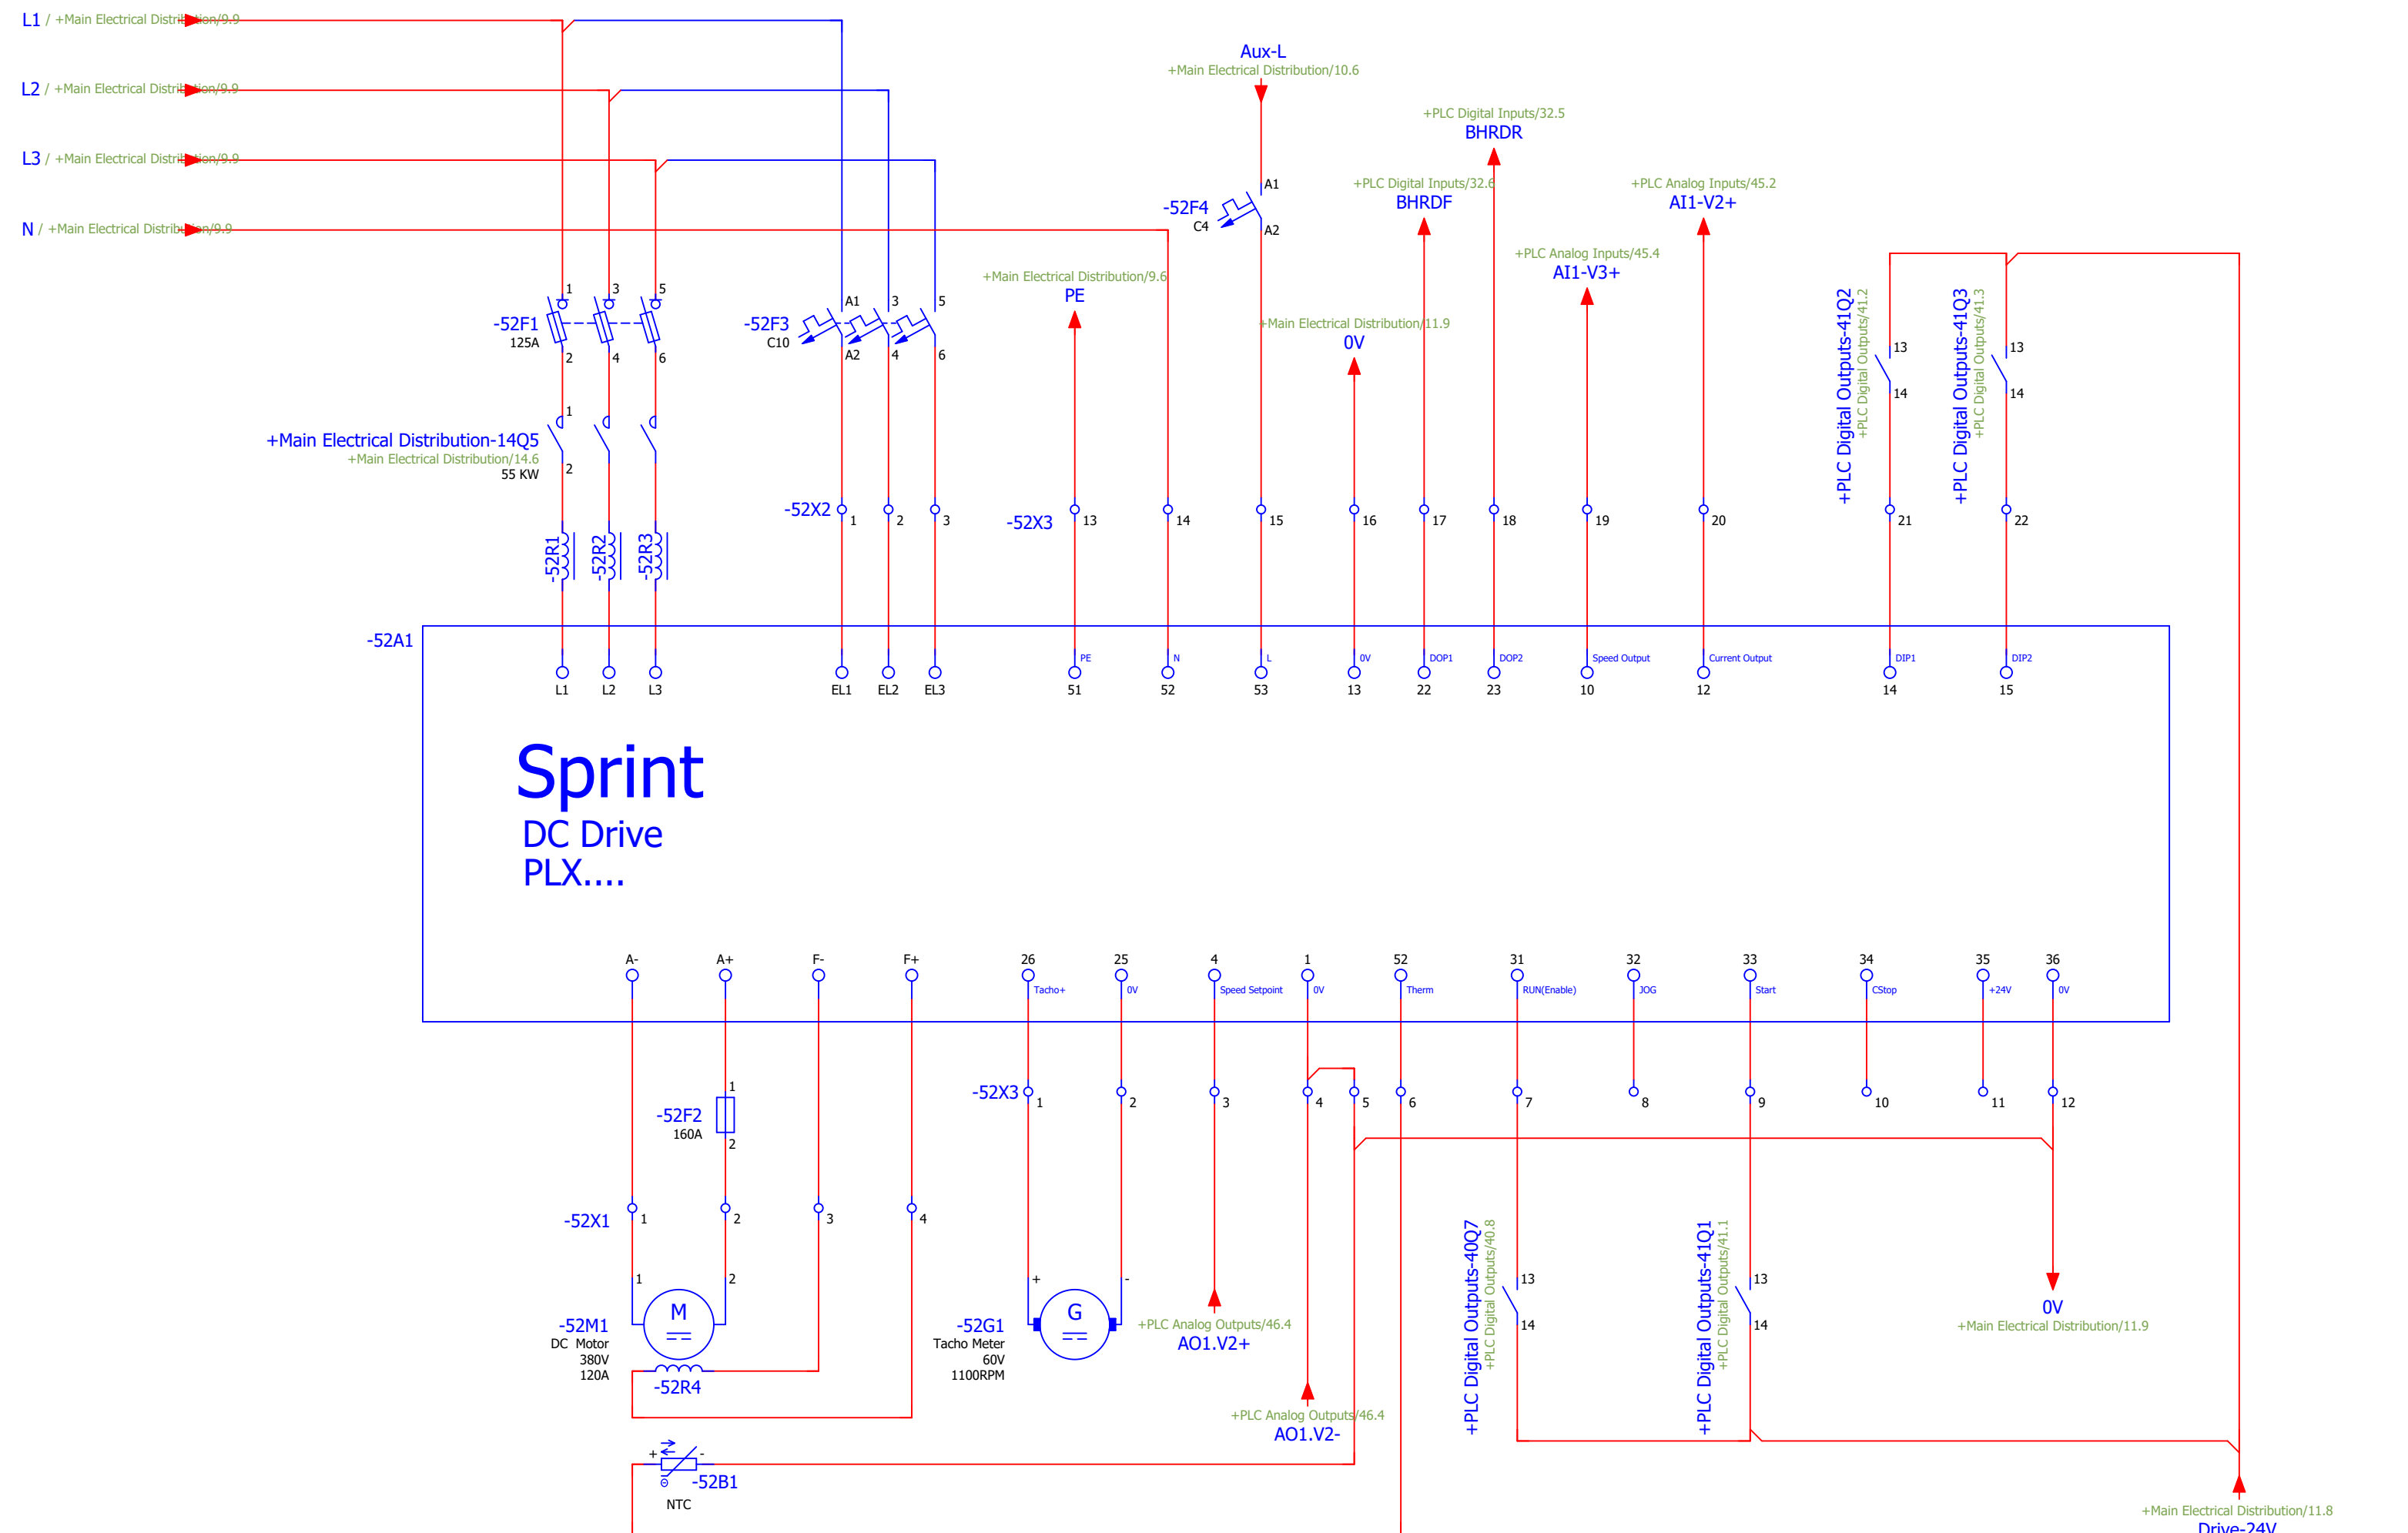

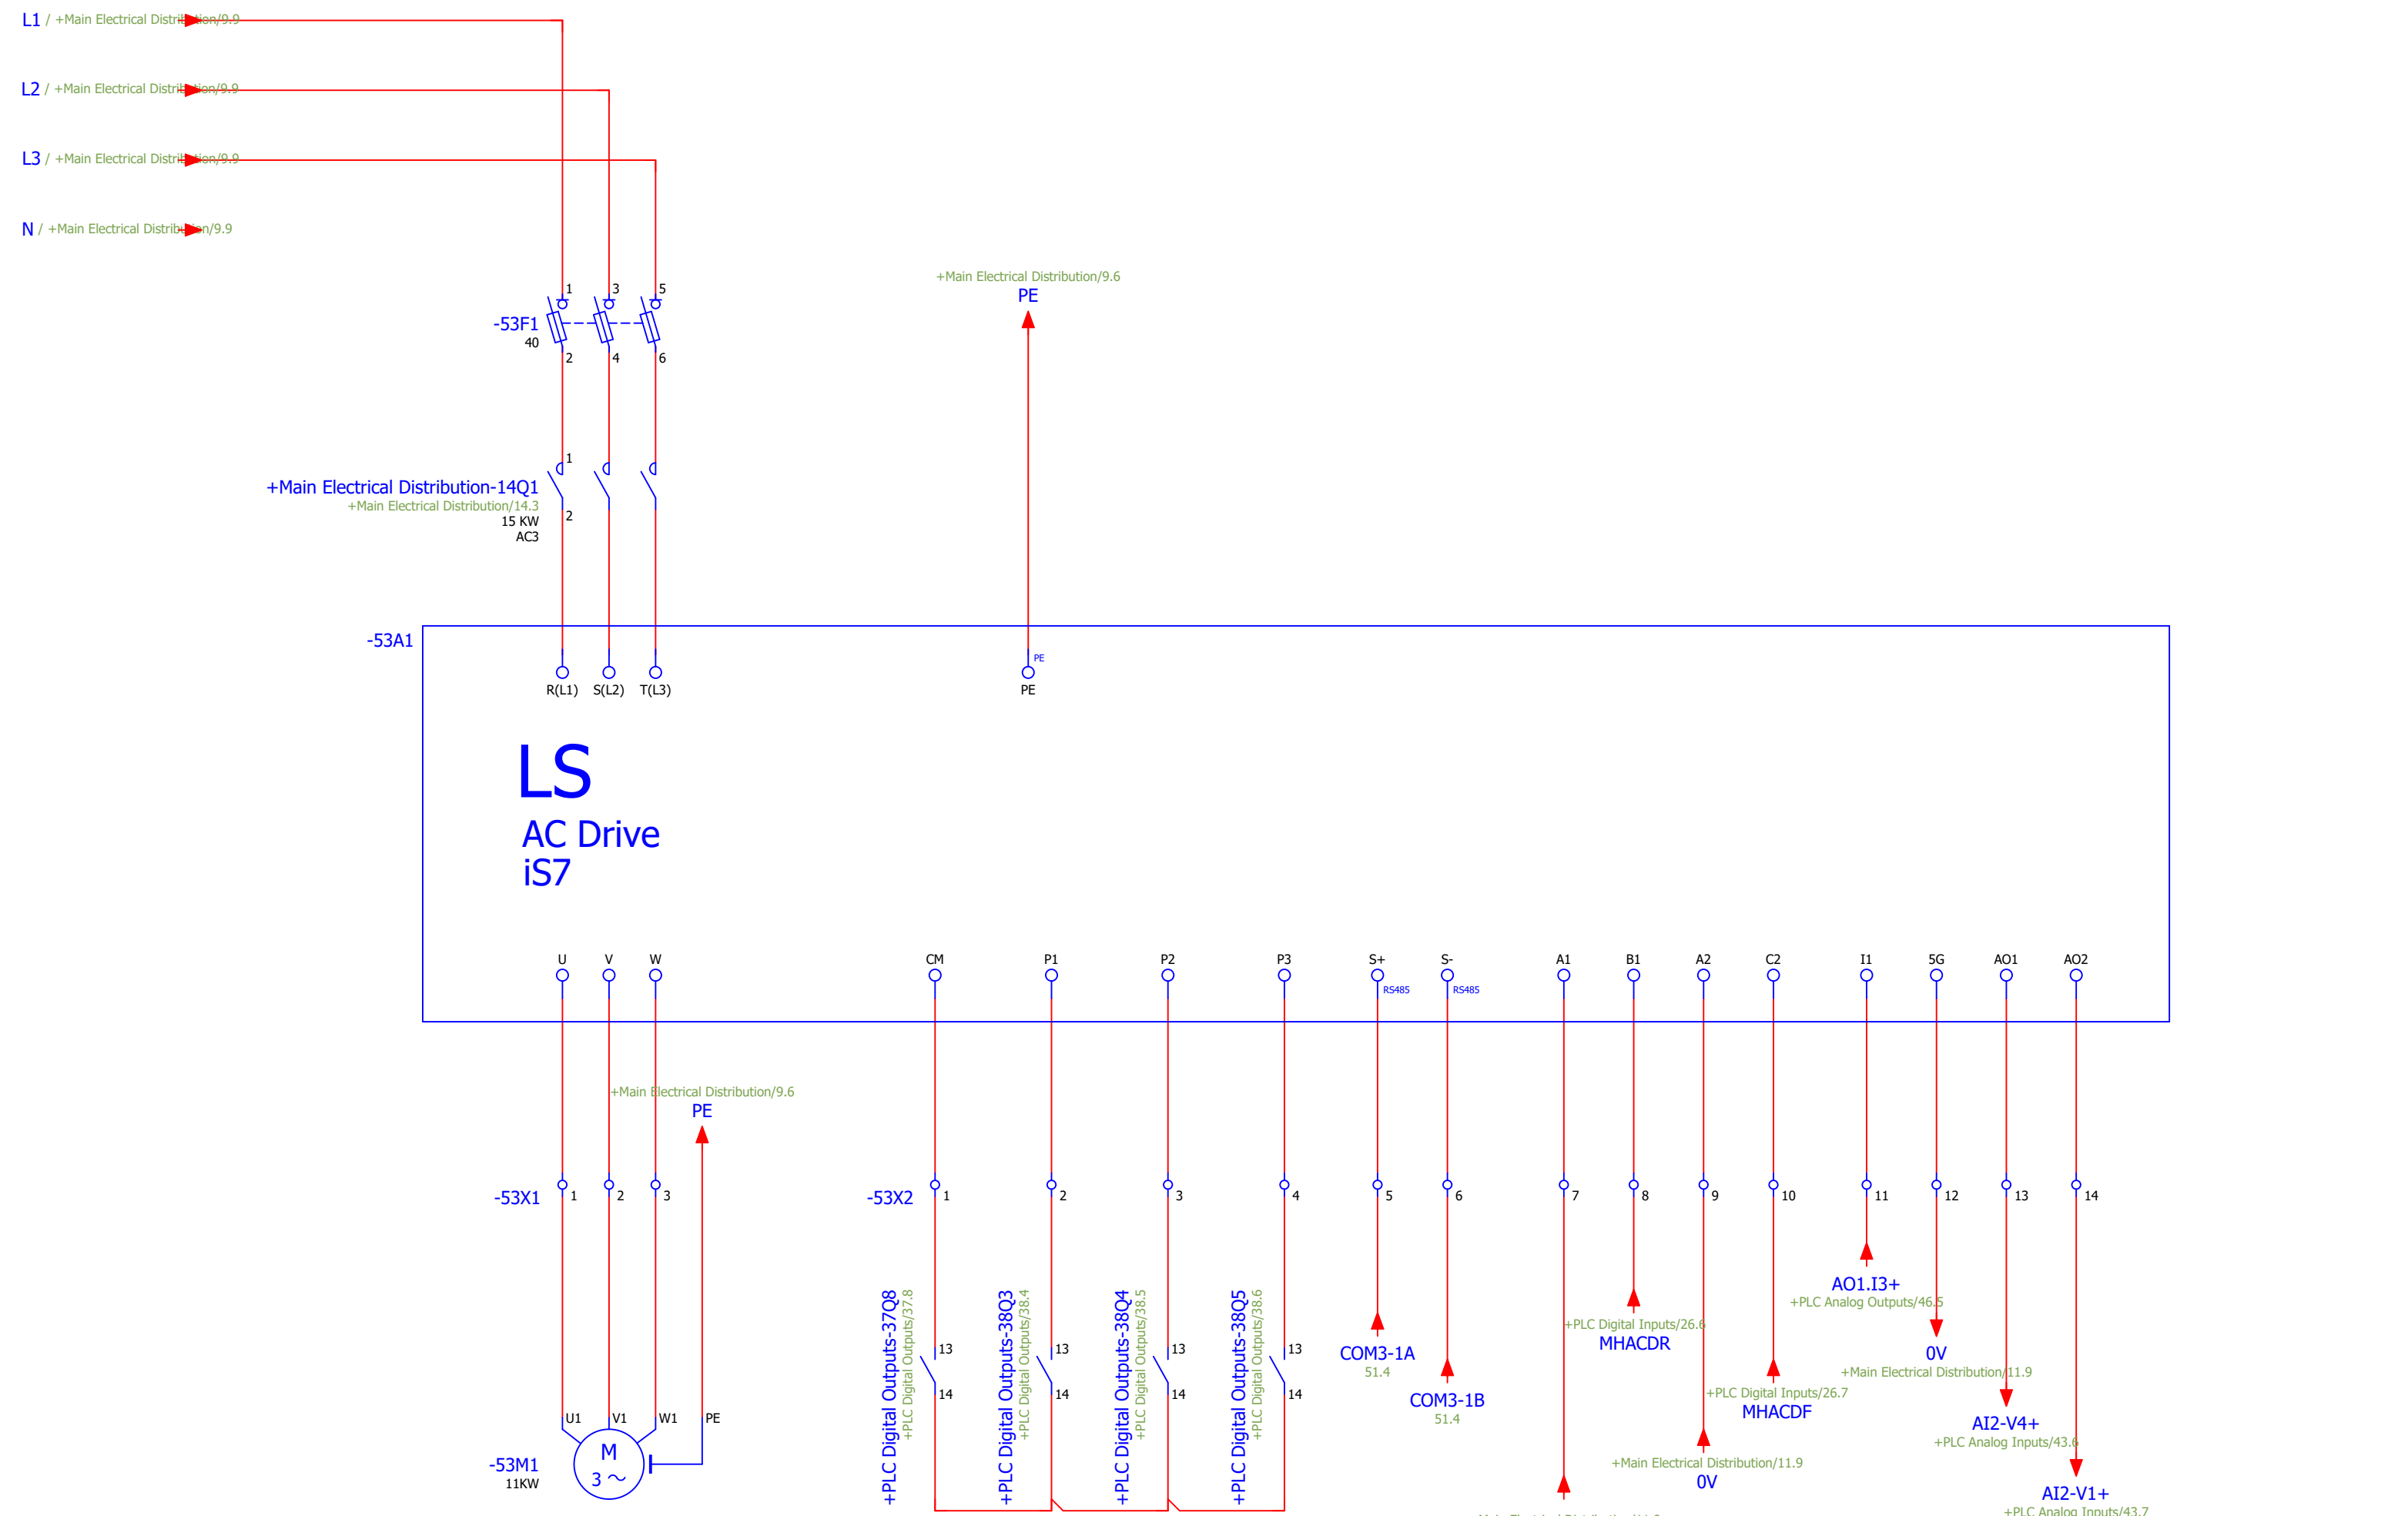


As Built				Project Description : Deep Hole Machin (DHD)	Page Description : Main HeadStock Spindle AC Drive	الکترون ELECTRONSHOP.IR	Job Number : ELEC-007		= DHD	
For Manufacturing	1404.10.14	Morteza Pourhasan							+ Motor Drives	
For Check	1404.9.15	Morteza Pourhasan	+989158875113				Software Version : EPLAN P8 2.9 SP1		Project Start : 8/30/2025	Last Edition : 10/13/2026
Modification	Date	Design & Confirm	Contact US						Page 53 / 77	Page 53 / 77

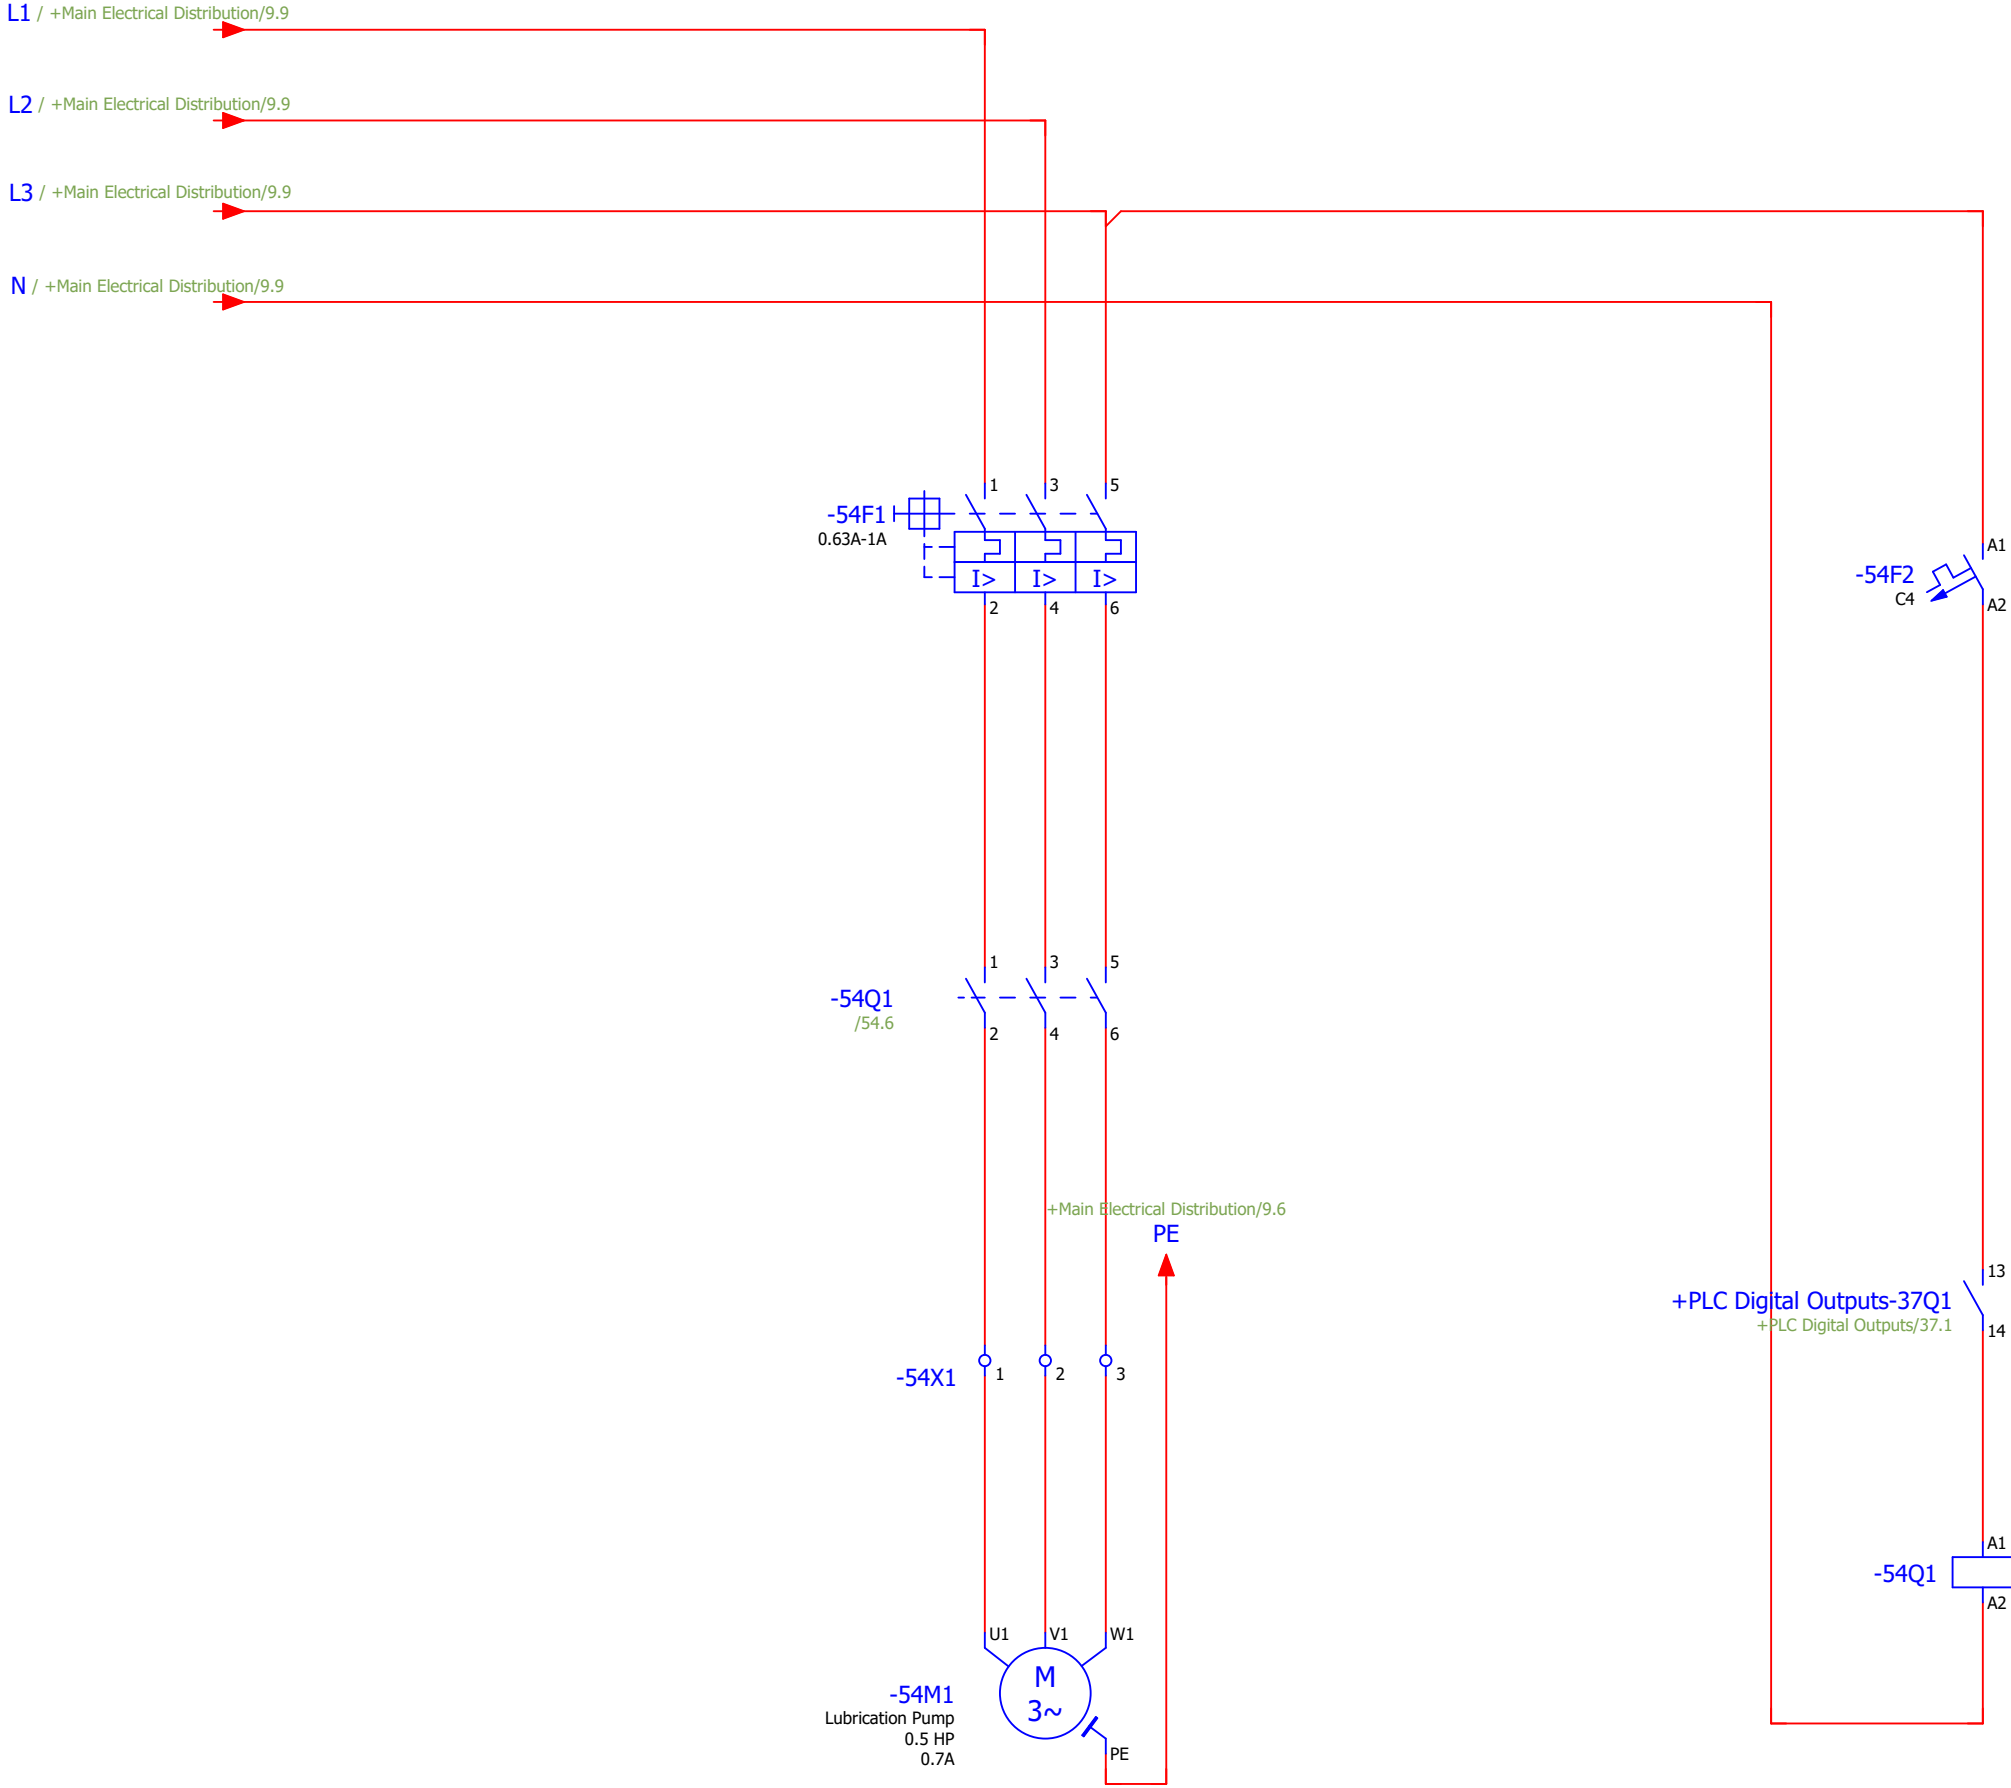

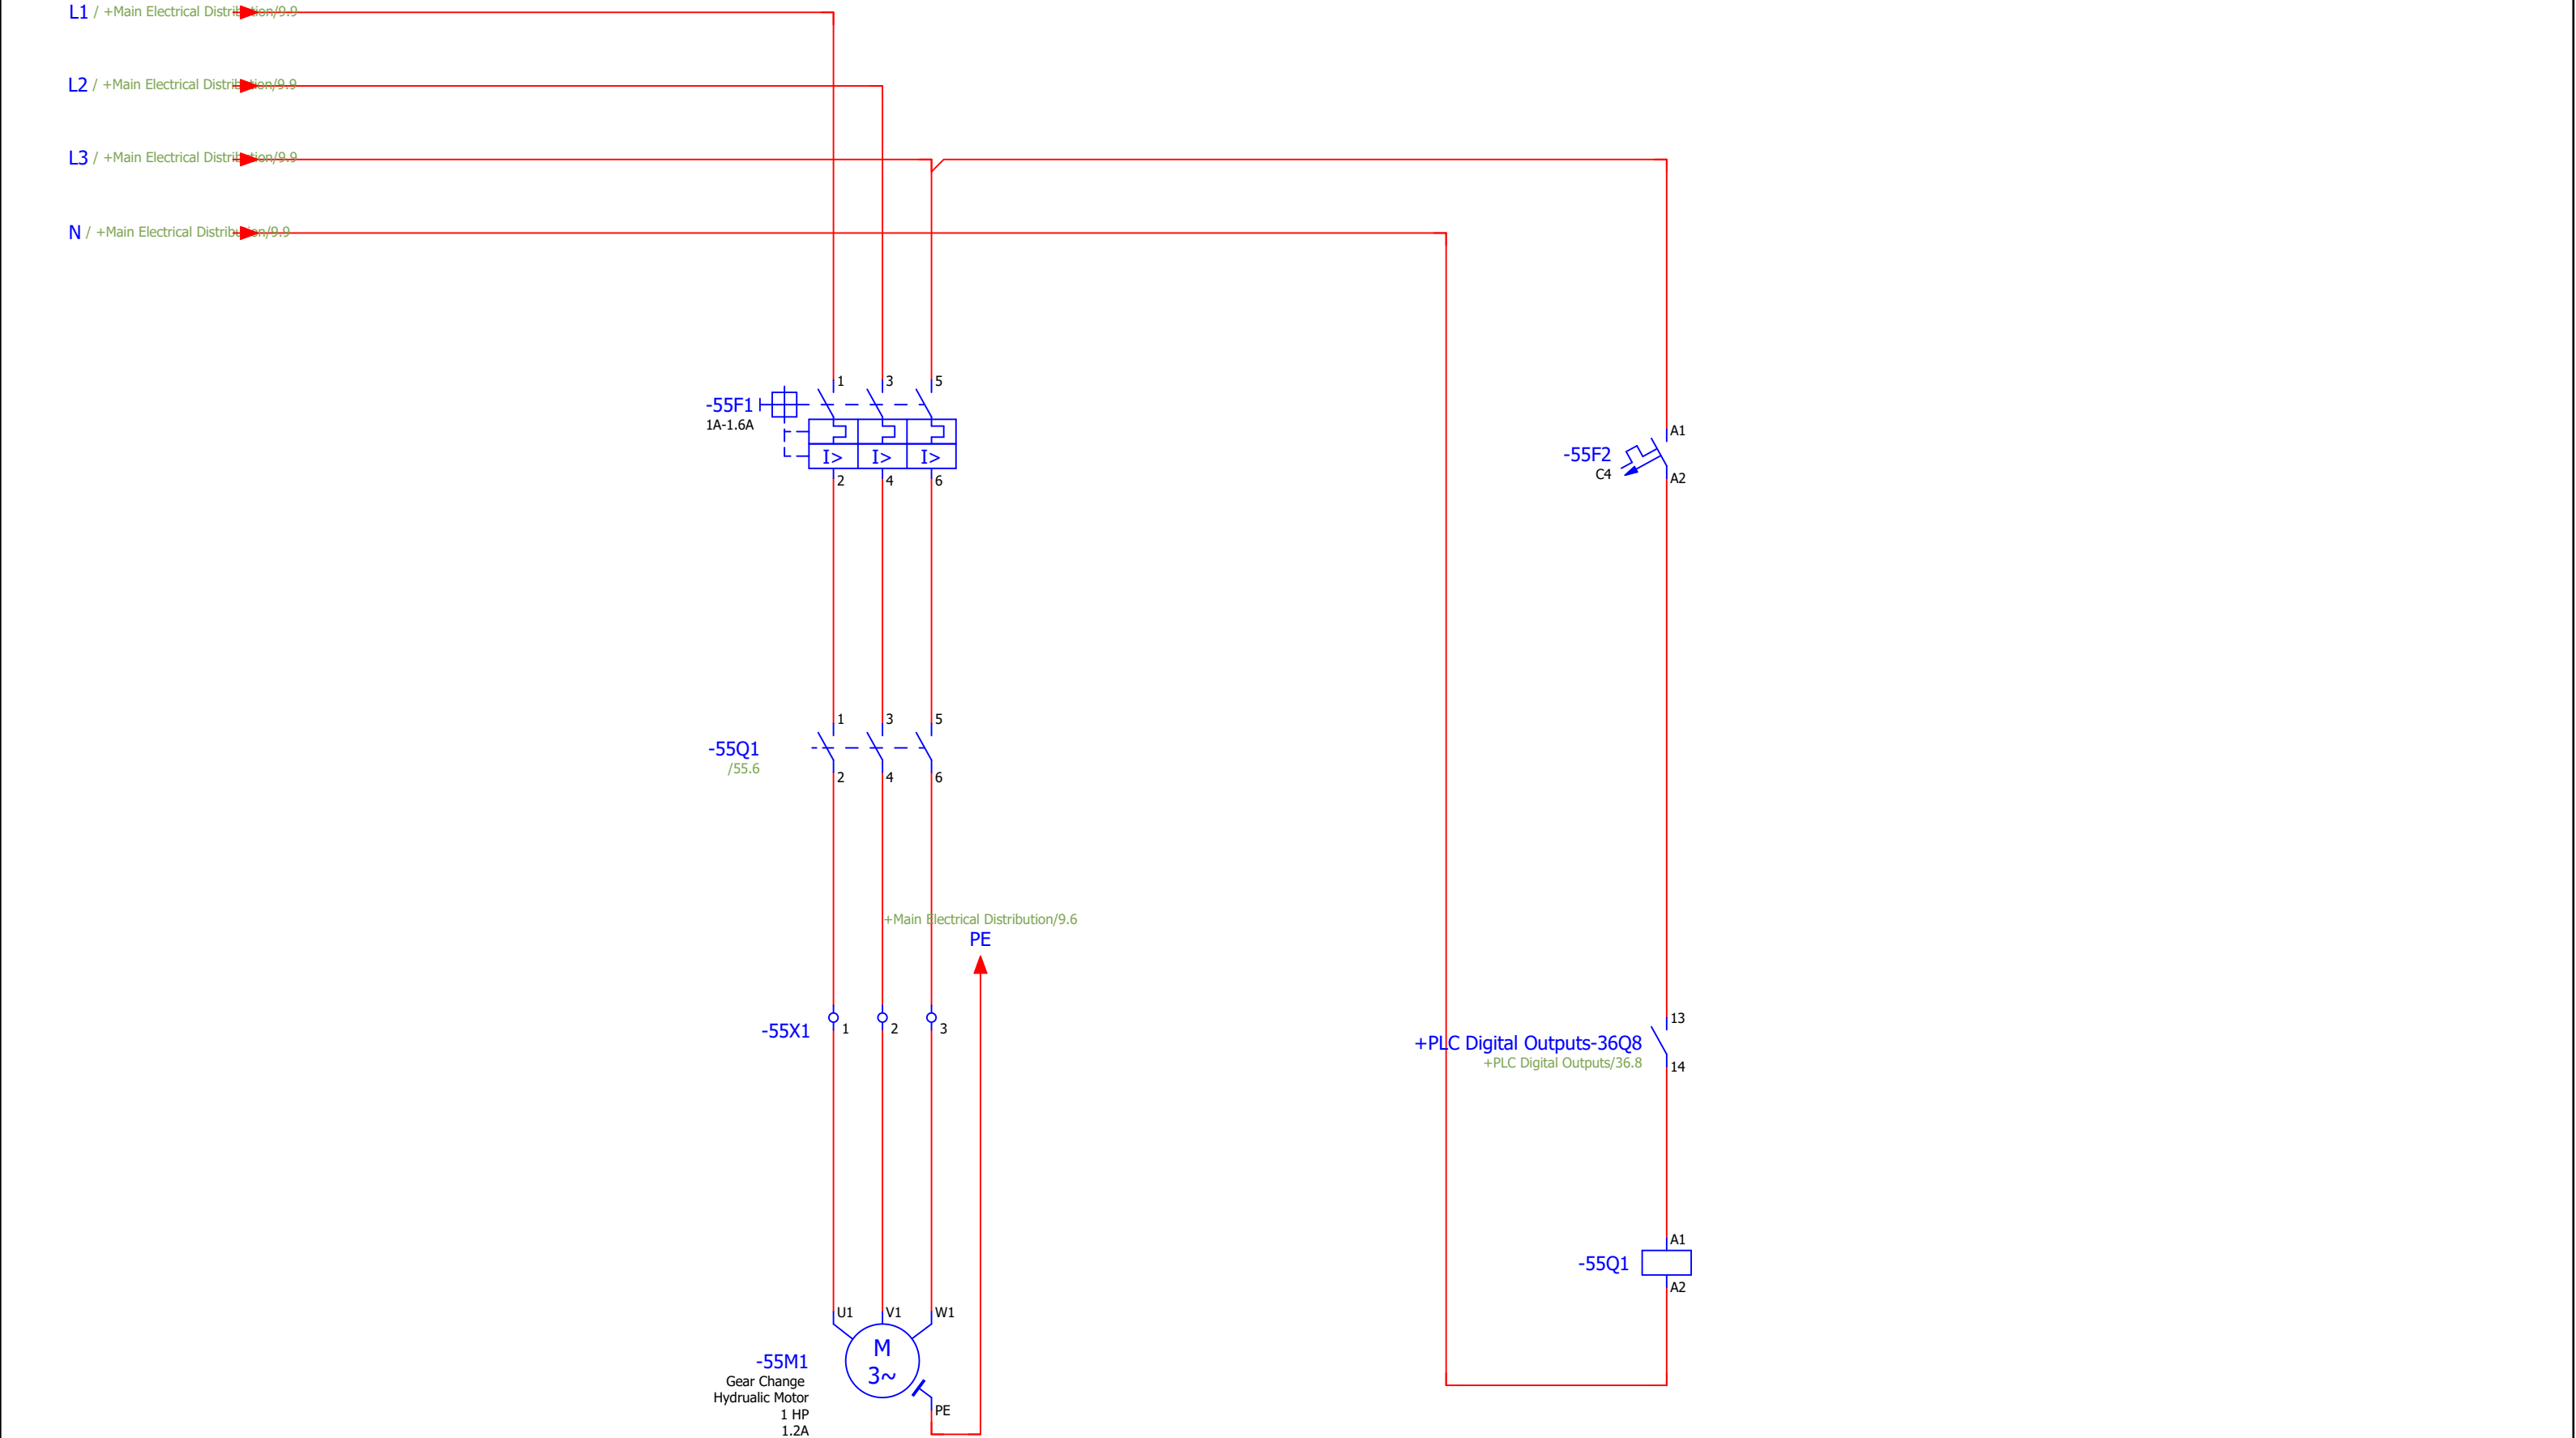

L1 / +Main Electrical Distribution/9.9


N / +Main Electrical Distribution/9.9


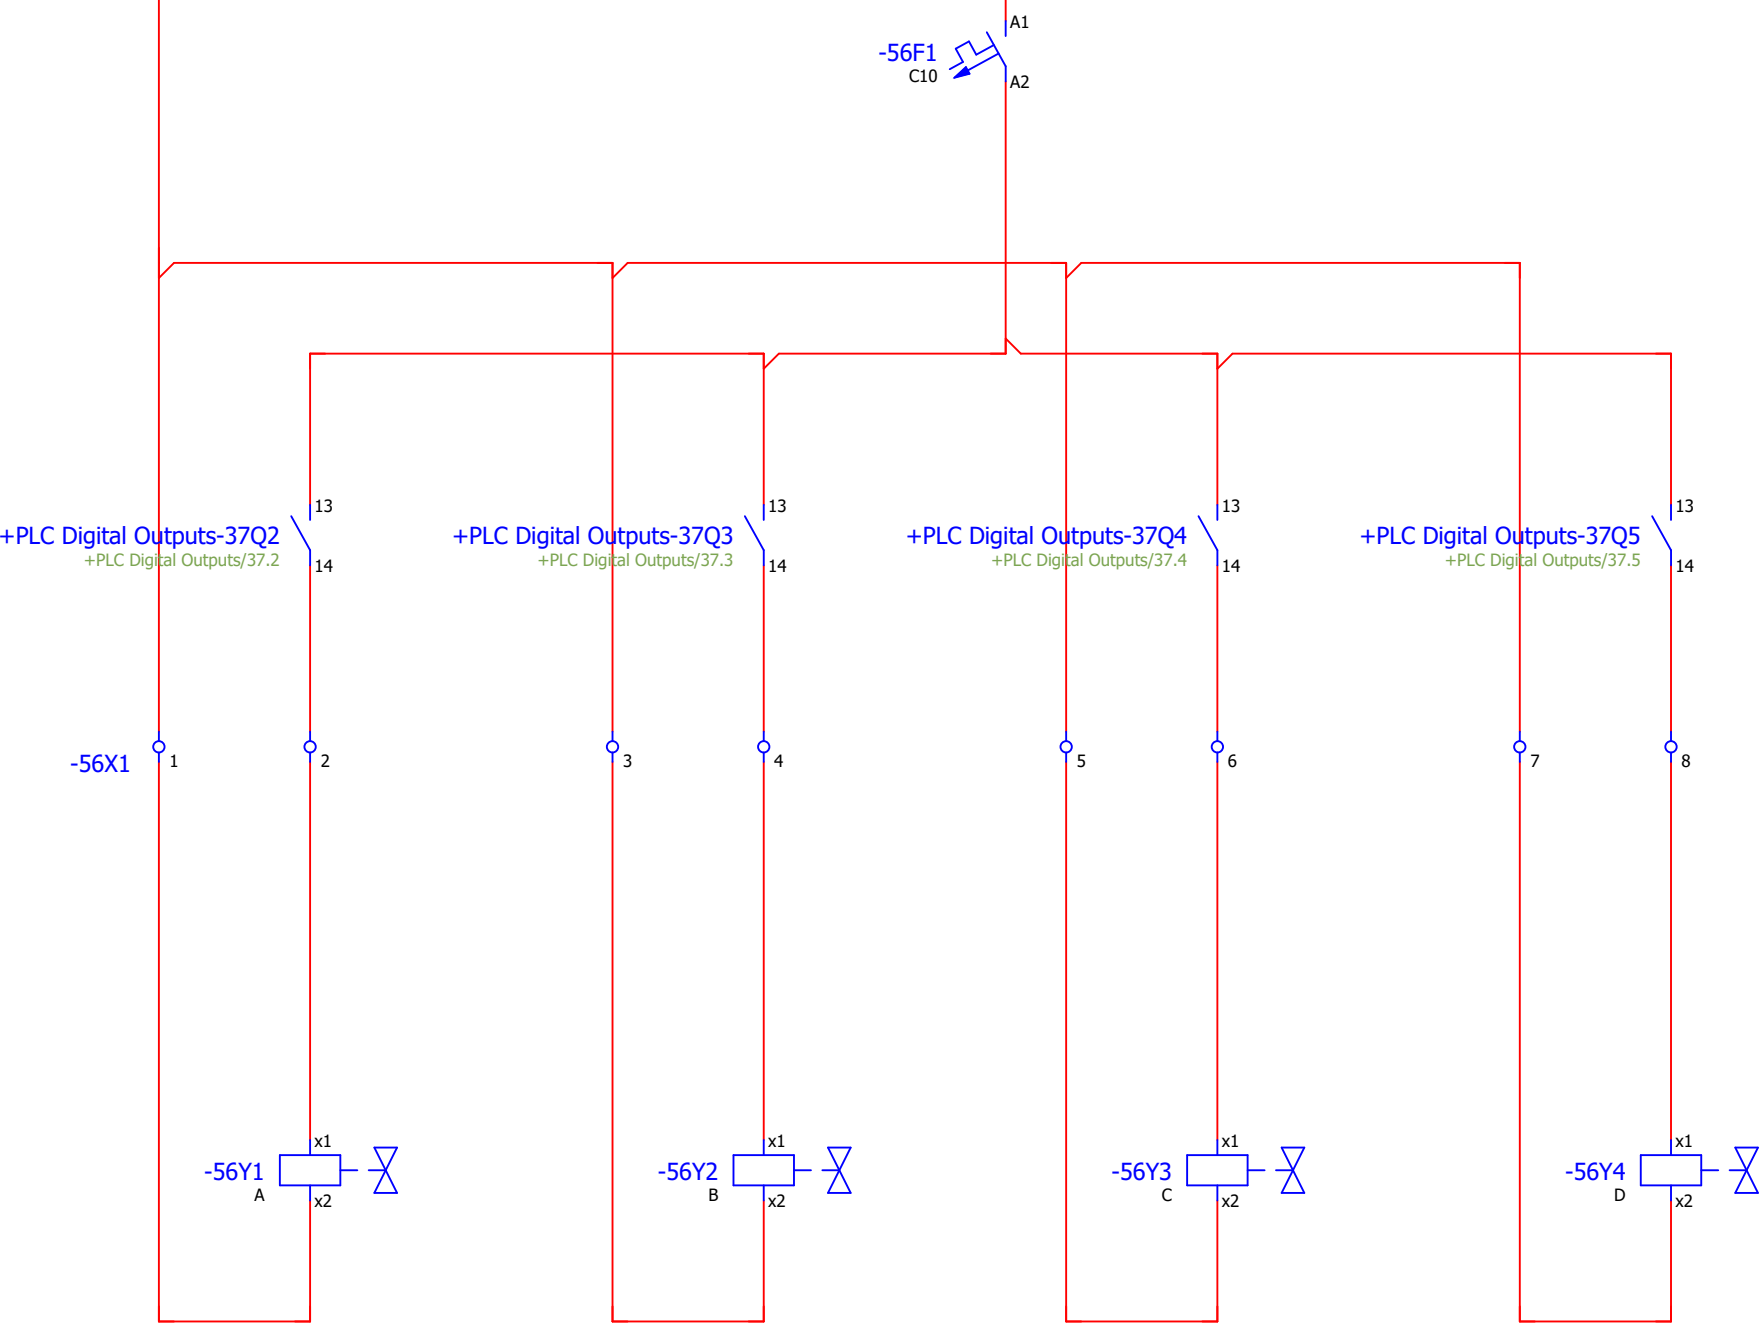



Main HeadStock


Gear NR 1 : AD Energize
Gear NR 2 : BD Energize
Gear NR 3 : AC Energize
Gear NR 4 : BC Energize

A	Hydraulic Cylinder	B	
D	Hydraulic Cylinder	C	

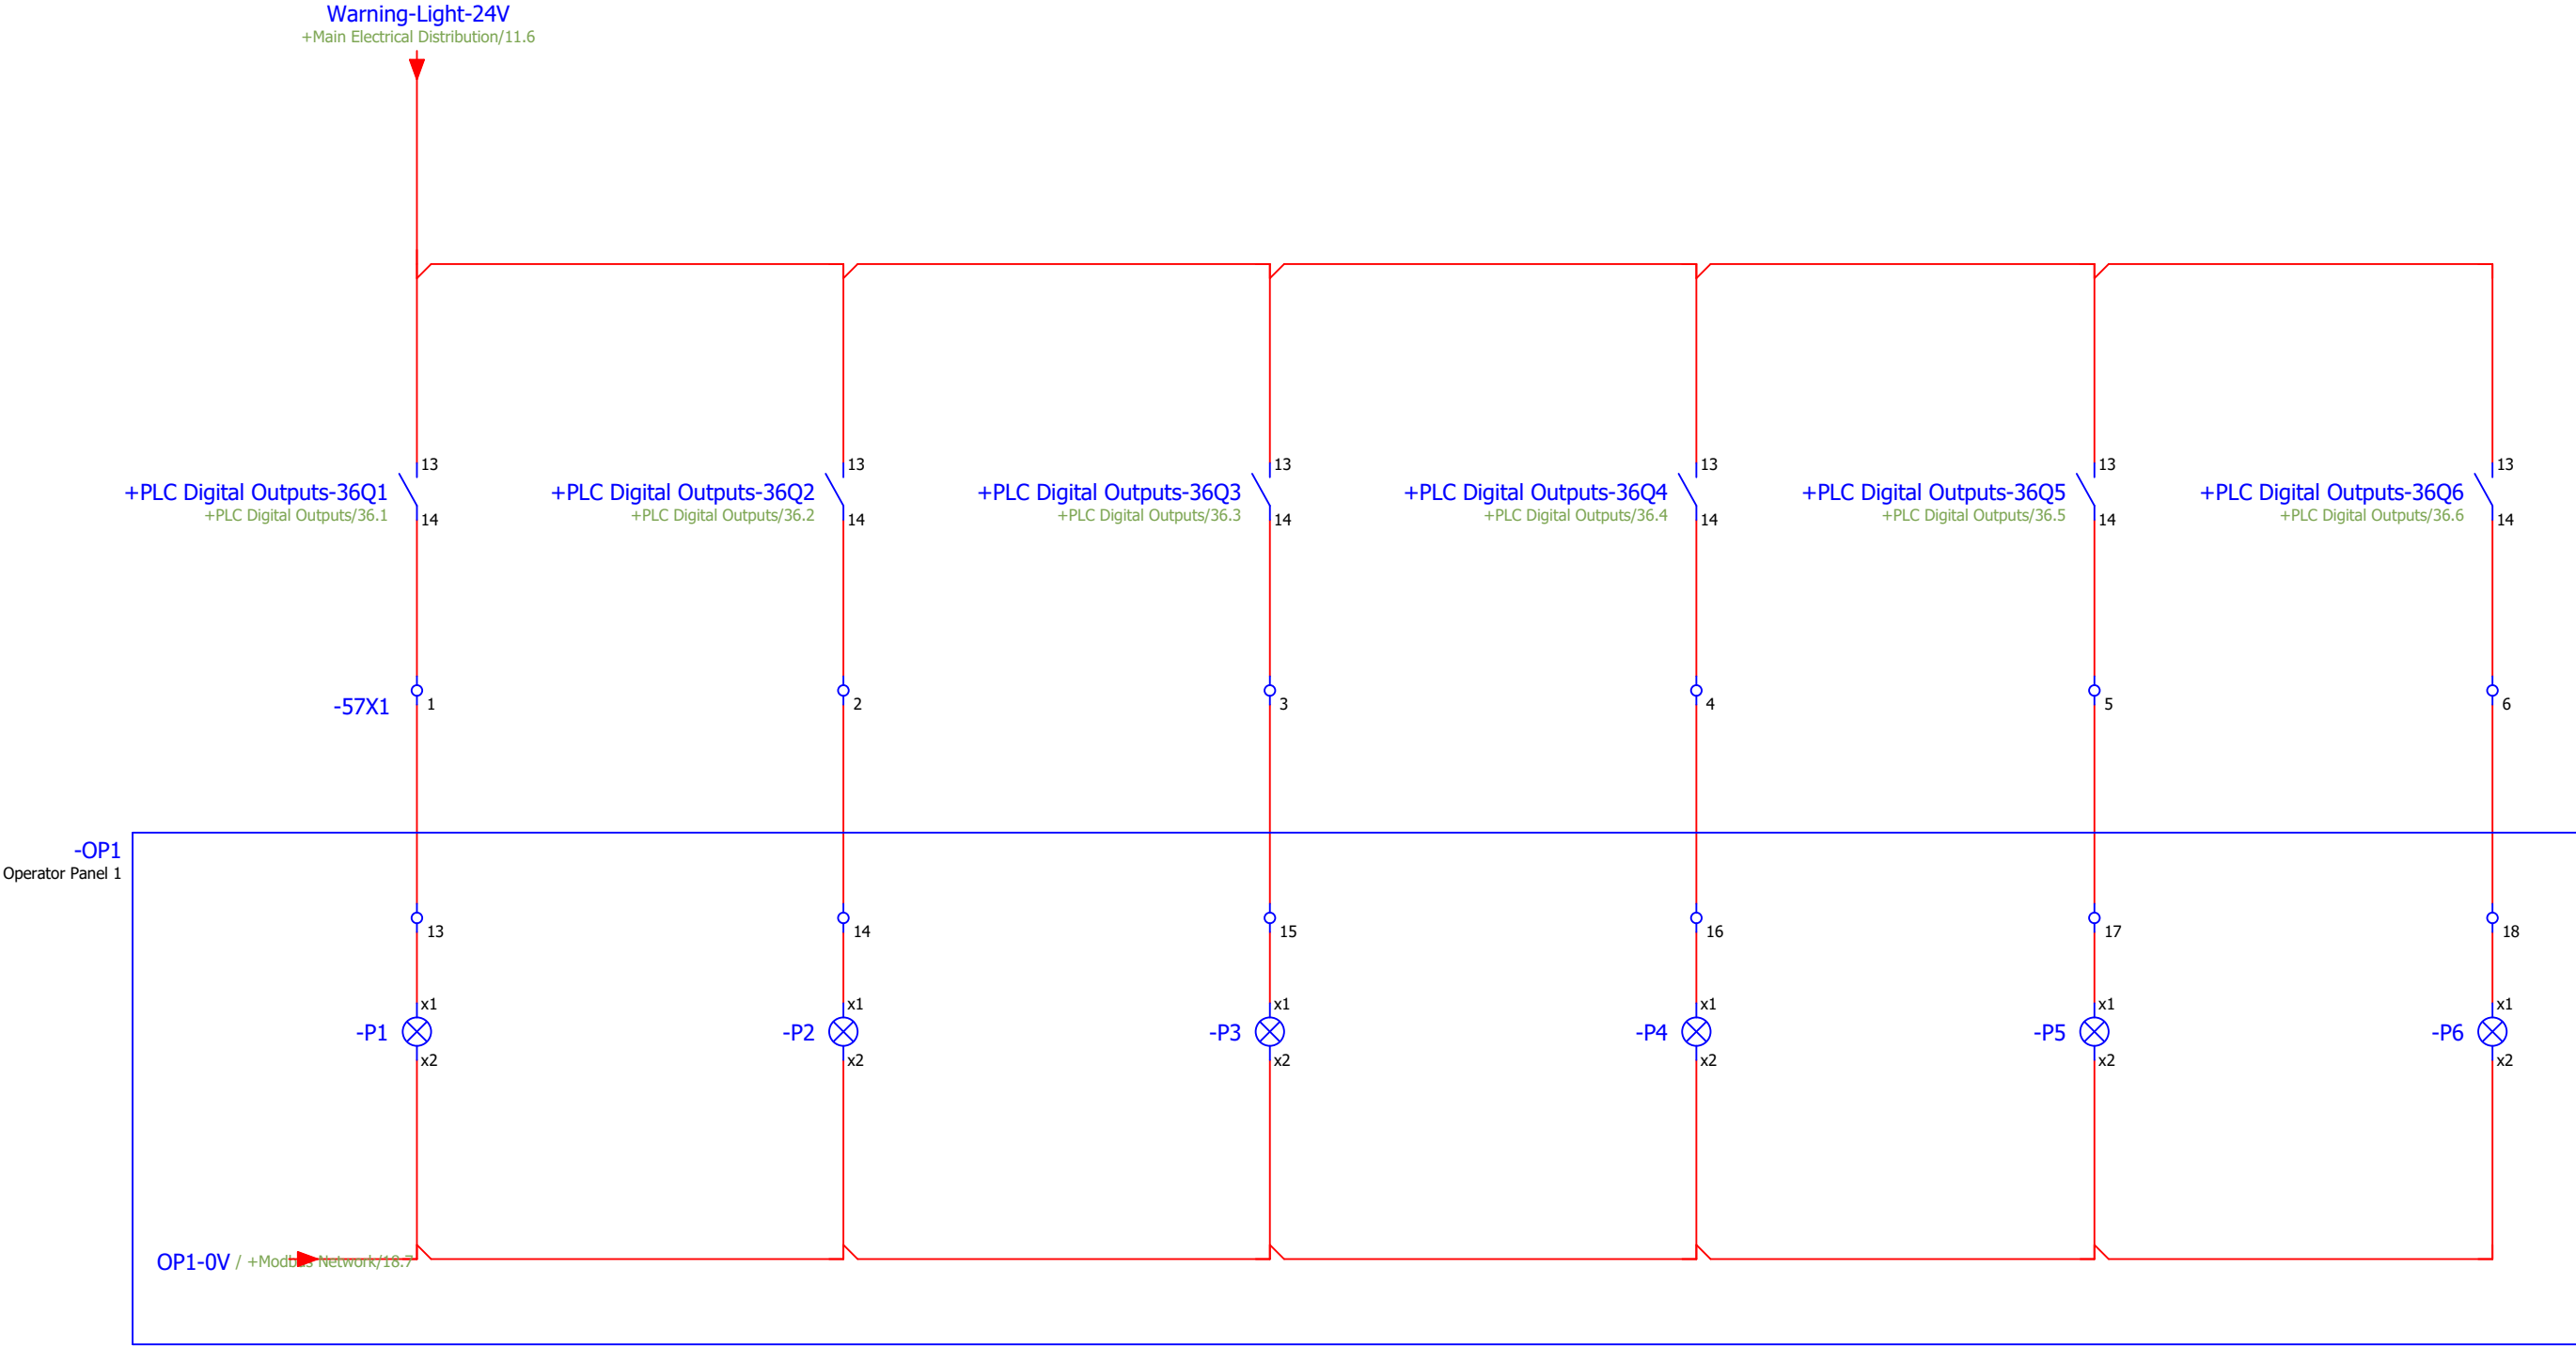

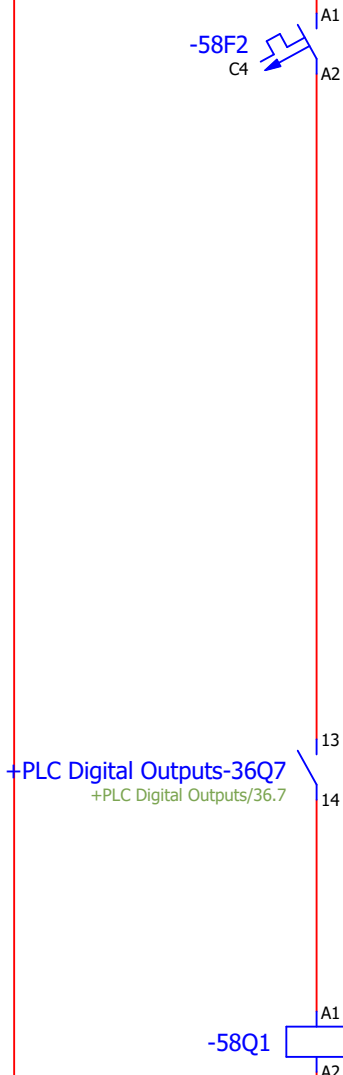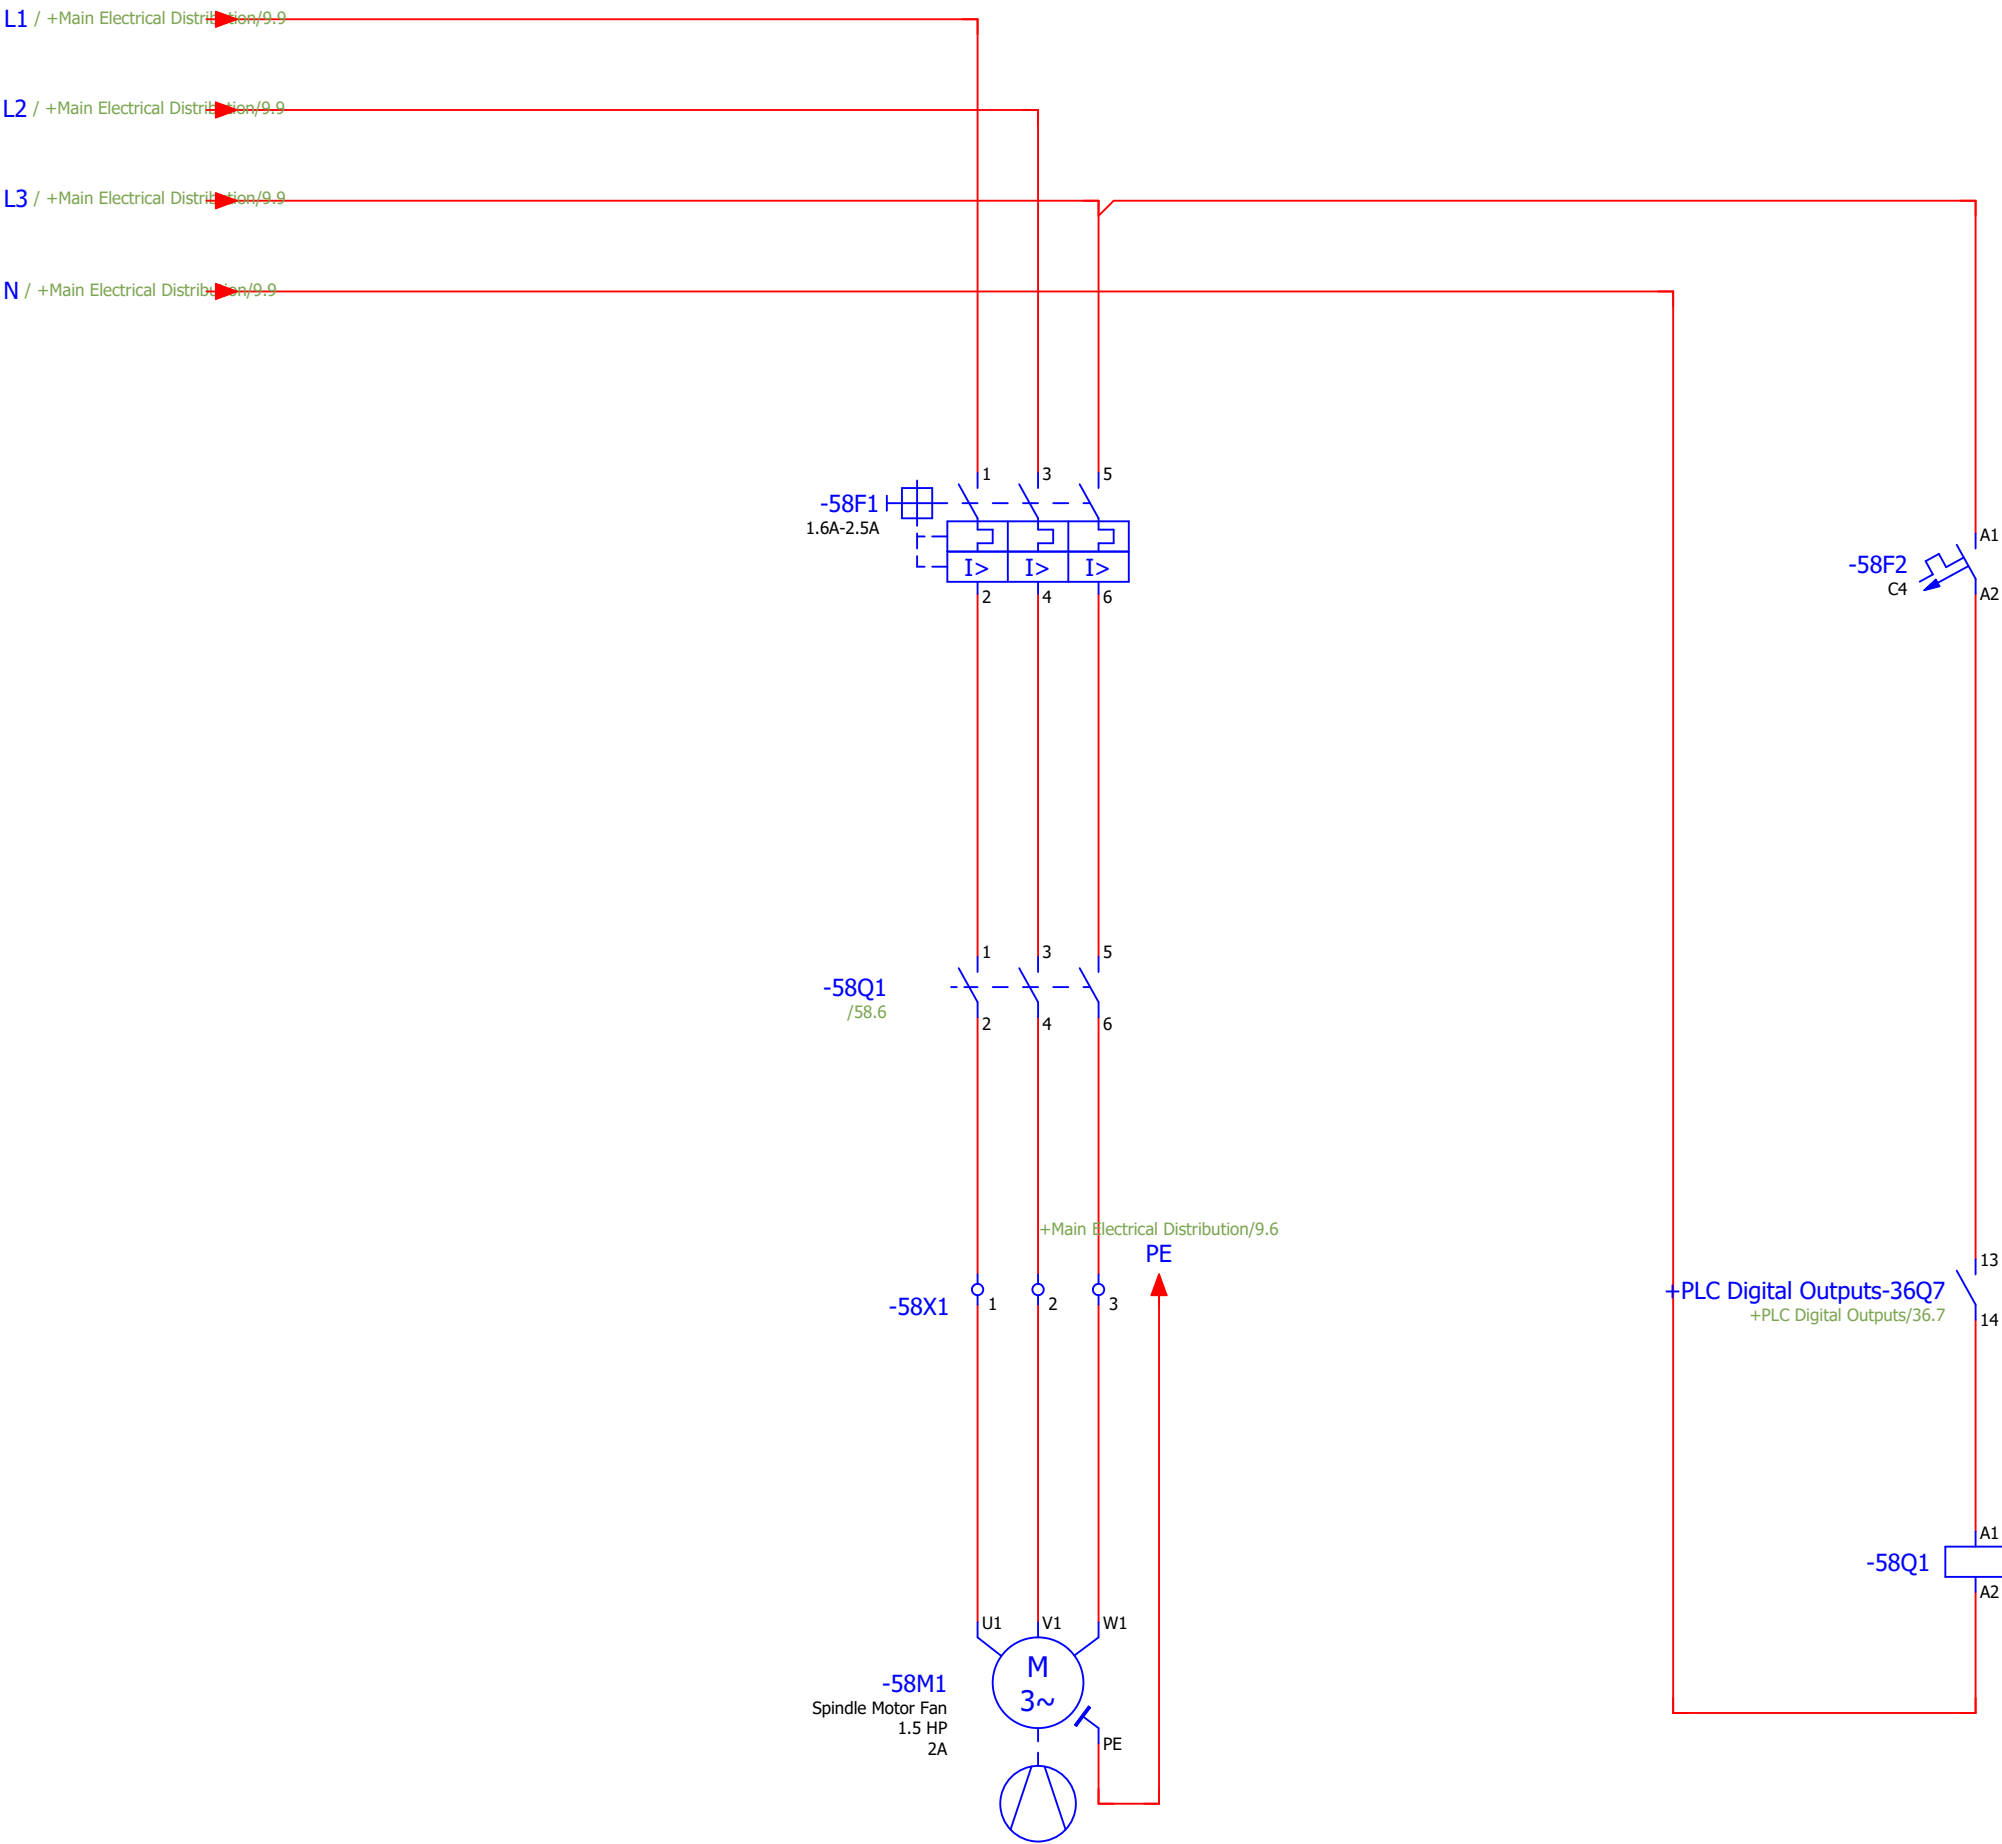

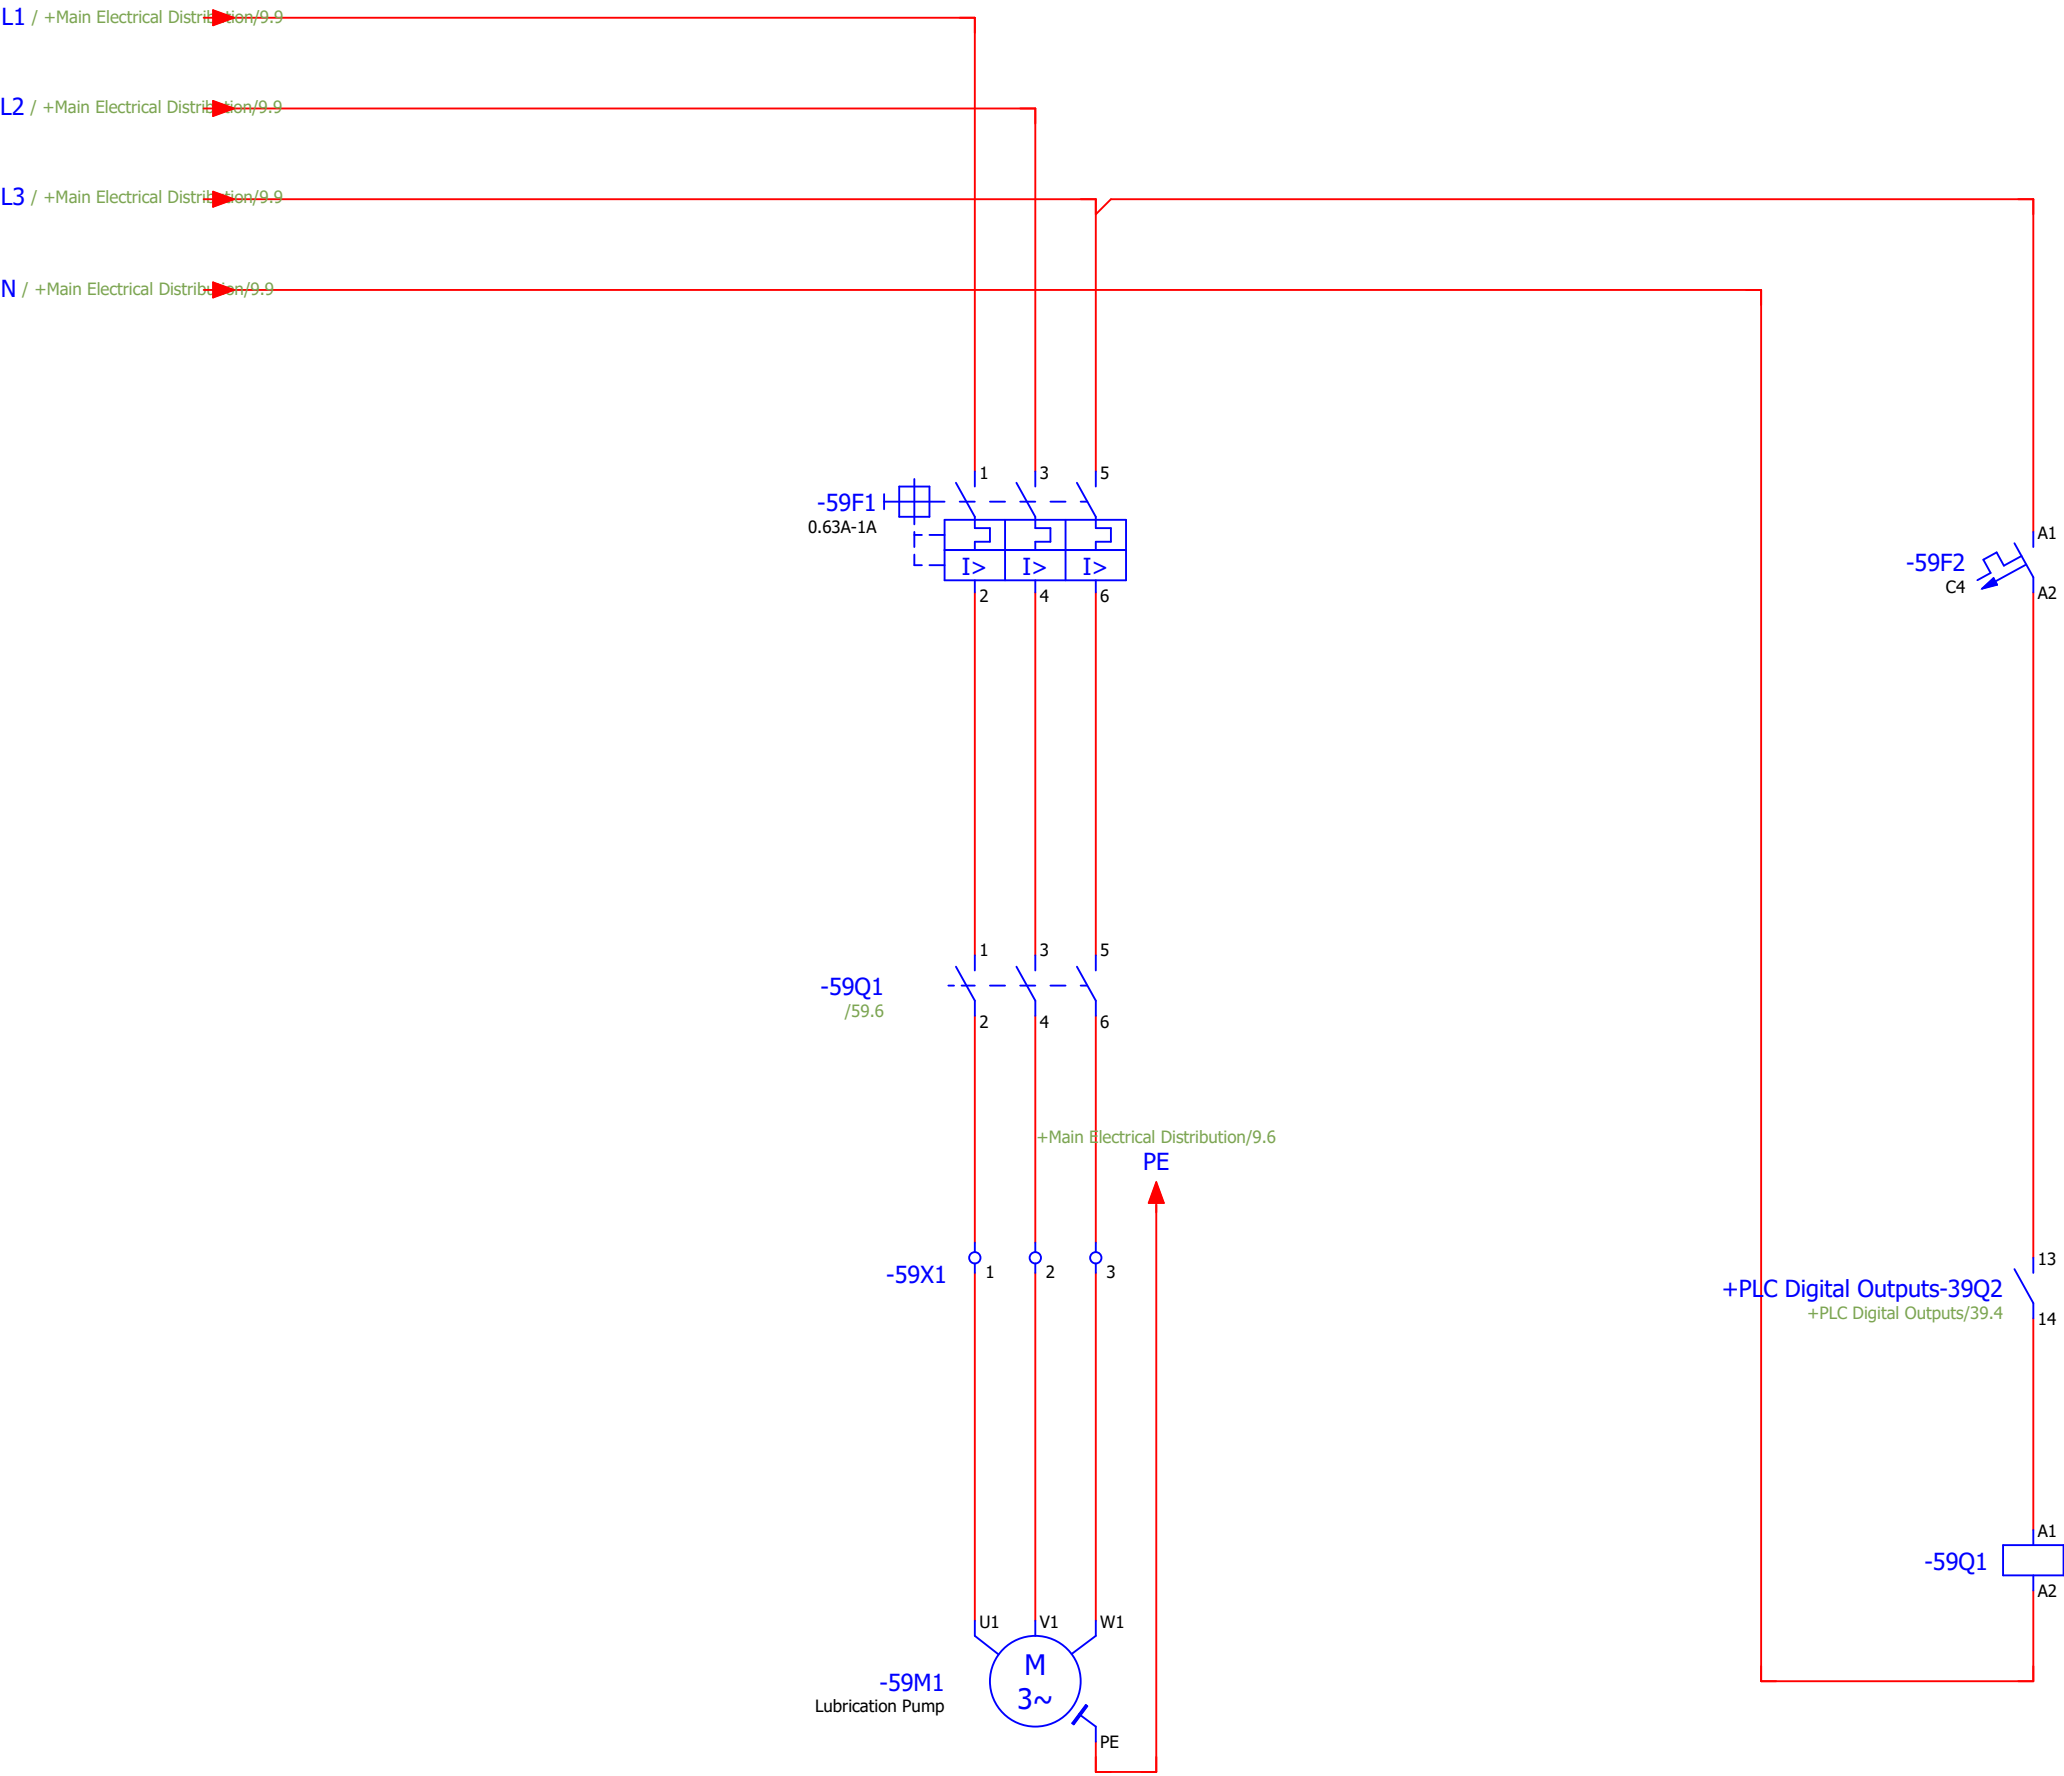

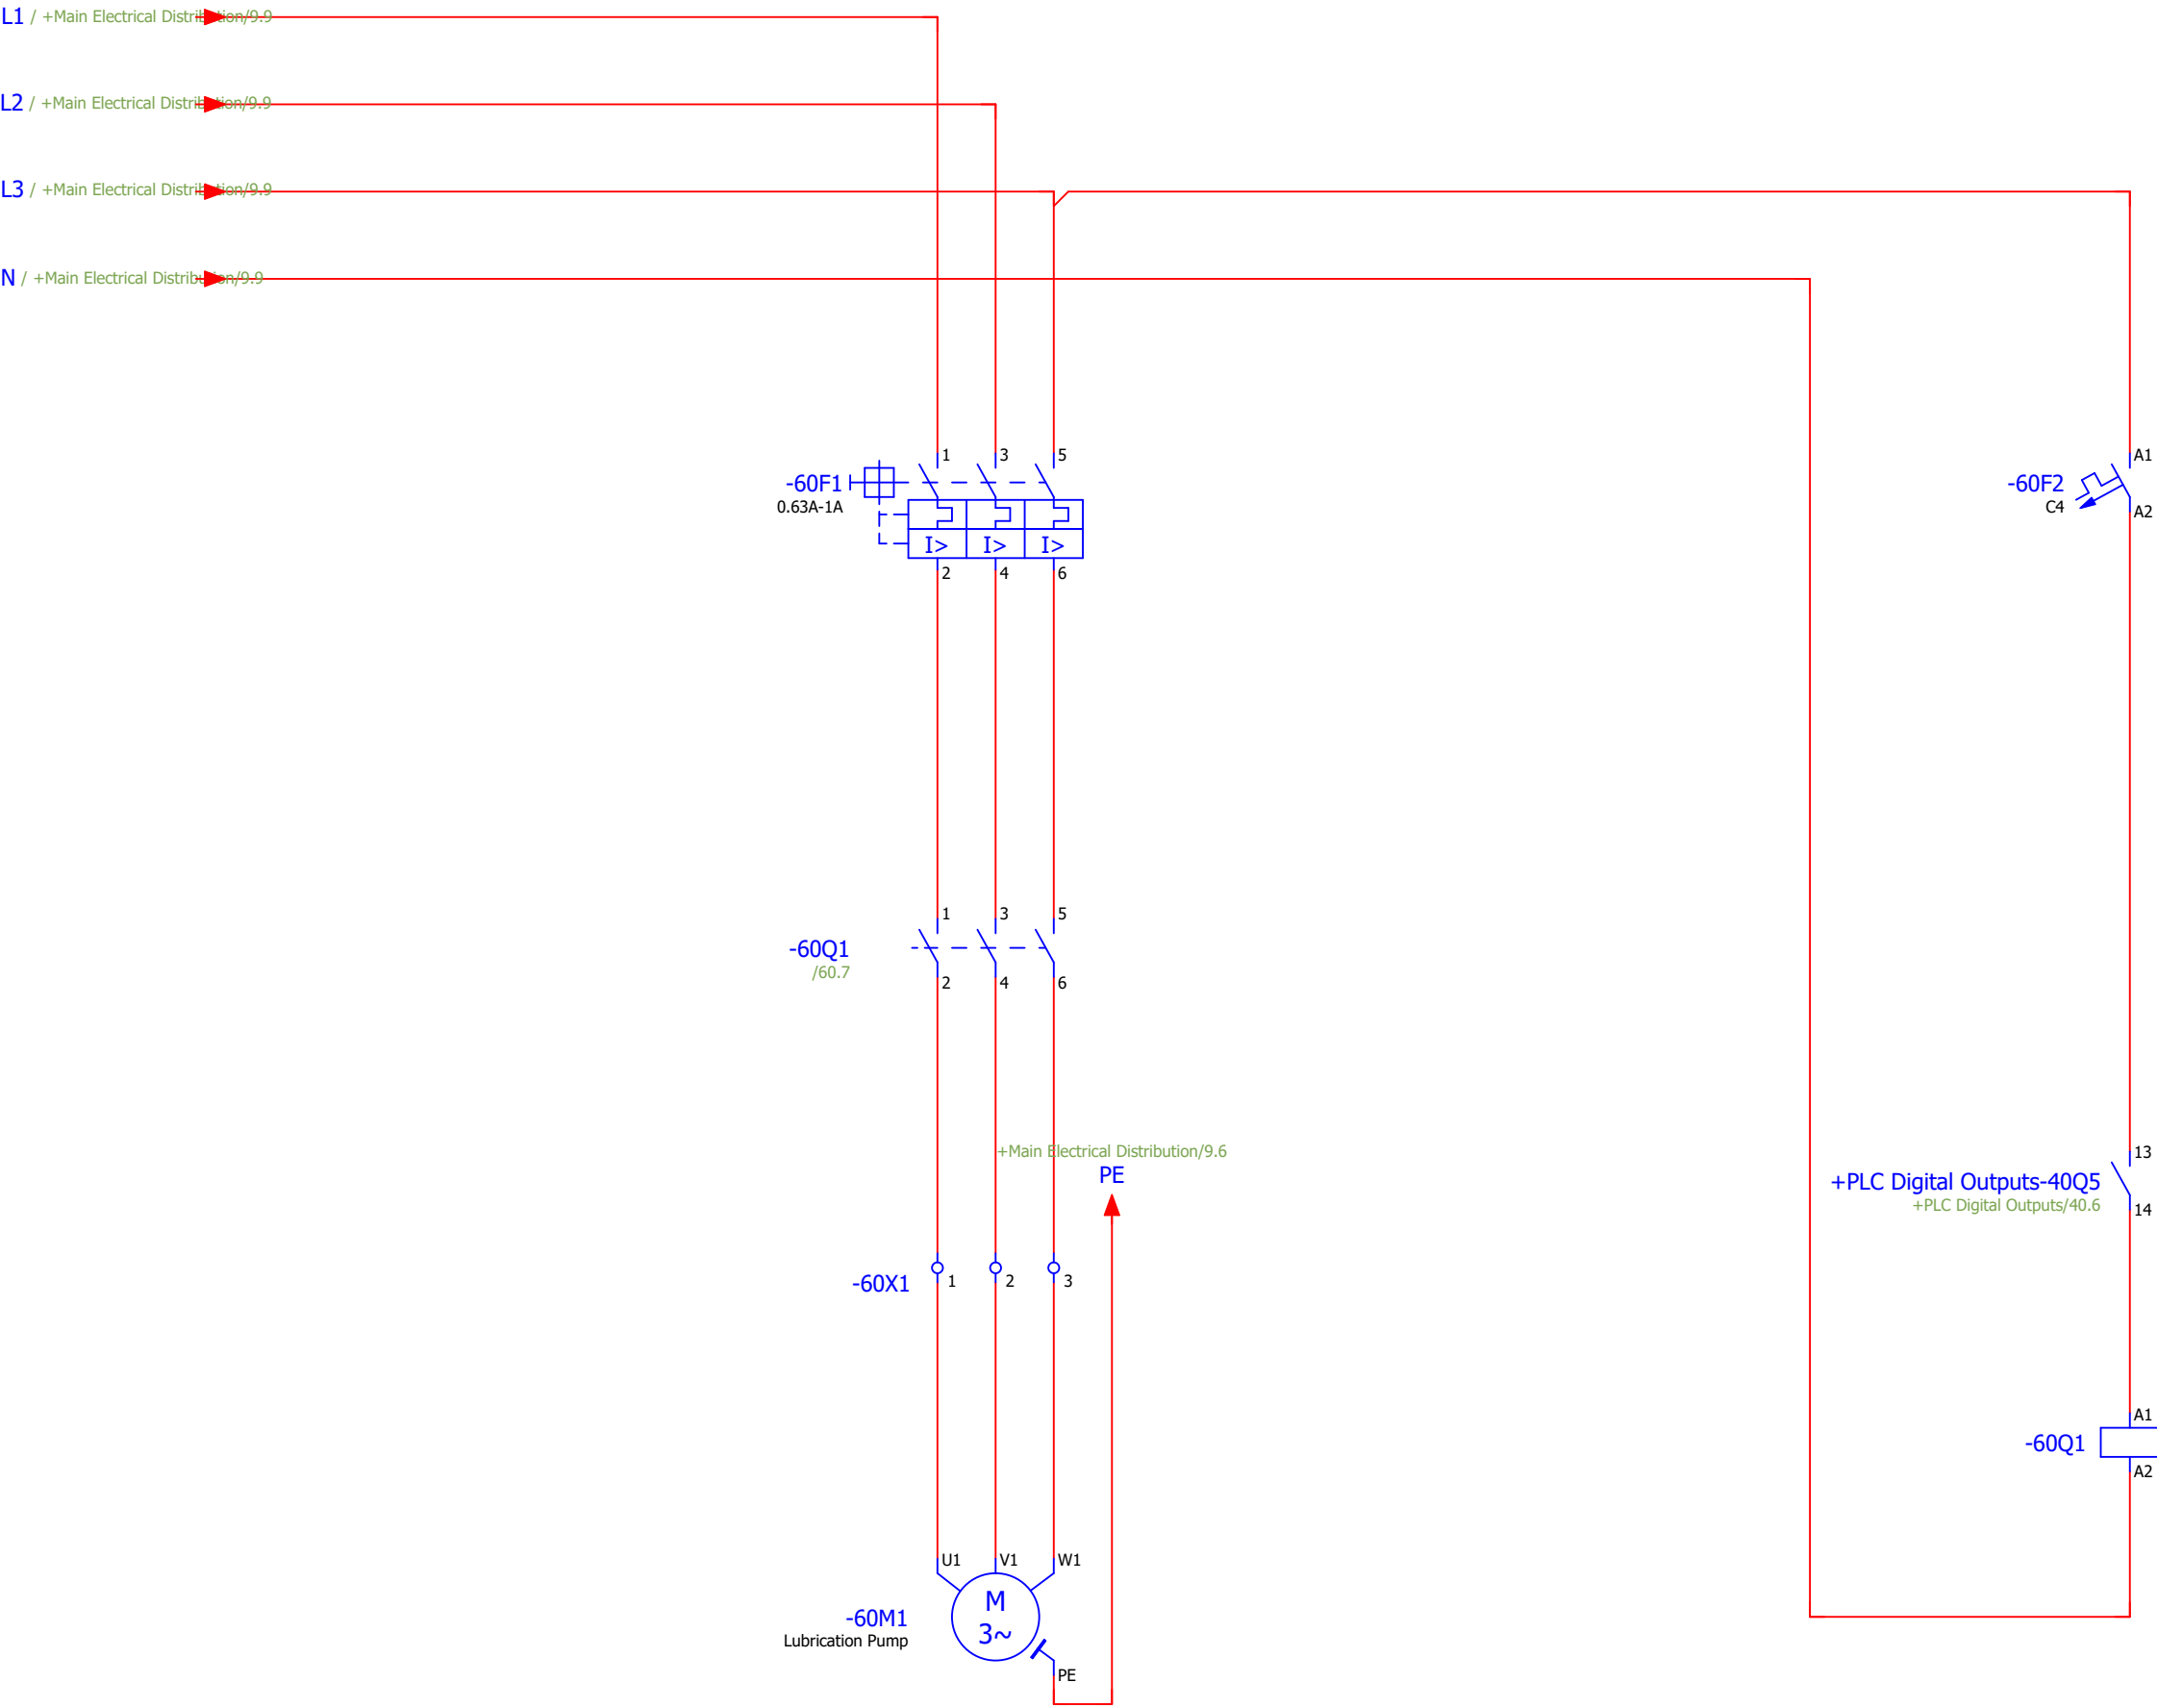


As Built			
For Manufacturing	1404.10.14	Morteza Pourhasan	
For Check	1404.9.15	Morteza Pourhasan	+989158875113
Modification	Date	Design & Confirm	Contact US


Project Description :
Deep Hole Machin (DHD)

Page Description :
Boring Head Carriage Lubrication Pump




Job Number : ELEC-007		= DHD	
		+ Feilds Wiring Diagram	
Software Version : EPLAN P8 2.9 SP1	Project Start : 8/30/2025	Last Edition : 10/13/2026	Page 60
		Page 60 / 77	

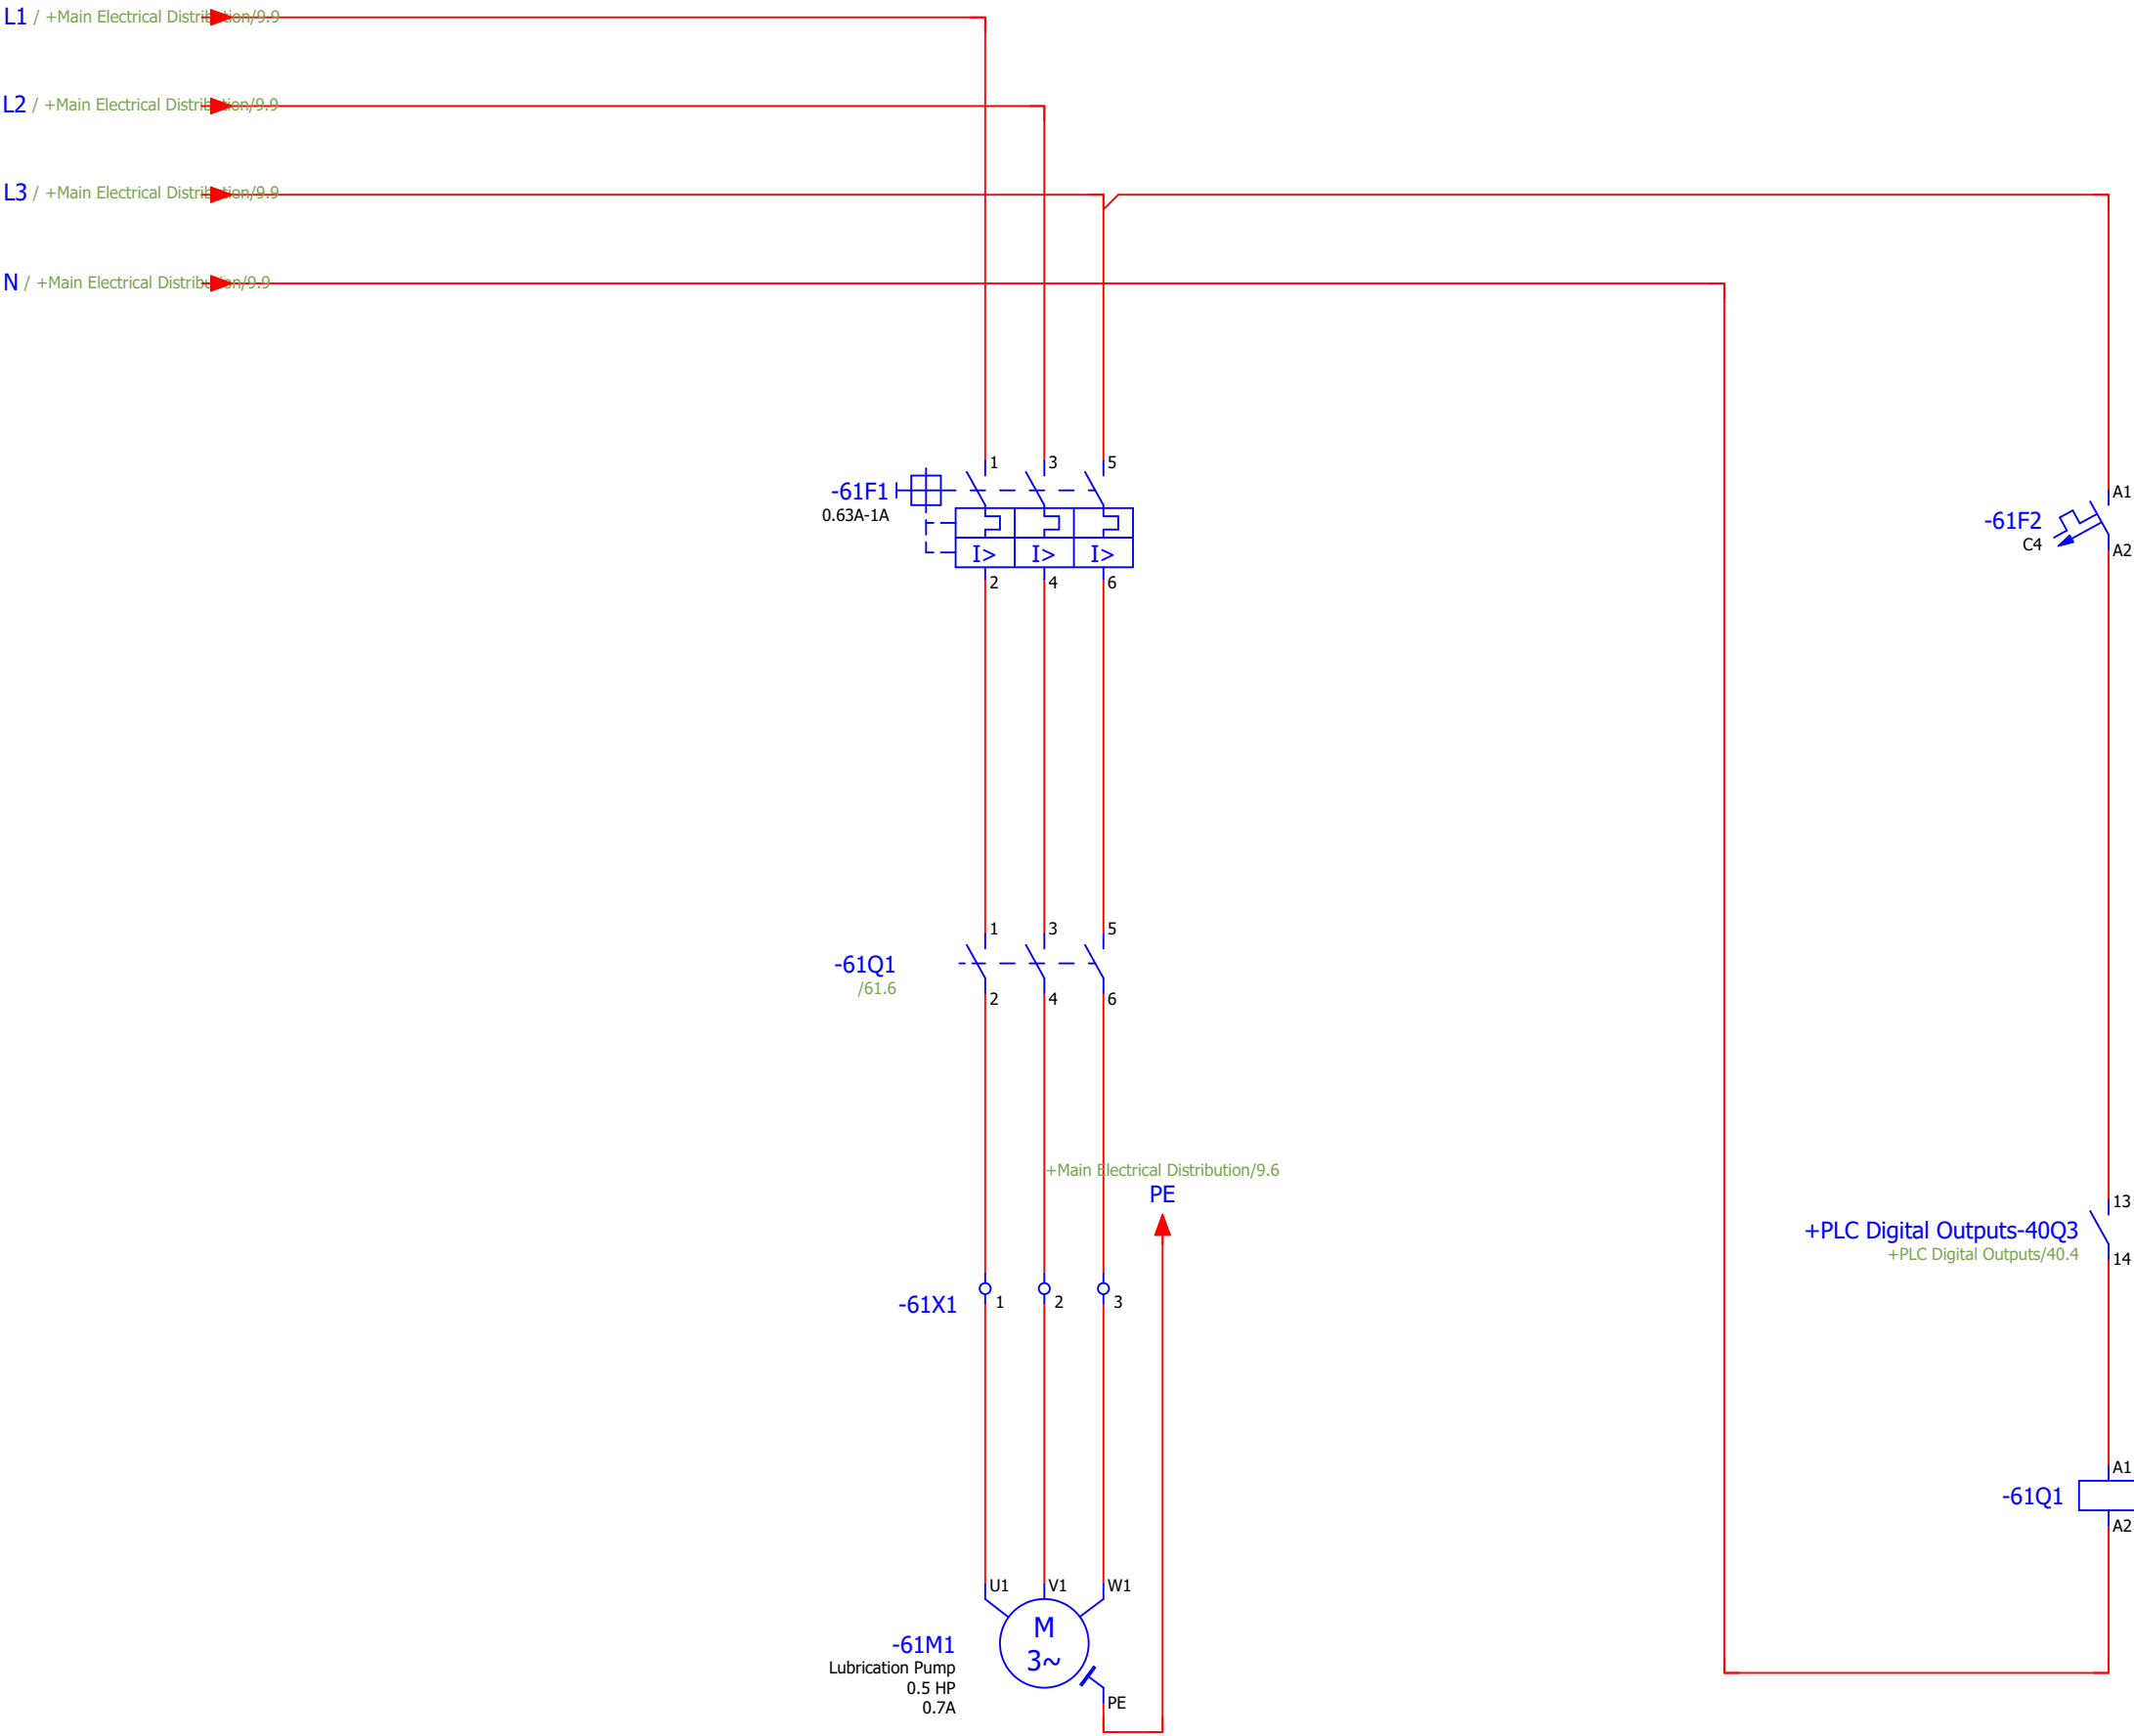

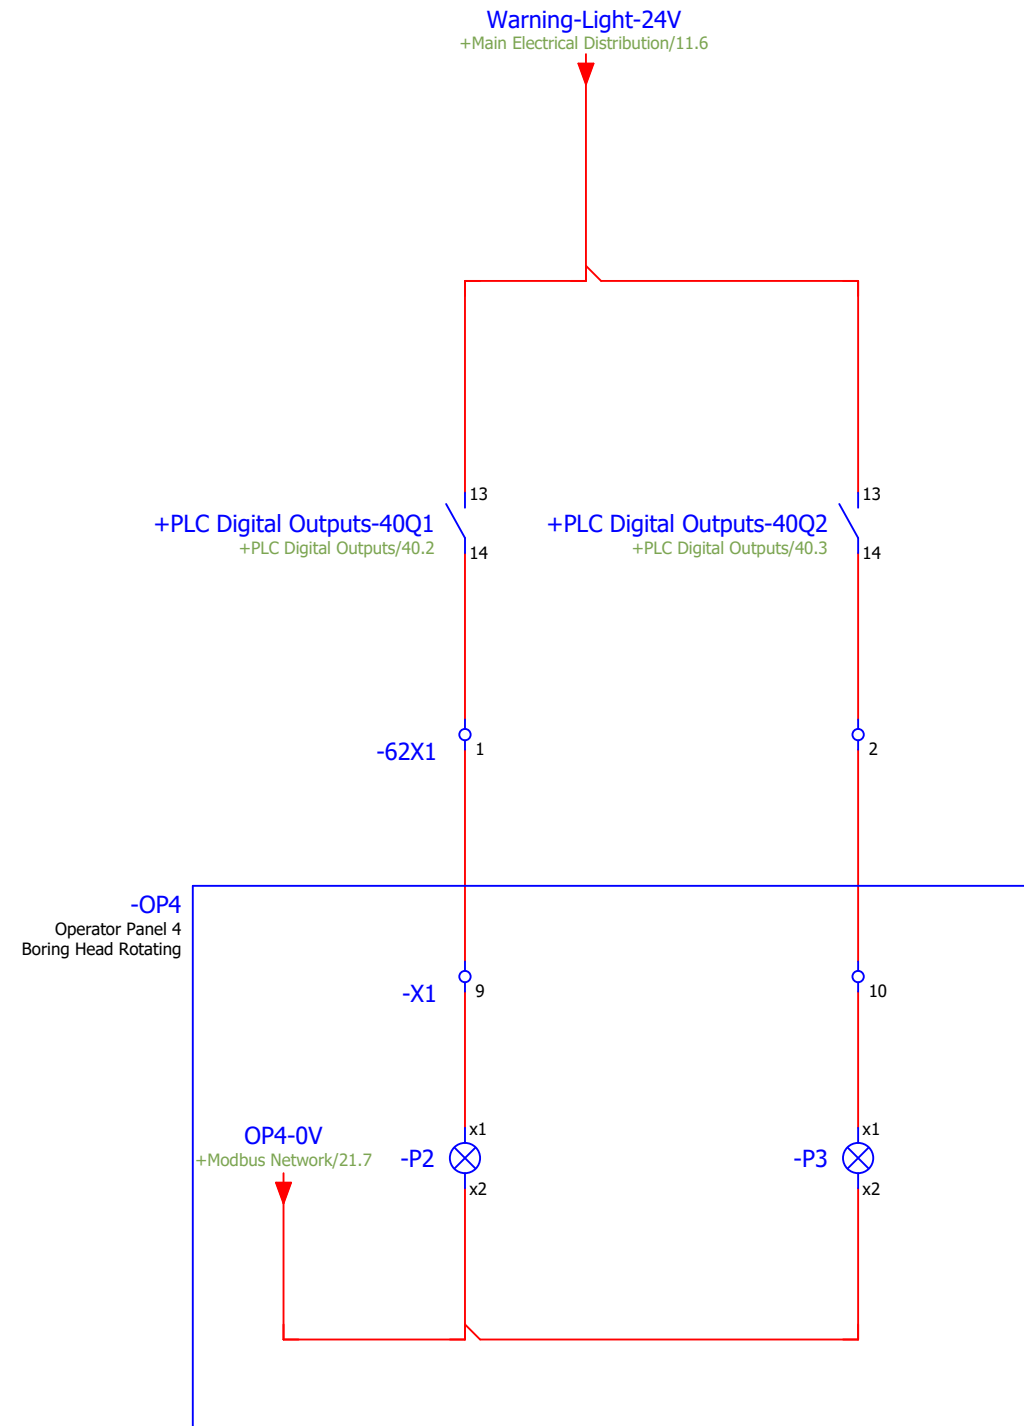

As Built				Project Description : Deep Hole Machin (DHD)	Page Description : Boring Head Rotating warning Lights		Job Number : ELEC-007		= DHD	
For Manufacturing	1404.10.14	Morteza Pourhasan					+ Feilds Wiring Diagram			
For Check	1404.9.15	Morteza Pourhasan	+989158875113				Software Version : EPLAN P8 2.9 SP1	Project Start : 8/30/2025	Last Edition : 10/13/2026	Page 62
Modification	Date	Design & Confirm	Contact US							Page 62 / 77

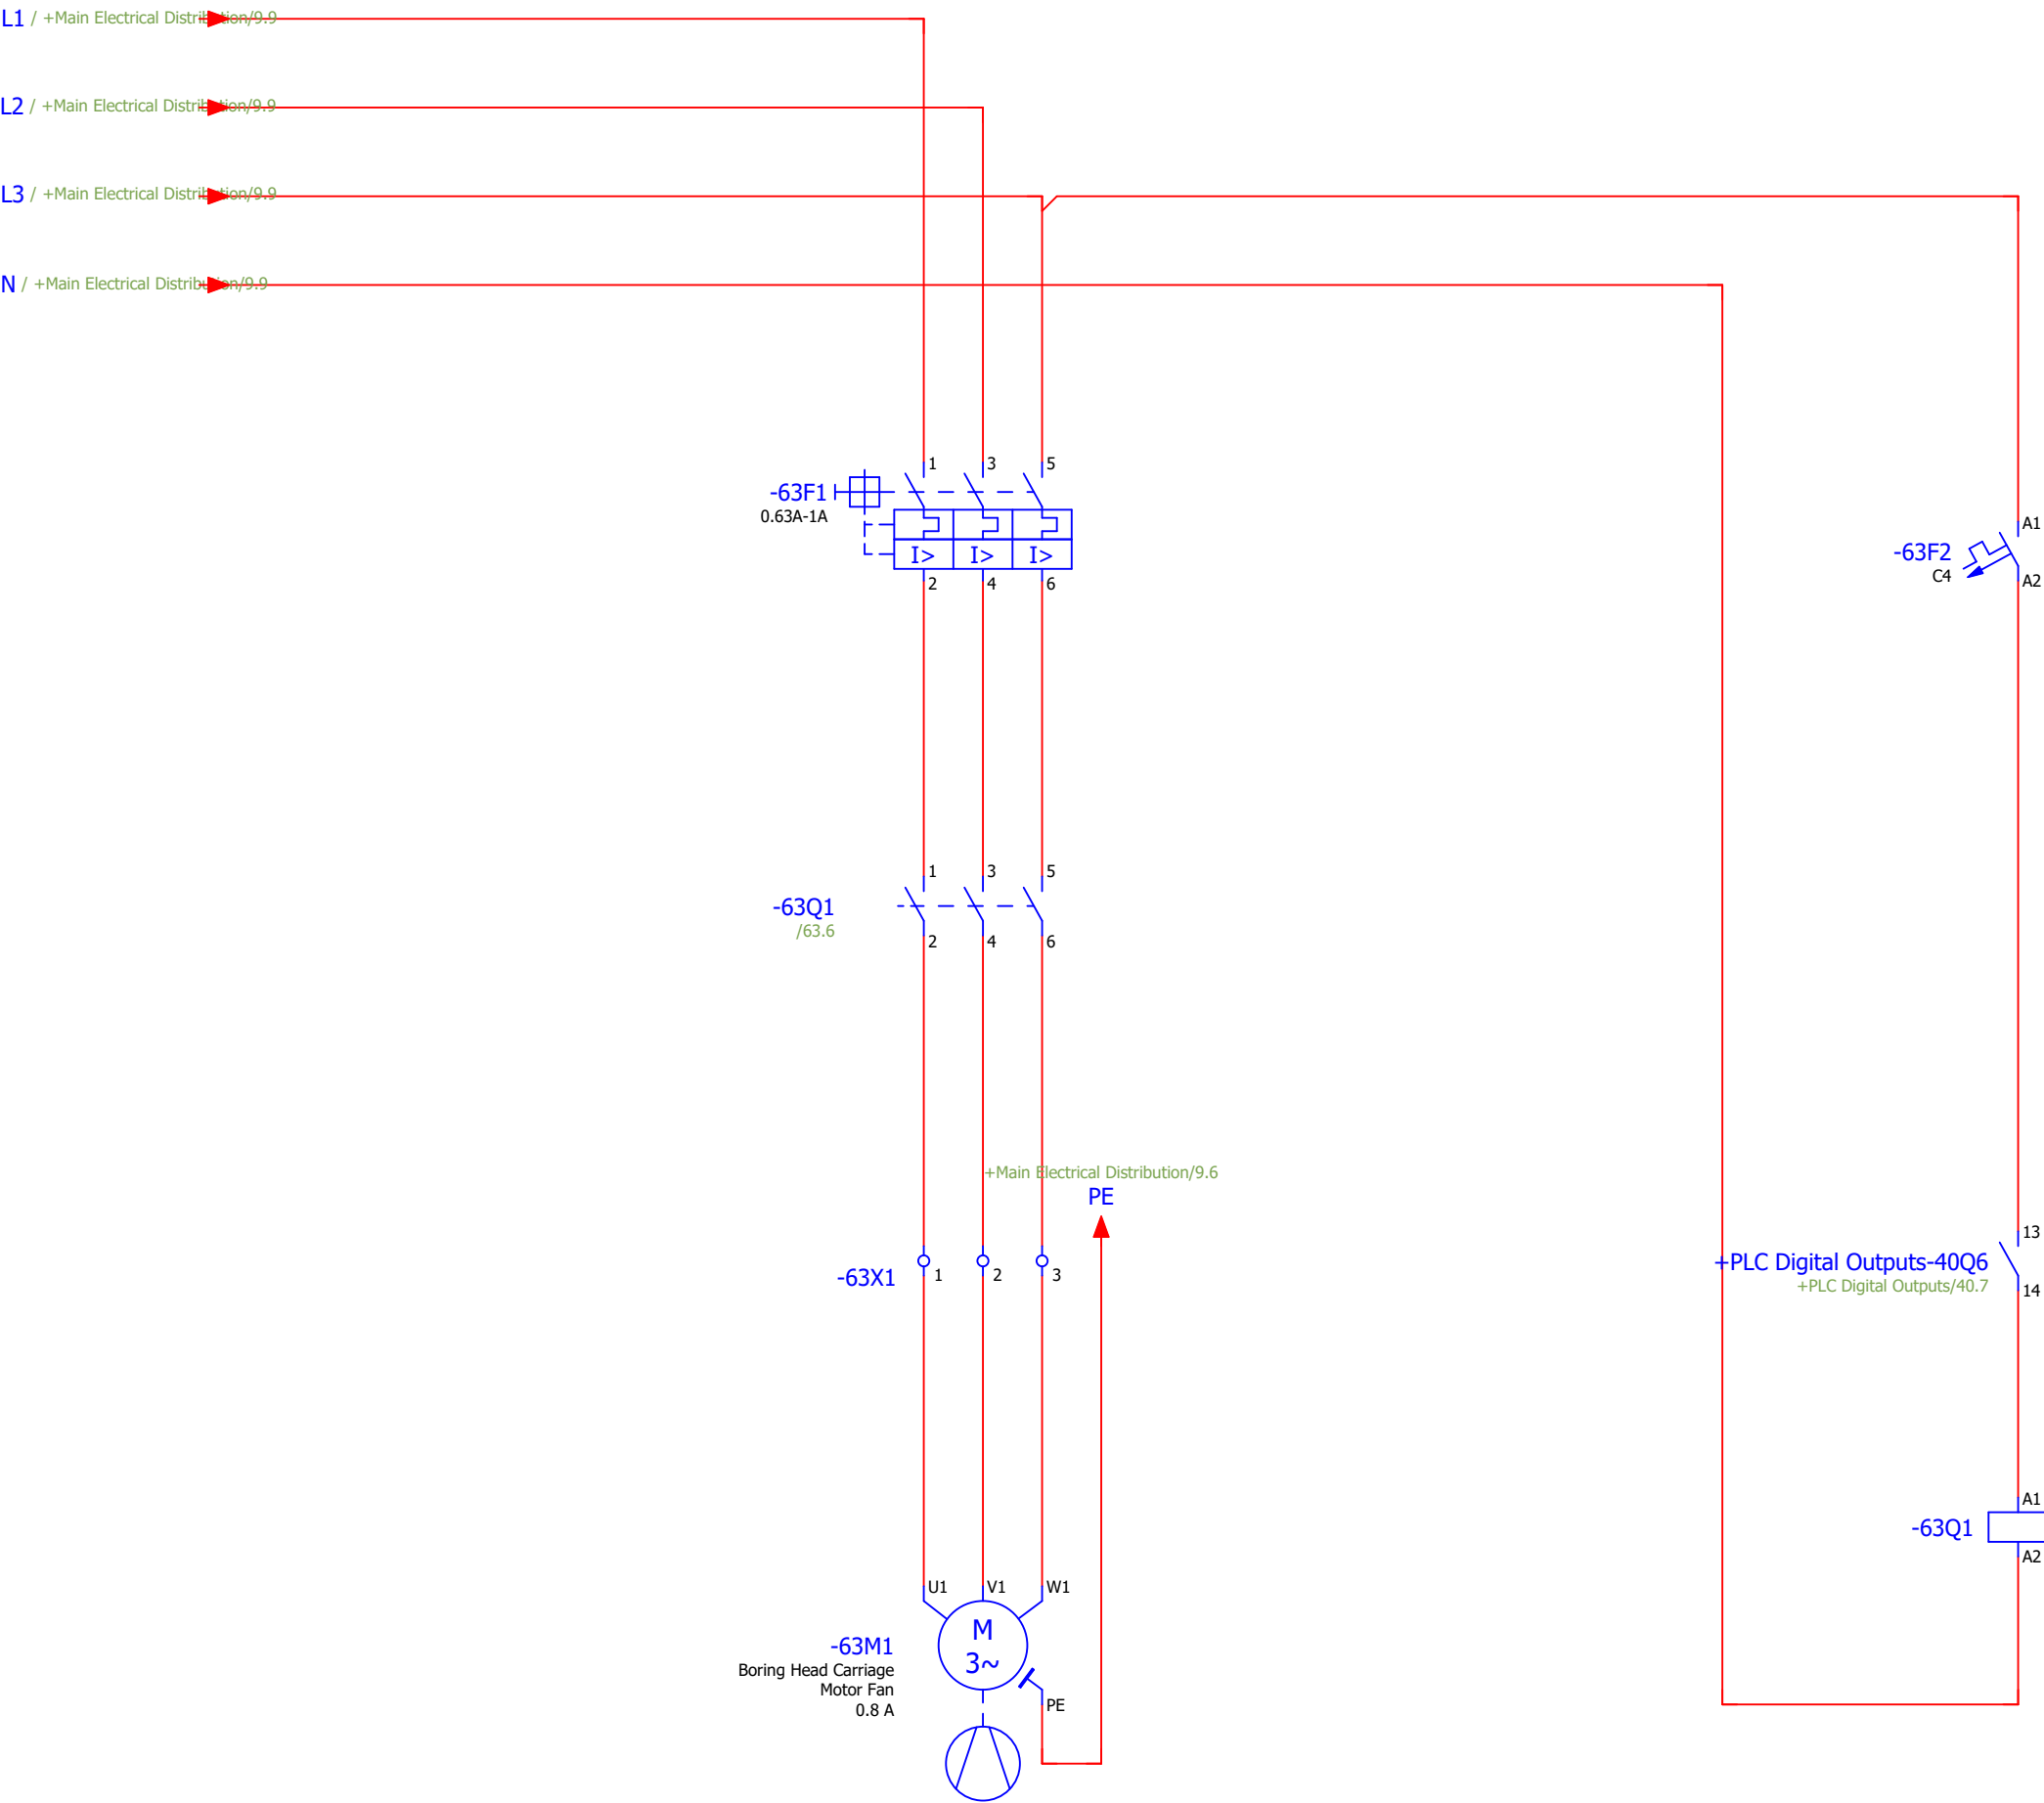

As Built			
For Manufacturing	1404.10.14	Morteza Pourhasan	
For Check	1404.9.15	Morteza Pourhasan	+989158875113
Modification	Date	Design & Confirm	Contact US


Project Description :
Deep Hole Machin (DHD)

Page Description :
Boring Head Carriage Motor Fan



Job Number :	ELEC-007
Software Version :	EPLAN P8 2.9 SP1
Project Start :	8/30/2025

= DHD	
+ Feilds Wiring Diagram	
Last Edition :	Page 63
10/13/2026	Page 63 / 77

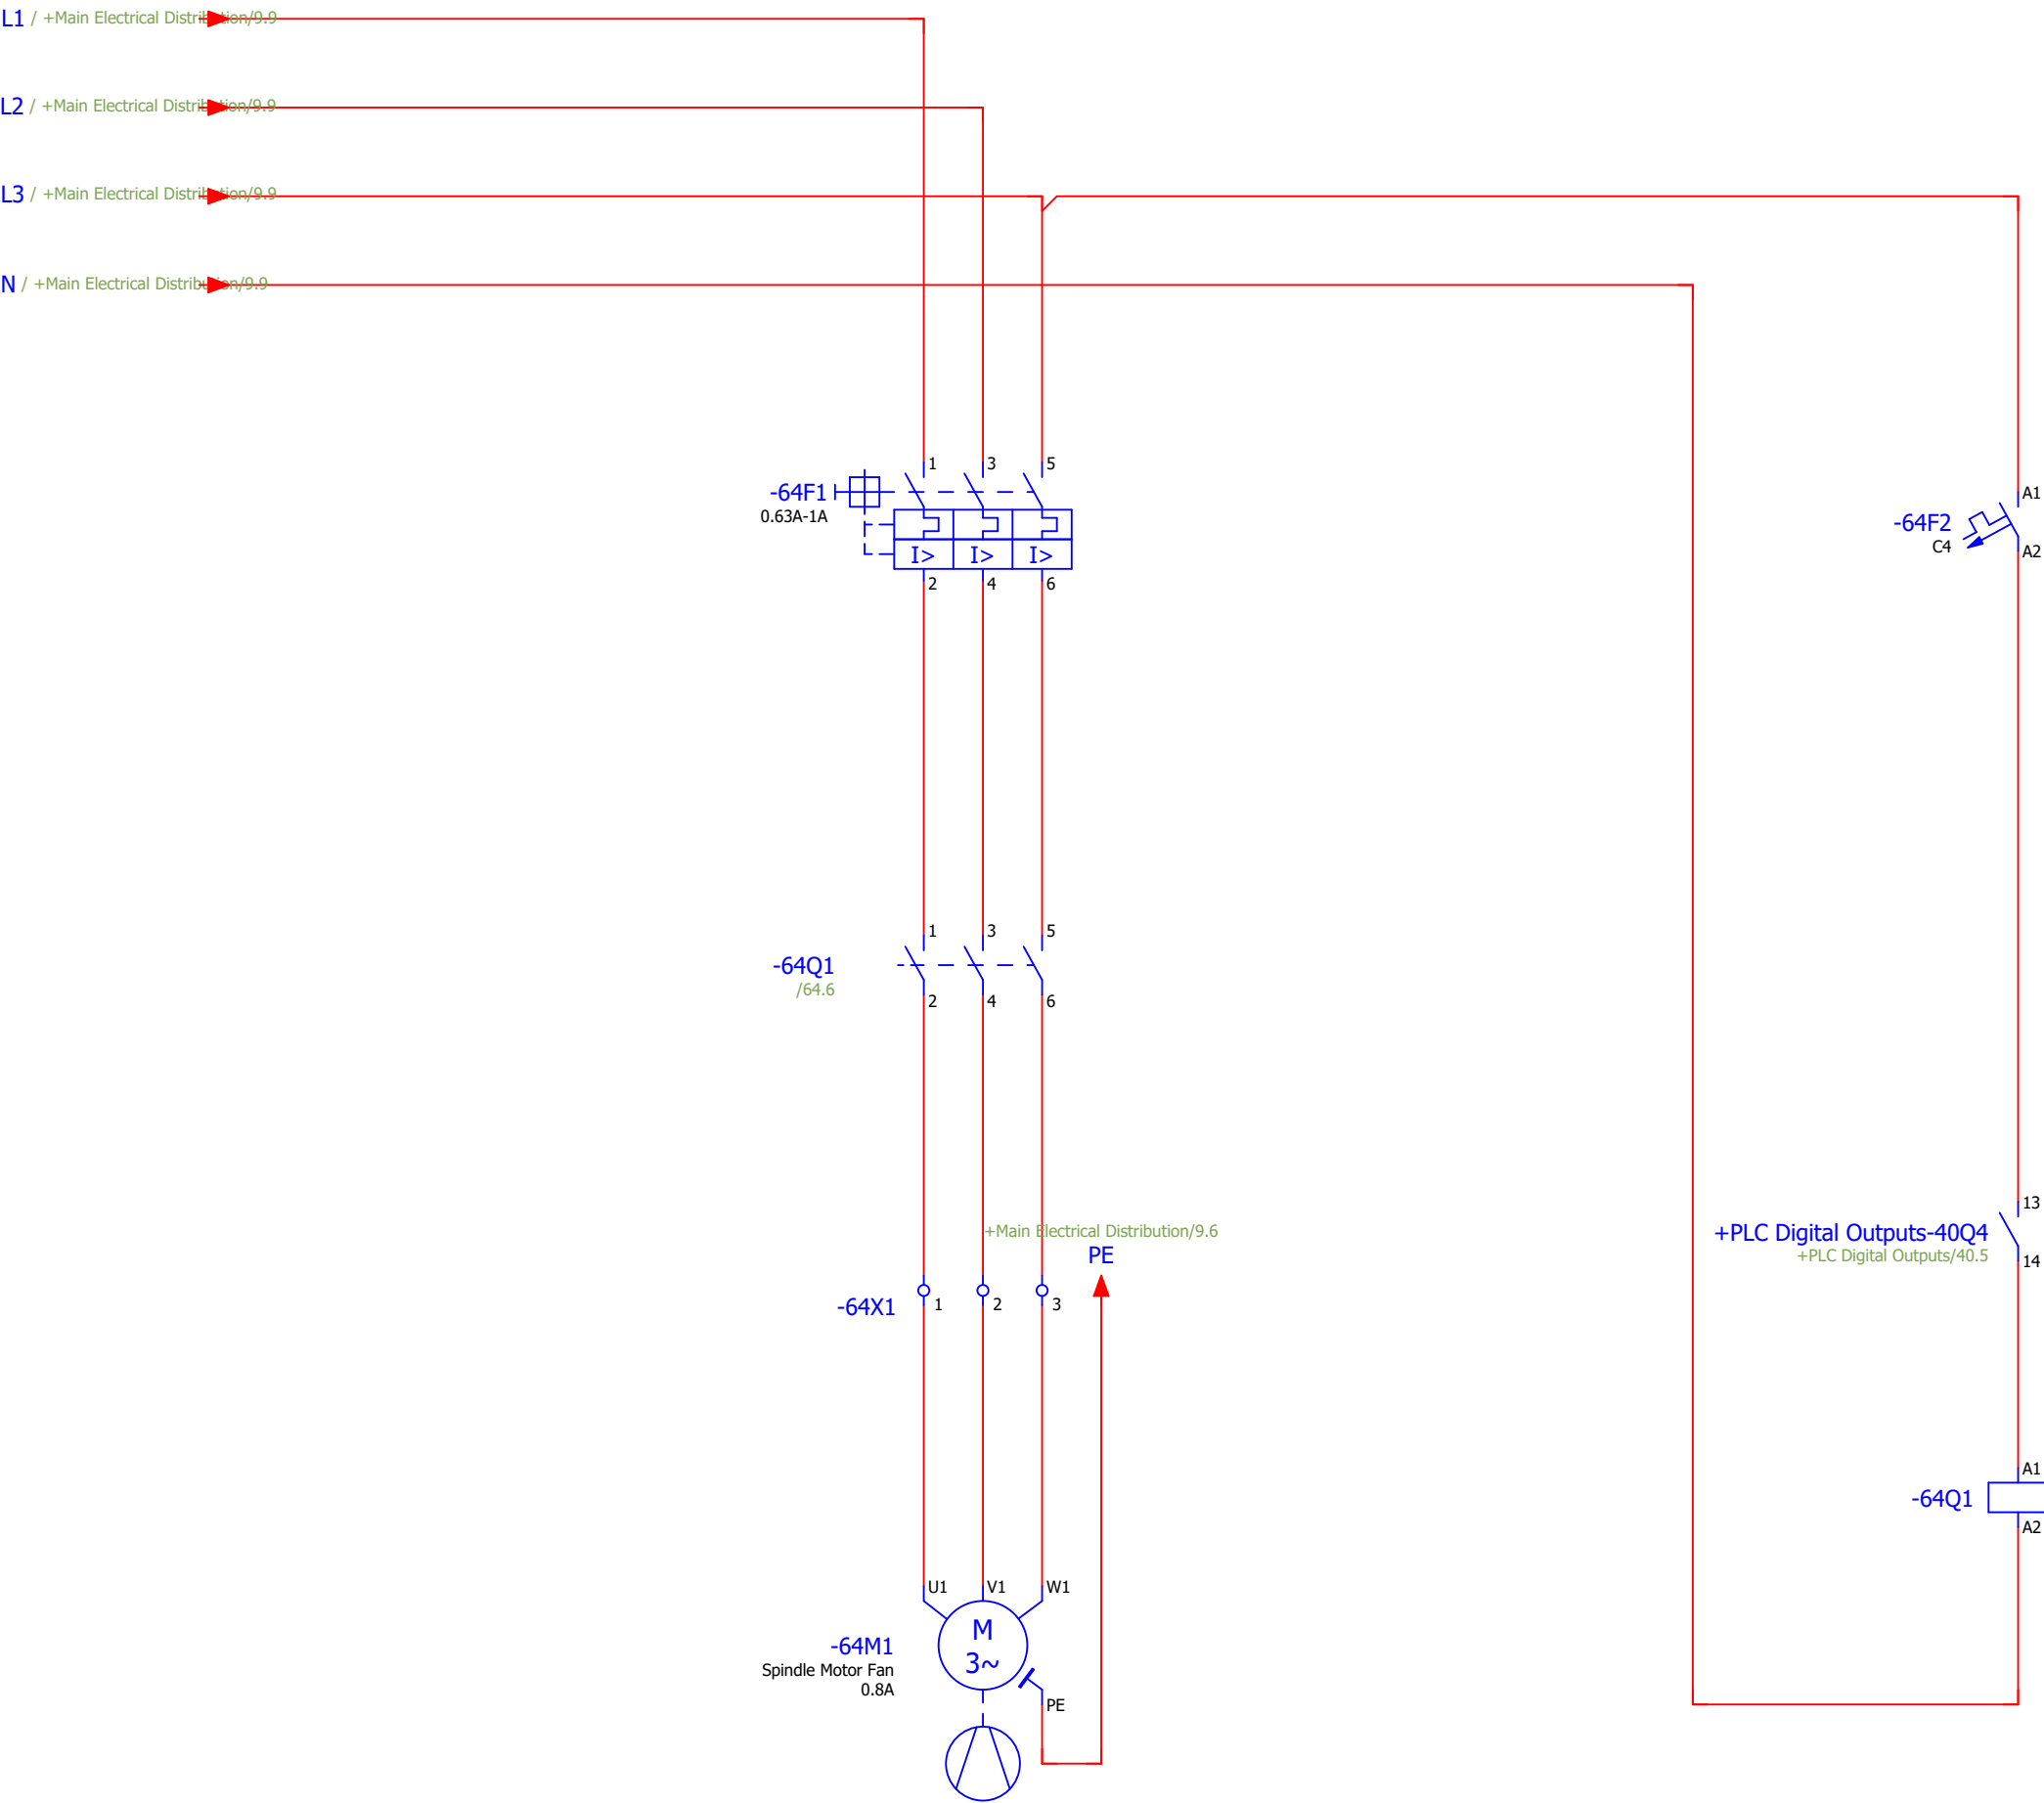

As Built			
For Manufacturing	1404.10.14	Morteza Pourhasan	
For Check	1404.9.15	Morteza Pourhasan	+989158875113
Modification	Date	Design & Confirm	Contact US

Project Description :
Deep Hole Machin (DHD)


Page Description :
Boring Head Rotating Motor Fan




Job Number :	ELEC-007	= DHD
Software Version :	Project Start :	+ Feilds Wiring Diagram
EPLAN P8 2.9 SP1	8/30/2025	Last Edition :
	10/13/2026	Page 64
		Page 64 / 77

L1 / +Main Electrical Distribution/9.9


N / +Main Electrical Distribution/9.9

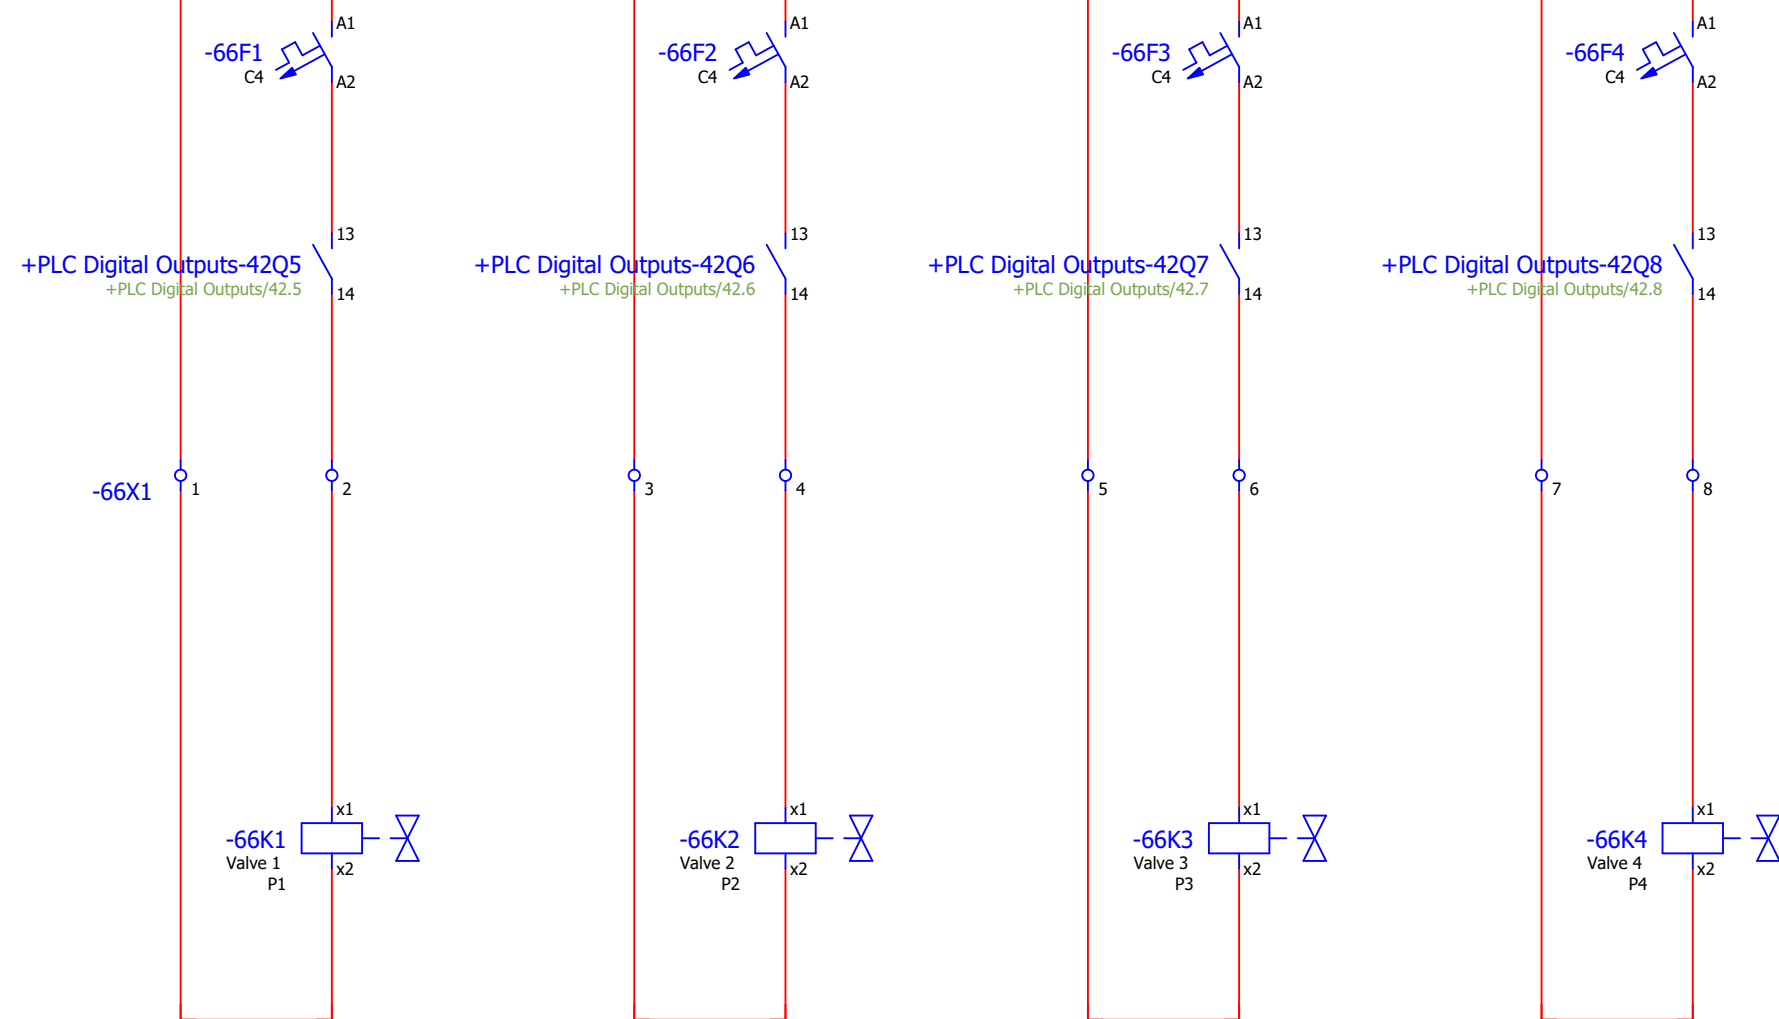


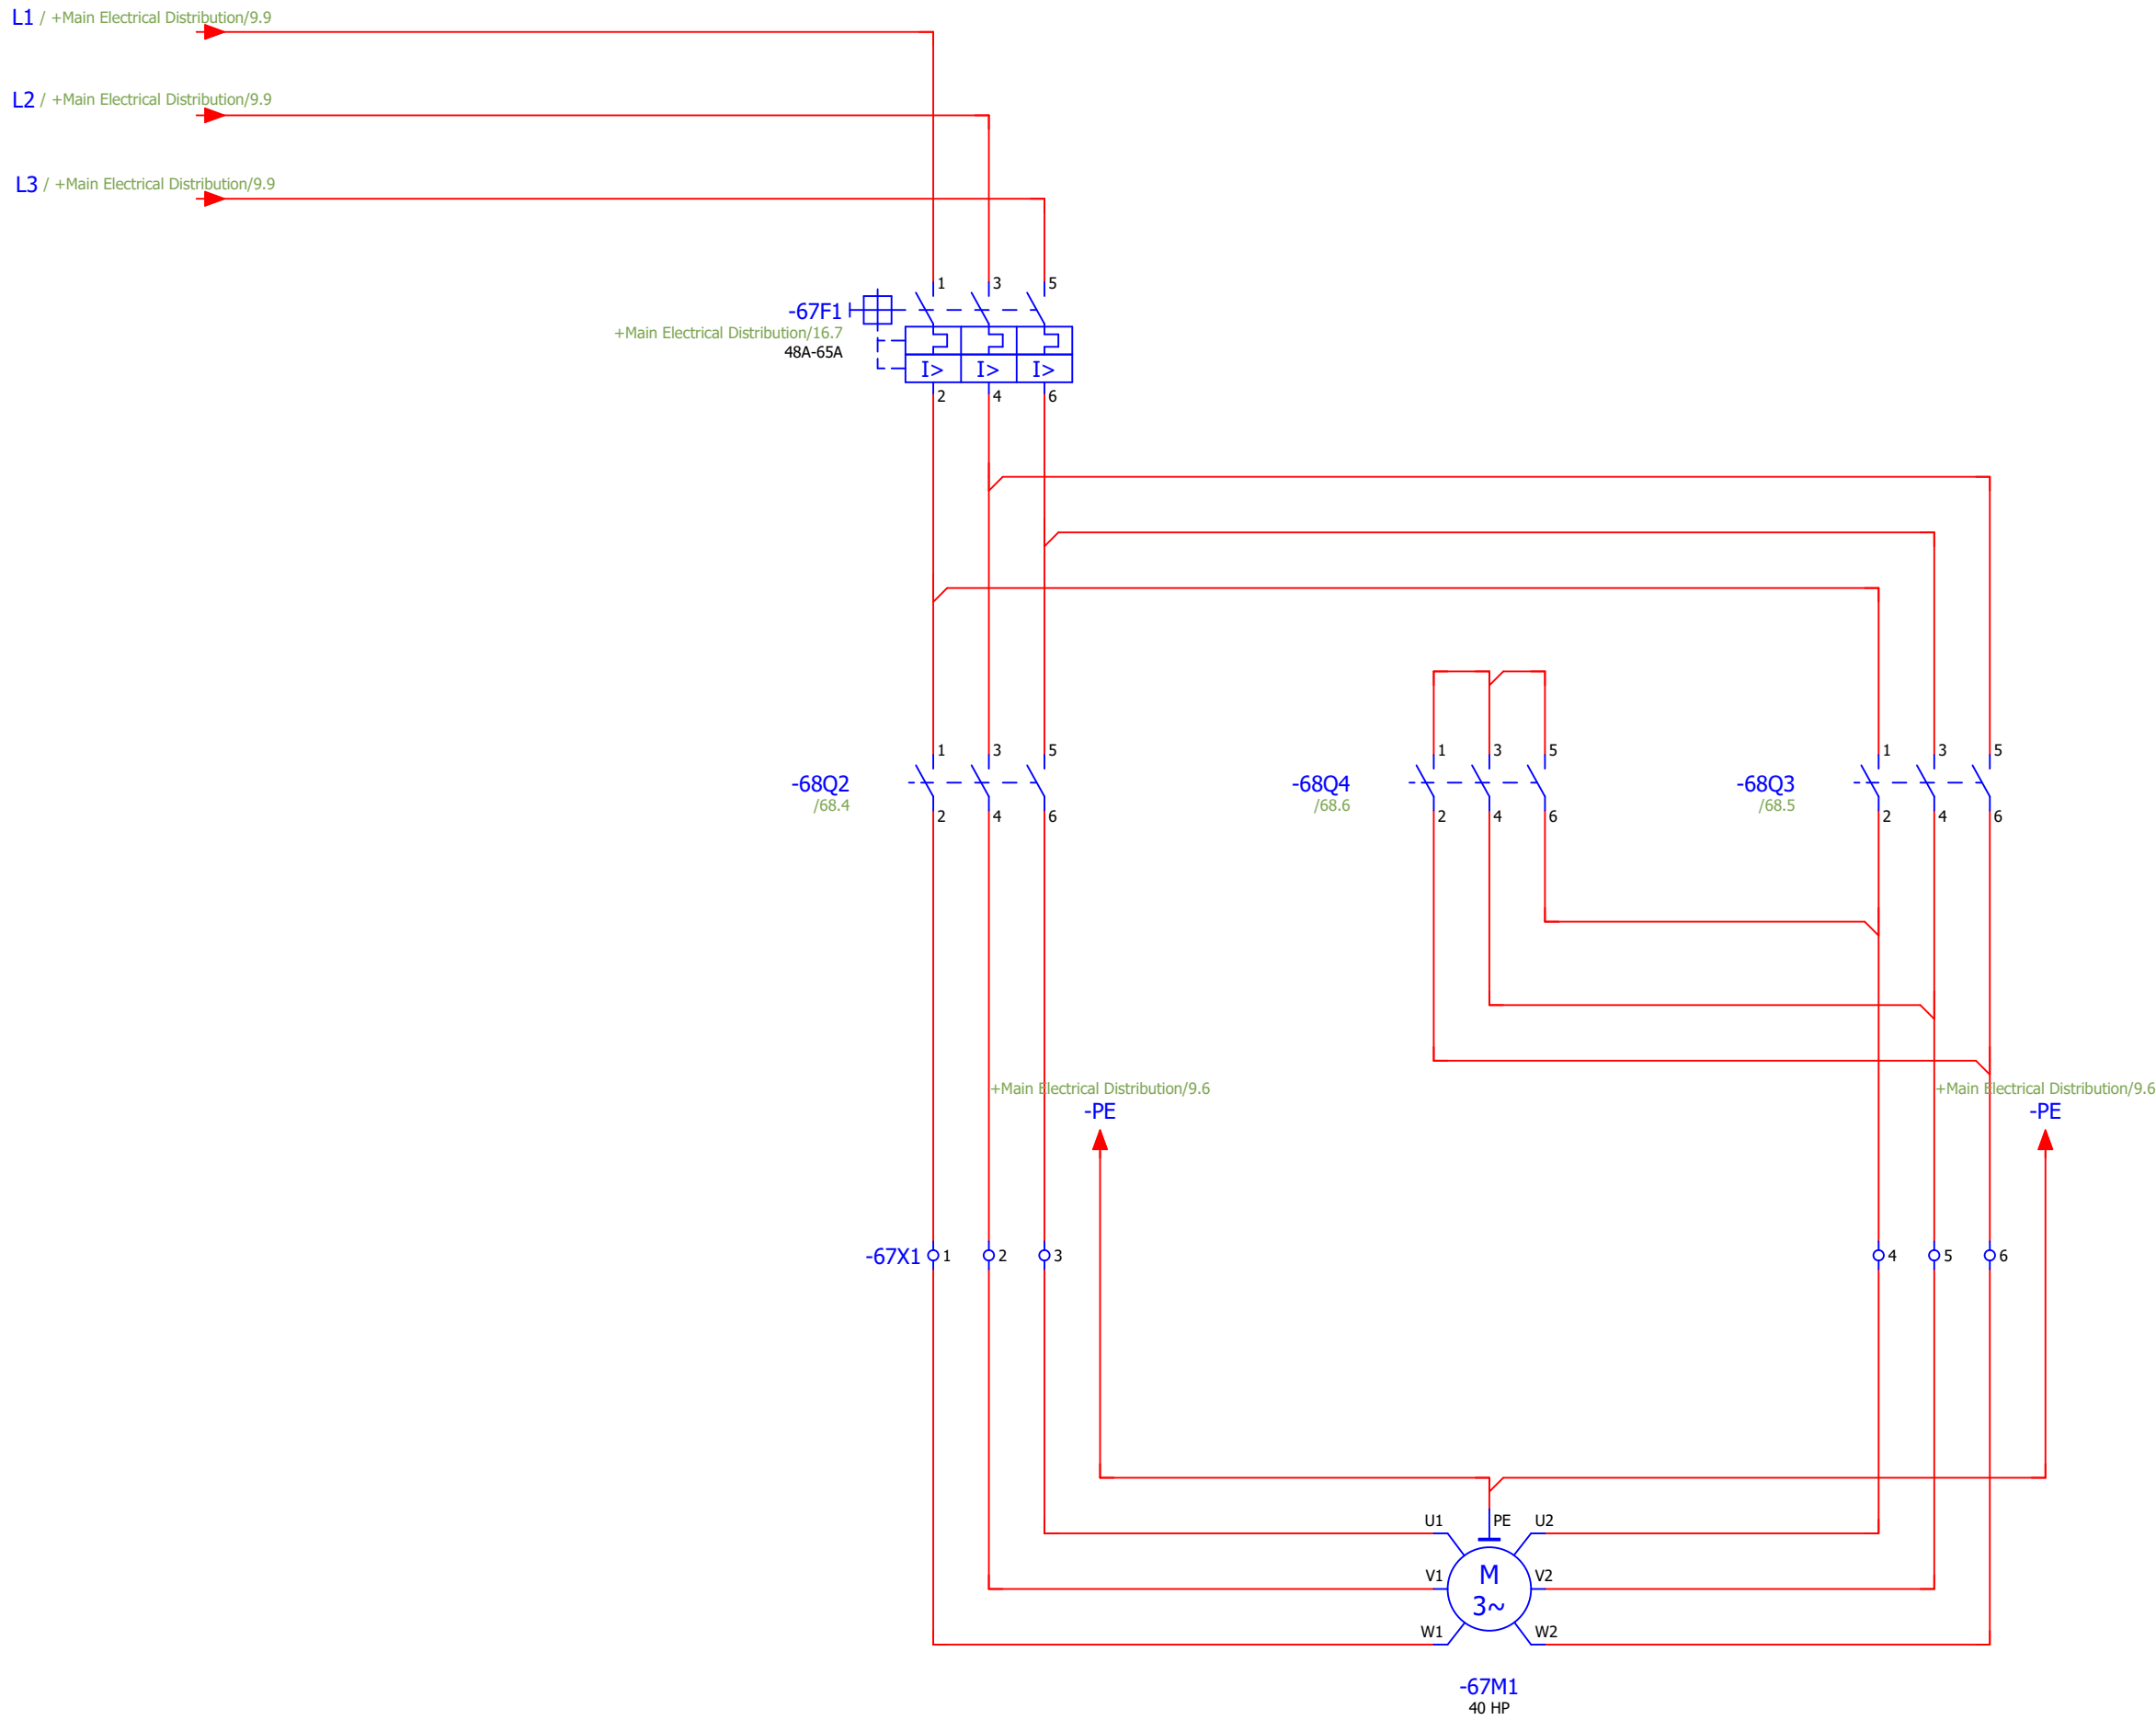


L1 / +Main Electrical Distribution/9.9

N / +Main Electrical Distribution/9.9

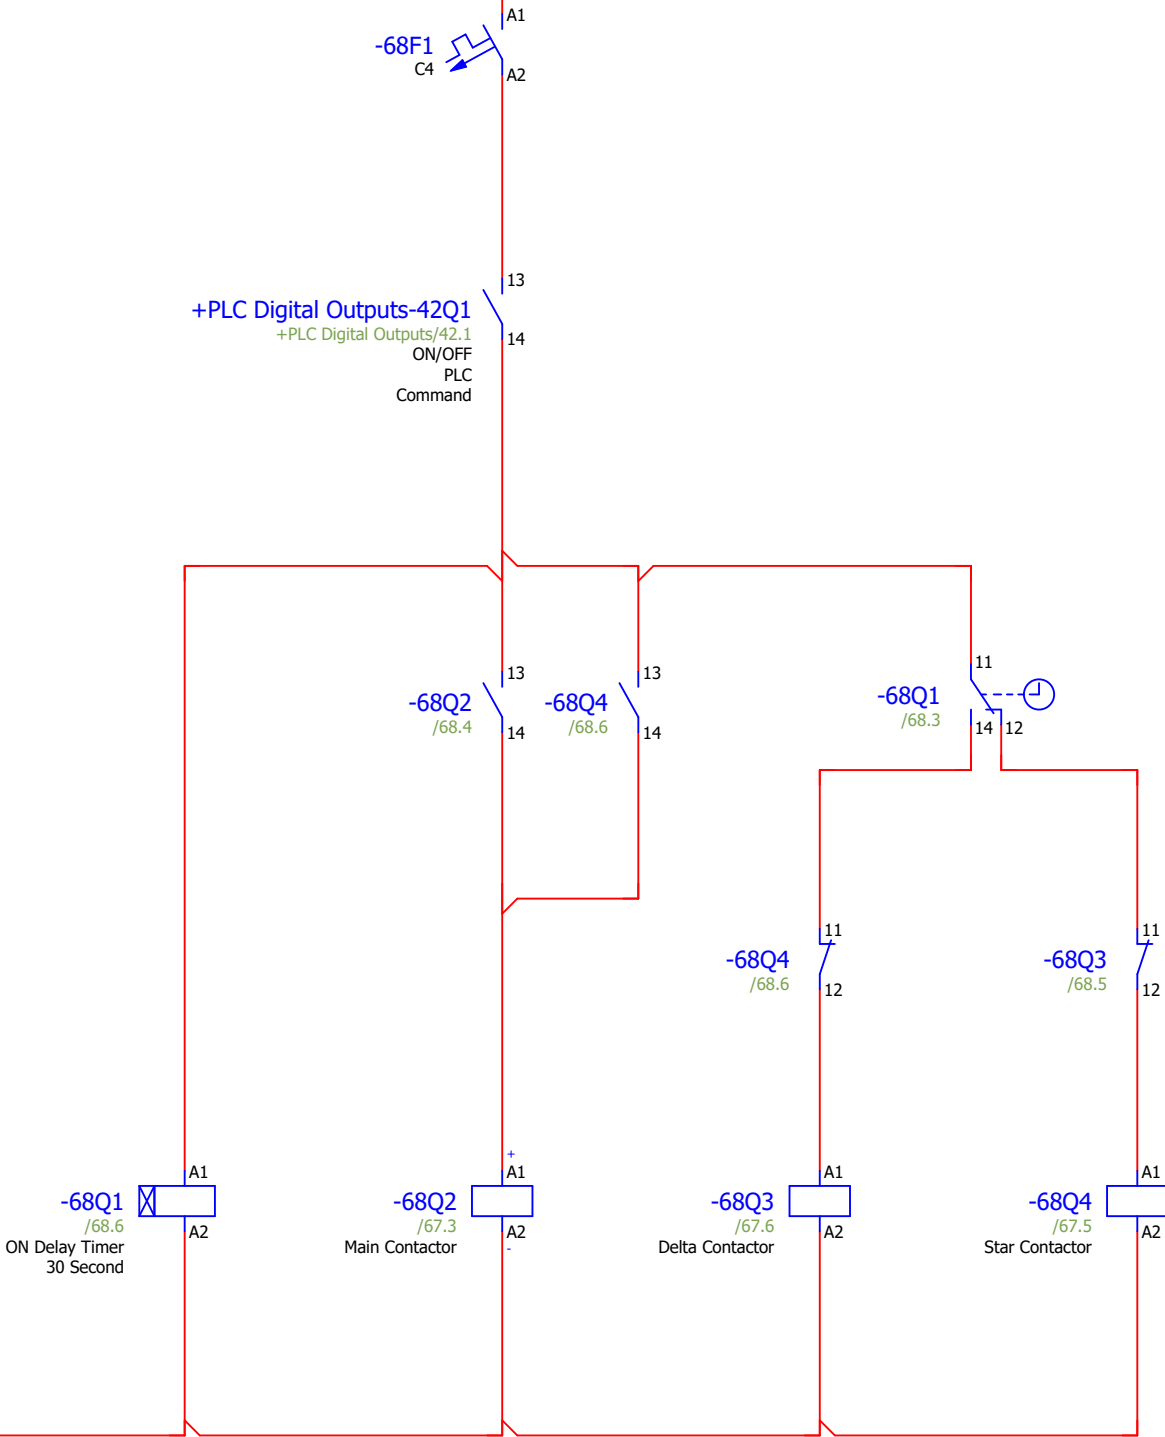

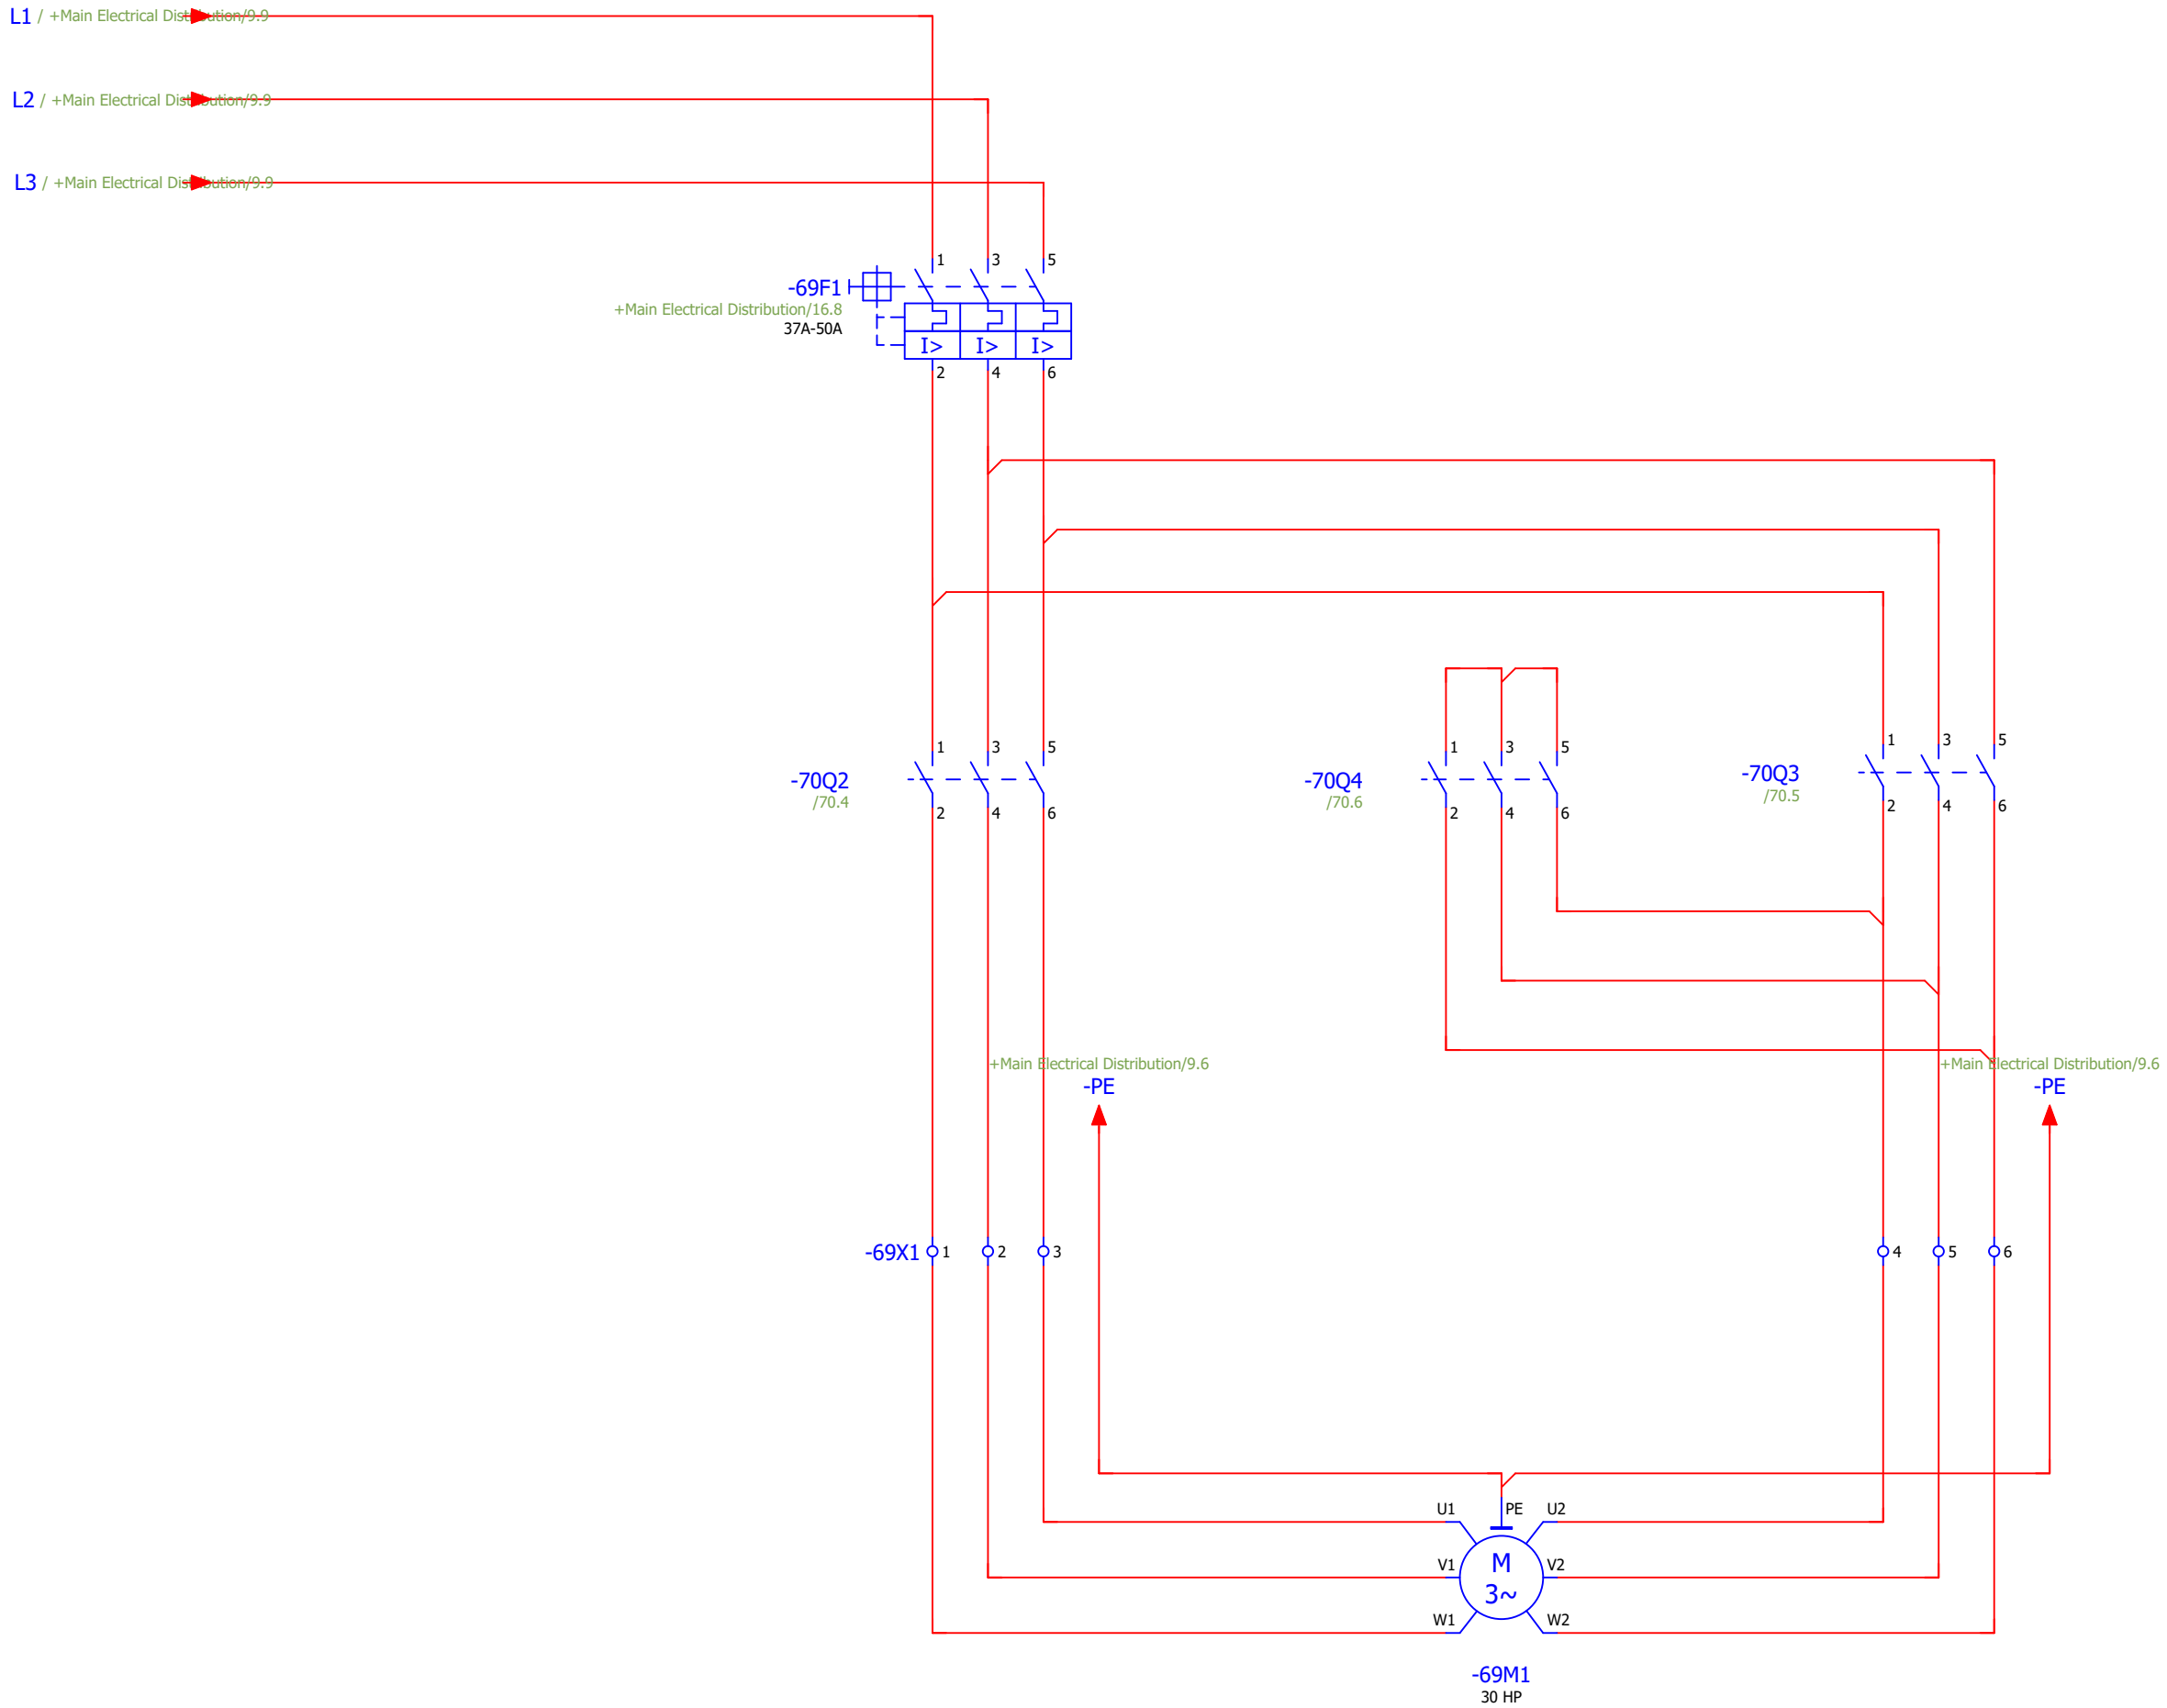

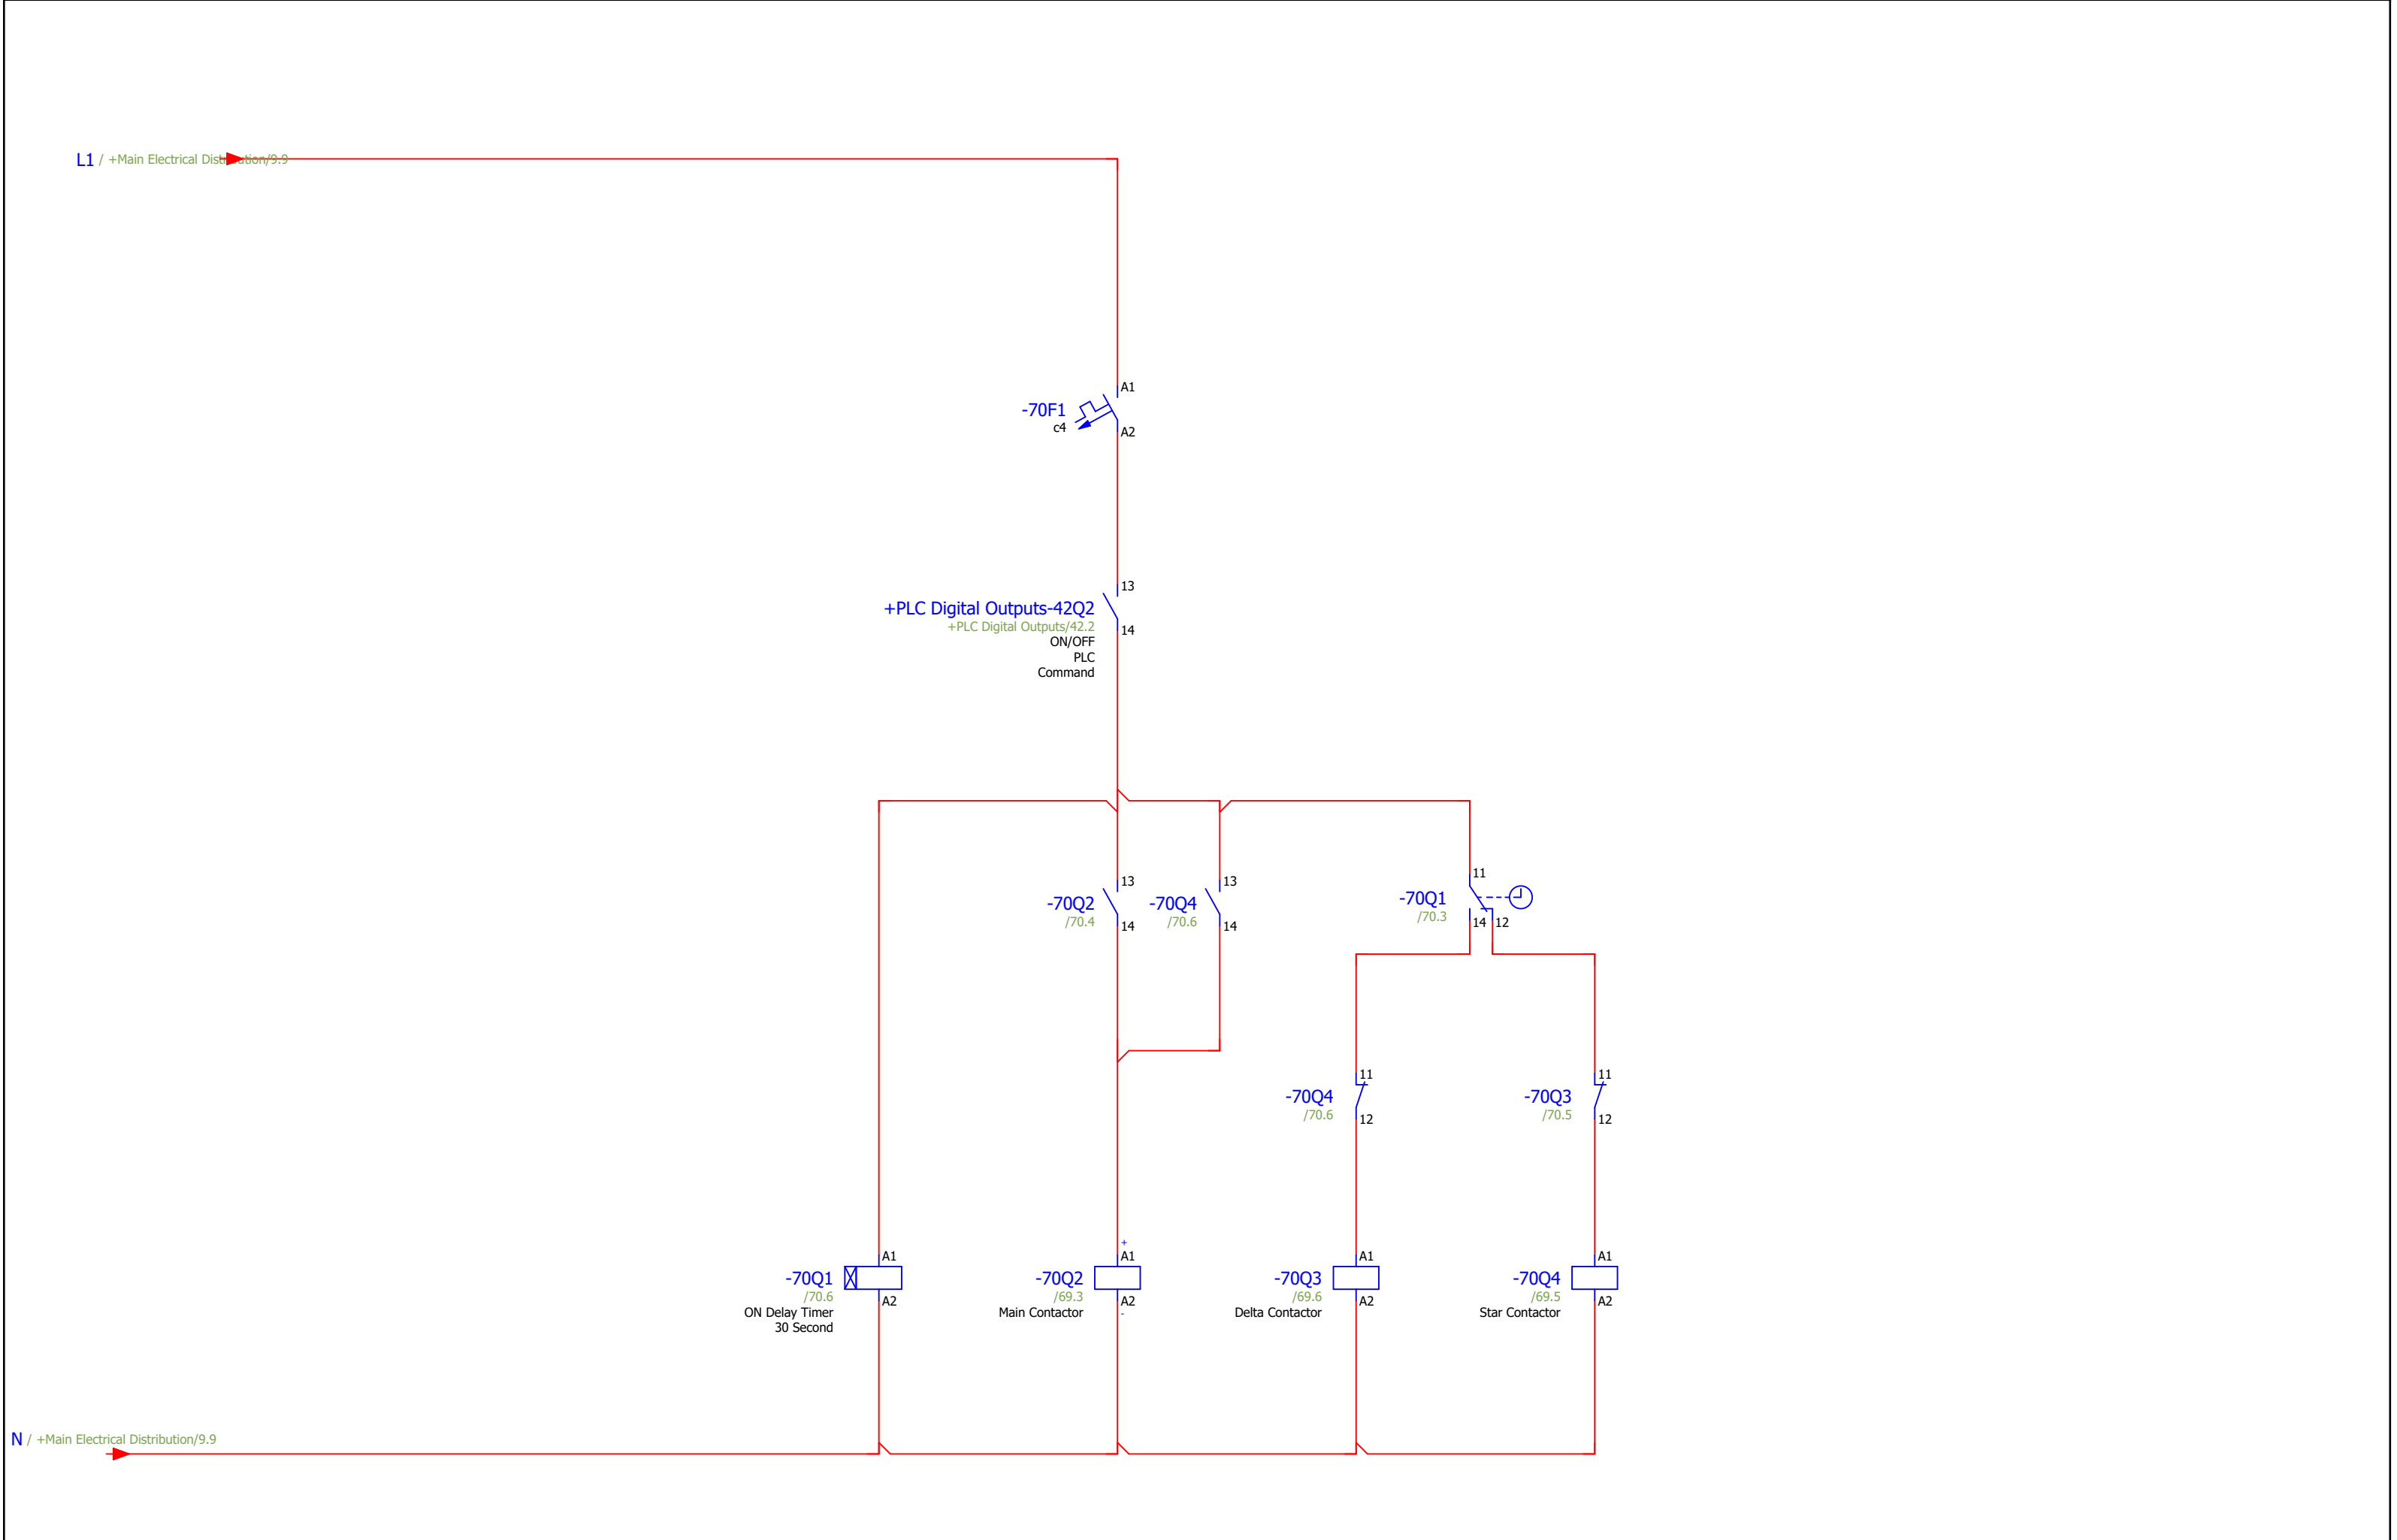

As Built				Project Description : Deep Hole Machin (DHD)	Page Description : Coolant Oil Pump 2		Job Number : ELEC-007		= DHD	
For Manufacturing	1404.10.14	Morteza Pourhasan							+ Feilds Wiring Diagram	
For Check	1404.9.15	Morteza Pourhasan	+989158875113				Software Version : EPLAN P8 2.9 SP1		Project Start : 8/30/2025	Last Edition : 10/13/2026
Modification	Date	Design & Confirm	Contact US						Page 70	Page 70 / 77

Device tag	Quantity	Designation	Part number	Supplier	Remark
+Main Electrical Distribution	0				
+Main Electrical Distribution-AI1	1	Delta DVP04AD-S2	Delta DVP04AD-S2	Contractor	Delta DVP04AD-S2
+Main Electrical Distribution-AI2	1	Delta DVP04AD-S2	Delta DVP04AD-S2	Contractor	Delta DVP04AD-S2
+Main Electrical Distribution-AO1	1	DVP04DA-S2	Delta DVP04DA-S2	Contractor	Delta DVP04DA-S2
+Main Electrical Distribution-AirConditioner	1		Air Conditioner 2000Watt Minimum	Contractor	Tahviyh Novin/Sarma Pouyesh/Neo Pars
+Main Electrical Distribution-13B1	1	Employer Supply	Employer Supply	-	Employer Supply
+Main Electrical Distribution-13B2	1	Employer Supply	Employer Supply	-	Employer Supply
+Main Electrical Distribution-13B3	1	Employer Supply	Employer Supply	-	Employer Supply
+Main Electrical Distribution-13B4	1	Employer Supply	Employer Supply	-	Employer Supply
+Main Electrical Distribution-15B1	1		According Standard	Contractor	Suitable Device According Standard
+Main Electrical Distribution-9CP1	1		Schenieder Phase Control	Contractor	Schenieder Phase Control
+Main Electrical Distribution-CPU	1	Delta DVP12SE11T	Delta DVP12SE11T	Contractor	Delta DVP12SE11T
+Main Electrical Distribution-DI1	1	DVP16SM11N	Delta DVP16SM11N	Contractor	Delta DVP16SM11N
+Main Electrical Distribution-DI2	1	DVP16SM11N	Delta DVP16SM11N	Contractor	Delta DVP16SM11N
+Main Electrical Distribution-DI3	1	DVP16SM11N	Delta DVP16SM11N	Contractor	Delta DVP16SM11N
+Main Electrical Distribution-DI4	1	DVP16SM11N	Delta DVP16SM11N	Contractor	Delta DVP16SM11N
+Main Electrical Distribution-DO1	1	DVP16SN11T	Delta DVP16SN11T	Contractor	Delta DVP16SN11T
+Main Electrical Distribution-DO2	1	DVP16SN11T	Delta DVP16SN11T	Contractor	Delta DVP16SN11T
+Main Electrical Distribution-DO3	1	DVP16SN11T	Delta DVP16SN11T	Contractor	Delta DVP16SN11T
+Main Electrical Distribution-DO4	1	Delta DVP08SN11T	Delta DVP08SN11T	Contractor	Delta DVP08SN11T
+Main Electrical Distribution-9F1	1	Schneider MCCB 400A Setable With Extended Rotary handle	Schneider MCCB 400A Setable	Contractor	Schneider MCCB 400A Setable With Extended Rotary handle
+Main Electrical Distribution-9F2	1		RAAD Terminal Fuse With Fuse	Contractor	RAAD Terminal Fuse With Fuse
+Main Electrical Distribution-9F3	1		RAAD Terminal Fuse With Fuse	Contractor	RAAD Terminal Fuse With Fuse
+Main Electrical Distribution-9F4	1		RAAD Terminal Fuse With Fuse	Contractor	RAAD Terminal Fuse With Fuse
+Main Electrical Distribution-9F5	1		RAAD Terminal Fuse With Fuse	Contractor	RAAD Terminal Fuse With Fuse
+Main Electrical Distribution-9F6	1		RAAD Terminal Fuse With Fuse	Contractor	RAAD Terminal Fuse With Fuse
+Main Electrical Distribution-9F7	1		RAAD Terminal Fuse With Fuse	Contractor	RAAD Terminal Fuse With Fuse
+Main Electrical Distribution-10F1	1	Pichaz IDS-251 With Fuse	Pichaz IDS-251	Contractor	Pichaz IDS-251 With Fuse
+Main Electrical Distribution-10F2	1	Schnieder 2-Pole MCB C10	Schnieder 2-Pole MCB C10	Contractor	Schnieder 2-Pole MCB C10
+Main Electrical Distribution-15F3	1	Schnieder MCB C25	Schnieder MCB C25	Contractor	Schnieder 1-Pole MCB C25
+Main Electrical Distribution-17F1	1	Schnieder MCB C4	Schnieder MCB C4	Contractor	Schnieder 1-Pole MCB C4
+Main Electrical Distribution-17F2	1		RAAD Terminal Fuse With Fuse	Contractor	RAAD Terminal Fuse With Fuse
+Main Electrical Distribution-HMI-OP	1		HMI-OP Local Panel Thicnees:2mm	Contractor	HMI-OP Local Panel Thicnees:2mm
+Main Electrical Distribution-HMI-OP-A1	1	Delta HMI DOP-110WS	Delta HMI DOP-110WS	Contractor	Delta HMI DOP-110WS
+Main Electrical Distribution-HMI-OP-S1	1		According Standard	Contractor	Suitable Device According Standard
+Main Electrical Distribution-HMI-OP-S6	1		According Standard	Contractor	Suitable Device According Standard
+Main Electrical Distribution-15Light1	1		According Standard	Contractor	Suitable Device According Standard
+Main Electrical Distribution-OP1-S6	1	Employer Supply	Employer Supply	-	Employer Supply
+Main Electrical Distribution-OP2-S6	1	Employer Supply	Employer Supply	-	Employer Supply
+Main Electrical Distribution-OP3-S6	1	Employer Supply	Employer Supply	-	Employer Supply

Parts list

F01_001

Device tag	Quantity	Designation	Part number	Supplier	Remark
+Main Electrical Distribution-OP4-S6	1	Employer Supply	Employer Supply	-	Employer Supply
+Main Electrical Distribution-9P1	1		According Standard	Contractor	Suitable Device According Standard
+Main Electrical Distribution-9P2	1		According Standard	Contractor	Suitable Device According Standard
+Main Electrical Distribution-9P3	1		According Standard	Contractor	Suitable Device According Standard
+Main Electrical Distribution-9P4	1		According Standard	Contractor	Suitable Device According Standard
+Main Electrical Distribution-9P5	1		According Standard	Contractor	Suitable Device According Standard
+Main Electrical Distribution-9P6	1		According Standard	Contractor	Suitable Device According Standard
+Main Electrical Distribution-9P7	1		According Standard	Contractor	Suitable Device According Standard
+Main Electrical Distribution-16P1	1		According Standard	Contractor	Suitable Device According Standard
+Main Electrical Distribution-16P2	1		According Standard	Contractor	Suitable Device According Standard
+Main Electrical Distribution-16P3	1		According Standard	Contractor	Suitable Device According Standard
+Main Electrical Distribution-16P4	1		According Standard	Contractor	Suitable Device According Standard
+Main Electrical Distribution-16P5	1		According Standard	Contractor	Suitable Device According Standard
+Main Electrical Distribution-16P6	1		According Standard	Contractor	Suitable Device According Standard
+Main Electrical Distribution-16P7	1		According Standard	Contractor	Suitable Device According Standard
+Main Electrical Distribution-PS	1	DVP-PS02	Delta DVP-PS02	Contractor	Delta DVP-PS02
+Main Electrical Distribution-12Q1	1	FINDER RELAY 40.61.9.024.0000 With 95.05 Socket	Finder : 40.61.9.024.0000	Contractor	Coil : 24 V/16A 1NO/1NC
+Main Electrical Distribution-13Q1	1	FINDER RELAY 40.61.9.024.0000 With 95.05 Socket	Finder : 40.61.9.024.0000	Contractor	Coil : 24 V/16A 1NO/1NC
+Main Electrical Distribution-13Q2	1	FINDER RELAY 40.61.9.024.0000 With 95.05 Socket	Finder : 40.61.9.024.0000	Contractor	Coil : 24 V/16A 1NO/1NC
+Main Electrical Distribution-14Q1	1	Schneider Contactor LC1D40M7- Coil : 230V	Schneider Contactor LC1D40M7	Contractor	Schneider Contactor LC1D40M7- Coil : 230V
+Main Electrical Distribution-14Q2	1	Schneider Contactor LC1F185M7- Coil : 230V	Schneider Contactor LC1F185M7	Contractor	Schneider Contactor LC1F185M7- Coil : 230V
+Main Electrical Distribution-14Q3	1	Schneider Contactor LC1D50M7- Coil : 230V	Schneider Contactor LC1D50M7	Contractor	Schneider Contactor LC1D50M7- Coil : 230V
+Main Electrical Distribution-14Q4	1	Schneider Contactor LC1D50M7- Coil : 230V	Schneider Contactor LC1D50M7	Contractor	Schneider Contactor LC1D50M7- Coil : 230V
+Main Electrical Distribution-14Q5	1	Schneider Contactor LC1D115M7- Coil : 230V	Schneider Contactor LC1D115M7	Contractor	Schneider Contactor LC1D115M7- Coil : 230V
+Main Electrical Distribution-15Q1	1		According Standard	Contractor	Suitable Device According Standard
+Main Electrical Distribution-17R1	1	Employer Supply	Employer Supply	-	Employer Supply
+Main Electrical Distribution-17R2	1	Employer Supply	Employer Supply	-	Employer Supply
+Main Electrical Distribution-12S1	1		According Standard	Contractor	Suitable Device According Standard
+Main Electrical Distribution-15Socket1	1		According Standard	Contractor	Suitable Device According Standard
+Main Electrical Distribution-9T1	1		According Standard	Contractor	Suitable Device According Standard
+Main Electrical Distribution-9T2	1		According Standard	Contractor	Suitable Device According Standard
+Main Electrical Distribution-9T3	1		According Standard	Contractor	Suitable Device According Standard
+Main Electrical Distribution-10T1	1	Employer Supply	Employer Supply	-	Employer Supply
+Main Electrical Distribution-10T2	1	Isolated Transformer 400/230V-5A	Isolated Transformer 400/230V-5A	Contractor	Isolated Transformer 400/230V-5A
+Main Electrical Distribution-11T1	1	Mean Well Power Supply NDR-240-24	Mean Well Power Supply NDR-240-24	Contractor	Mean Well Power Supply NDR-240-24/24V-10A/230V
+Main Electrical Distribution-15TS1	1		According Standard	Contractor	Suitable Device According Standard
+Main Electrical Distribution-9V1	1		According Standard	Contractor	Suitable Device According Standard
+Modbus Network-OP1	1	Employer Supply	Employer Supply	-	Employer Supply
+Modbus Network-OP1-D1	1	Employer Supply	Employer Supply	-	Employer Supply
+Modbus Network-OP1-D2	1	Employer Supply	Employer Supply	-	Employer Supply
+Modbus Network-OP2	1	Employer Supply	Employer Supply	-	Employer Supply
+Modbus Network-OP2-D3	1	Employer Supply	Employer Supply	-	Employer Supply
+Modbus Network-OP2-D4	1	Employer Supply	Employer Supply	-	Employer Supply
+Modbus Network-OP2-D5	1	Employer Supply	Employer Supply	-	Employer Supply
+Modbus Network-OP2-D6	1	Employer Supply	Employer Supply	-	Employer Supply
+Modbus Network-OP2-D7	1	Employer Supply	Employer Supply	-	Employer Supply
+Modbus Network-OP3	1	Employer Supply	Employer Supply	-	Employer Supply
+Modbus Network-OP3-D8	1	Employer Supply	Employer Supply	-	Employer Supply
+Modbus Network-OP3-ENC1	1	Employer Supply	Employer Supply	-	Employer Supply
+Modbus Network-OP4	1	Employer Supply	Employer Supply	-	Employer Supply
+Modbus Network-OP4-D9	1	Employer Supply	Employer Supply	-	Employer Supply
+Modbus Network-OP4-D10	1	Employer Supply	Employer Supply	-	Employer Supply
+Modbus Network-OP4-R1	1	Employer Supply	Employer Supply	-	Employer Supply
+PLC Digital Inputs-25B1	1	Employer Supply	Employer Supply	-	Employer Supply
+PLC Digital Outputs-37Q3	1	FINDER RELAY 40.51.9.024.0000 With 95.05 Socket	Finder : 40.51.9.024.0000	Contractor	Coil : 24 V 1NO/1NC
+PLC Digital Outputs-37Q4	1	FINDER RELAY 40.51.9.024.0000 With 95.05 Socket	Finder : 40.51.9.024.0000	Contractor	Coil : 24 V 1NO/1NC
+PLC Digital Outputs-37Q5	1	FINDER RELAY 40.51.9.024.0000 With 95.05 Socket	Finder : 40.51.9.024.0000	Contractor	Coil : 24 V 1NO/1NC
+PLC Digital Outputs-37Q6	1	FINDER RELAY 40.51.9.024.0000 With 95.05 Socket	Finder : 40.51.9.024.0000	Contractor	Coil : 24 V 1NO/1NC

Parts list

F01_001

Device tag	Quantity	Designation	Part number	Supplier	Remark
+PLC Digital Outputs-37Q7	1	FINDER RELAY 40.51.9.024.0000 With 95.05 Socket	Finder : 40.51.9.024.0000	Contractor	Coil : 24 V 1NO/1NC
+PLC Digital Outputs-37Q8	1	FINDER RELAY 40.51.9.024.0000 With 95.05 Socket	Finder : 40.51.9.024.0000	Contractor	Coil : 24 V 1NO/1NC
+PLC Digital Outputs-38Q1	1	FINDER RELAY 40.51.9.024.0000 With 95.05 Socket	Finder : 40.51.9.024.0000	Contractor	Coil : 24 V 1NO/1NC
+PLC Digital Outputs-38Q2	1	FINDER RELAY 40.51.9.024.0000 With 95.05 Socket	Finder : 40.51.9.024.0000	Contractor	Coil : 24 V 1NO/1NC
+PLC Digital Outputs-38Q3	1	FINDER RELAY 40.51.9.024.0000 With 95.05 Socket	Finder : 40.51.9.024.0000	Contractor	Coil : 24 V 1NO/1NC
+PLC Digital Outputs-38Q4	1	FINDER RELAY 40.51.9.024.0000 With 95.05 Socket	Finder : 40.51.9.024.0000	Contractor	Coil : 24 V 1NO/1NC
+PLC Digital Outputs-38Q5	1	FINDER RELAY 40.51.9.024.0000 With 95.05 Socket	Finder : 40.51.9.024.0000	Contractor	Coil : 24 V 1NO/1NC
+PLC Digital Outputs-39Q1	1	FINDER RELAY 40.51.9.024.0000 With 95.05 Socket	Finder : 40.51.9.024.0000	Contractor	Coil : 24 V 1NO/1NC
+PLC Digital Outputs-39Q2	1	FINDER RELAY 40.51.9.024.0000 With 95.05 Socket	Finder : 40.51.9.024.0000	Contractor	Coil : 24 V 1NO/1NC
+PLC Digital Outputs-42Q4	1	FINDER RELAY 40.51.9.024.0000 With 95.05 Socket	Finder : 40.51.9.024.0000	Contractor	Coil : 24 V 1NO/1NC
+PLC Digital Outputs-42Q5	1	FINDER RELAY 40.51.9.024.0000 With 95.05 Socket	Finder : 40.51.9.024.0000	Contractor	Coil : 24 V 1NO/1NC
+PLC Digital Outputs-42Q6	1	FINDER RELAY 40.51.9.024.0000 With 95.05 Socket	Finder : 40.51.9.024.0000	Contractor	Coil : 24 V 1NO/1NC
+PLC Digital Outputs-42Q7	1	FINDER RELAY 40.51.9.024.0000 With 95.05 Socket	Finder : 40.51.9.024.0000	Contractor	Coil : 24 V 1NO/1NC
+PLC Digital Outputs-42Q8	1	FINDER RELAY 40.51.9.024.0000 With 95.05 Socket	Finder : 40.51.9.024.0000	Contractor	Coil : 24 V 1NO/1NC
+PLC Analog Inputs-OP3-R11	1	Employer Supply	Employer Supply	-	Employer Supply
+PLC Analog Inputs-OP3-R12	1	Employer Supply	Employer Supply	-	Employer Supply
+PLC Analog Inputs-OP3-TCO1	1	Employer Supply	Employer Supply	-	Employer Supply
+Motor Drives-47A1	1	Employer Supply	Employer Supply	-	Employer Supply
+Motor Drives-48A1	1	Employer Supply	Employer Supply	-	Employer Supply
+Motor Drives-48A2	1	Employer Supply	Employer Supply	-	Employer Supply
+Motor Drives-49A1	1	Employer Supply	Employer Supply	-	Employer Supply
+Motor Drives-50A1	1	Employer Supply	Employer Supply	-	Employer Supply
+Motor Drives-51A1	1	Employer Supply	Employer Supply	-	Employer Supply
+Motor Drives-52A1	1	Employer Supply	Employer Supply	-	Employer Supply
+Motor Drives-53A1	1	Employer Supply	Employer Supply	-	Employer Supply
+Motor Drives-52B1	1	Employer Supply	Employer Supply	-	Employer Supply
+Motor Drives-47F1	1	Pichaz IDS-251 With Fuse	Pichaz IDS-251	Contractor	Pichaz IDS-251 With Fuse
Parts list

F01_001

Device tag	Quantity	Designation	Part number	Supplier	Remark
+Motor Drives-51F1	1	HRC Fuse With Fuse Holder	HRC Fuse With Fuse Holder	Contractor	HRC Fuse With Fuse Holder
+Motor Drives-51F2	1	Pichaz IDS-251 With Fuse	Pichaz IDS-251	Contractor	Pichaz IDS-251 With Fuse
+Motor Drives-51F3	1	Schnieder MCB C4	Schnieder MCB C4	Contractor	Schnieder 1-Pole MCB C4
+Motor Drives-52F1	1	Pichaz IDS-251 With Fuse	Pichaz IDS-251	Contractor	Pichaz IDS-251 With Fuse
+Motor Drives-52F2	1	HRC Fuse With Fuse Holder	HRC Fuse With Fuse Holder	Contractor	HRC Fuse With Fuse Holder
+Motor Drives-52F3	1	Schnieder 3-Pole MCB C10	Schnieder 3-Pole MCB C10	Contractor	Schnieder 3-Pole MCB C10
+Motor Drives-52F4	1	Schnieder MCB C4	Schnieder MCB C4	Contractor	Schnieder 1-Pole MCB C4
+Motor Drives-53F1	1	Pichaz IDS-251 With Fuse	Pichaz IDS-251	Contractor	Pichaz IDS-251 With Fuse
+Motor Drives-47G1	1	Employer Supply	Employer Supply	-	Employer Supply
+Motor Drives-49G1	1	Employer Supply	Employer Supply	-	Employer Supply
+Motor Drives-51G1	1	Employer Supply	Employer Supply	-	Employer Supply
+Motor Drives-52G1	1	Employer Supply	Employer Supply	-	Employer Supply
+Motor Drives-HMI-OP-R3	1		1kohm - Potentiometer	Contractor	1kohm - Potentiometer
+Motor Drives-47M1	1	Employer Supply	Employer Supply	-	Employer Supply
+Motor Drives-49M1	1	Employer Supply	Employer Supply	-	Employer Supply
+Motor Drives-51M1	1	Employer Supply	Employer Supply	-	Employer Supply
+Motor Drives-52M1	1	Employer Supply	Employer Supply	-	Employer Supply
+Motor Drives-53M1	1	Employer Supply	Employer Supply	-	Employer Supply
+Motor Drives-51Q1	1	FINDER RELAY 40.51.9.024.0000 With 95.05 Socket	Finder : 40.51.9.024.0000	Contractor	Coil : 24 V 1NO/1NC
+Motor Drives-51Q2	1	FINDER RELAY 40.51.9.024.0000 With 95.05 Socket	Finder : 40.51.9.024.0000	Contractor	Coil : 24 V 1NO/1NC
+Motor Drives-47R1	1	Employer Supply	Employer Supply	-	Employer Supply
+Motor Drives-47R2	1	Employer Supply	Employer Supply	-	Employer Supply
+Motor Drives-47R3	1	Employer Supply	Employer Supply	-	Employer Supply
+Motor Drives-47R4	1	Employer Supply	Employer Supply	-	Employer Supply
+Motor Drives-47R5	1	Employer Supply	Employer Supply	-	Employer Supply
+Motor Drives-49R1	1	Employer Supply	Employer Supply	-	Employer Supply
+Motor Drives-49R2	1	Employer Supply	Employer Supply	-	Employer Supply
+Motor Drives-49R3	1	Employer Supply	Employer Supply	-	Employer Supply
+Motor Drives-49R4	1	Employer Supply	Employer Supply	-	Employer Supply
+Motor Drives-50R1	1		1kohm - Potentiometer	Contractor	
+Motor Drives-50R2	1		1kohm - Potentiometer	Contractor	
+Motor Drives-51R1	1	Employer Supply	Employer Supply	-	Employer Supply
+Motor Drives-51R2	1	Employer Supply	Employer Supply	-	Employer Supply
+Motor Drives-51R3	1	Employer Supply	Employer Supply	-	Employer Supply
+Motor Drives-52R1	1	Employer Supply	Employer Supply	-	Employer Supply
+Motor Drives-52R2	1	Employer Supply	Employer Supply	-	Employer Supply
+Motor Drives-52R3	1	Employer Supply	Employer Supply	-	Employer Supply
+Motor Drives-52R4	1	Employer Supply	Employer Supply	-	Employer Supply
+Feilds Wiring Diagram-54F1	1	Schneider MPCB GV2ME05	Schneider MPCB GV2ME05	Contractor	Schneider MPCB GV2ME05/0.63A-1A
+Feilds Wiring Diagram-54F2	1	Schnieder MCB C4	Schnieder MCB C4	Contractor	Schnieder 1-Pole MCB C4
+Feilds Wiring Diagram-55F1	1	Schneider MPCB GV2ME06	Schneider MPCB GV2ME06	Contractor	Schneider MPCB GV2ME06/1A-1.6A
+Feilds Wiring Diagram-55F2	1	Schnieder MCB C4	Schnieder MCB C4	Contractor	Schnieder 1-Pole MCB C4
+Feilds Wiring Diagram-56F1	1	Schnieder MCB C10	Schnieder MCB C10	Contractor	Schnieder 1-Pole MCB C10
+Feilds Wiring Diagram-58F1	1	Schneider MPCB GV2ME07	Schneider MPCB GV2ME07	Contractor	Schneider MPCB GV2ME07/1.6A-2.5A
+Feilds Wiring Diagram-58F2	1	Schnieder MCB C4	Schnieder MCB C4	Contractor	Schnieder 1-Pole MCB C4
+Feilds Wiring Diagram-59F1	1	Schneider MPCB GV2ME05	Schneider MPCB GV2ME05	Contractor	Schneider MPCB GV2ME05/0.63A-1A
+Feilds Wiring Diagram-59F2	1	Schnieder MCB C4	Schnieder MCB C4	Contractor	Schnieder 1-Pole MCB C4
+Feilds Wiring Diagram-60F1	1	Schneider MPCB GV2ME05	Schneider MPCB GV2ME05	Contractor	Schneider MPCB GV2ME05/0.63A-1A
+Feilds Wiring Diagram-60F2	1	Schnieder MCB C4	Schnieder MCB C4	Contractor	Schnieder 1-Pole MCB C4
+Feilds Wiring Diagram-61F1	1	Schneider MPCB GV2ME05	Schneider MPCB GV2ME05	Contractor	Schneider MPCB GV2ME05/0.63A-1A
+Feilds Wiring Diagram-61F2	1	Schnieder MCB C4	Schnieder MCB C4	Contractor	Schnieder 1-Pole MCB C4
+Feilds Wiring Diagram-63F1	1	Schneider MPCB GV2ME05	Schneider MPCB GV2ME05	Contractor	Schneider MPCB GV2ME05/0.63A-1A
+Feilds Wiring Diagram-63F2	1	Schnieder MCB C4	Schnieder MCB C4	Contractor	Schnieder 1-Pole MCB C4
+Feilds Wiring Diagram-64F1	1	Schneider MPCB GV2ME05	Schneider MPCB GV2ME05	Contractor	Schneider MPCB GV2ME05/0.63A-1A
+Feilds Wiring Diagram-64F2	1	Schnieder MCB C4	Schnieder MCB C4	Contractor	Schnieder 1-Pole MCB C4
+Feilds Wiring Diagram-65F1	1	Schneider MPCB GV2ME07	Schneider MPCB GV2ME07	Contractor	Schneider MPCB GV2ME07/1.6A-2.5A

Parts list

F01_001

Device tag	Quantity	Designation	Part number	Supplier	Remark
+Feilds Wiring Diagram-65F2	1	Schneider MPCB GV2ME07	Schneider MPCB GV2ME07	Contractor	Schneider MPCB GV2ME07/1.6A-2.5A
+Feilds Wiring Diagram-65F3	1	Schnieder MCB C4	Schnieder MCB C4	Contractor	Schnieder 1-Pole MCB C4
+Feilds Wiring Diagram-65F4	1	Schnieder MCB C4	Schnieder MCB C4	Contractor	Schnieder 1-Pole MCB C4
+Feilds Wiring Diagram-66F1	1	Schnieder MCB C4	Schnieder MCB C4	Contractor	Schnieder 1-Pole MCB C4
+Feilds Wiring Diagram-66F2	1	Schnieder MCB C4	Schnieder MCB C4	Contractor	Schnieder 1-Pole MCB C4
+Feilds Wiring Diagram-66F3	1	Schnieder MCB C4	Schnieder MCB C4	Contractor	Schnieder 1-Pole MCB C4
+Feilds Wiring Diagram-66F4	1	Schnieder MCB C4	Schnieder MCB C4	Contractor	Schnieder 1-Pole MCB C4
+Feilds Wiring Diagram-67F1	1	Schneider MPCB GV3P65	Schneider MPCB GV3P65	Contractor	Schneider MPCB GV3P65/48A-65A
